
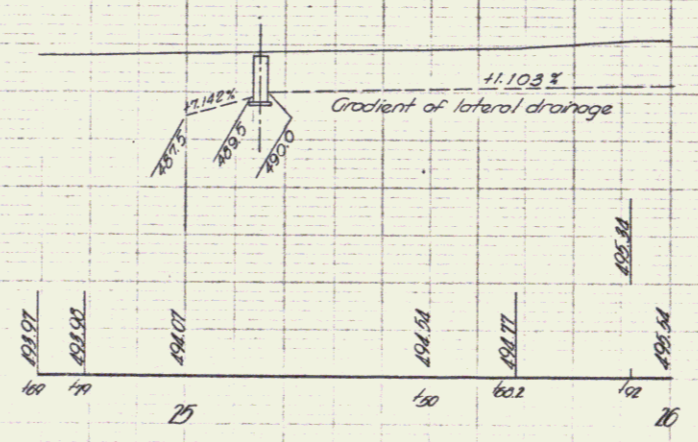
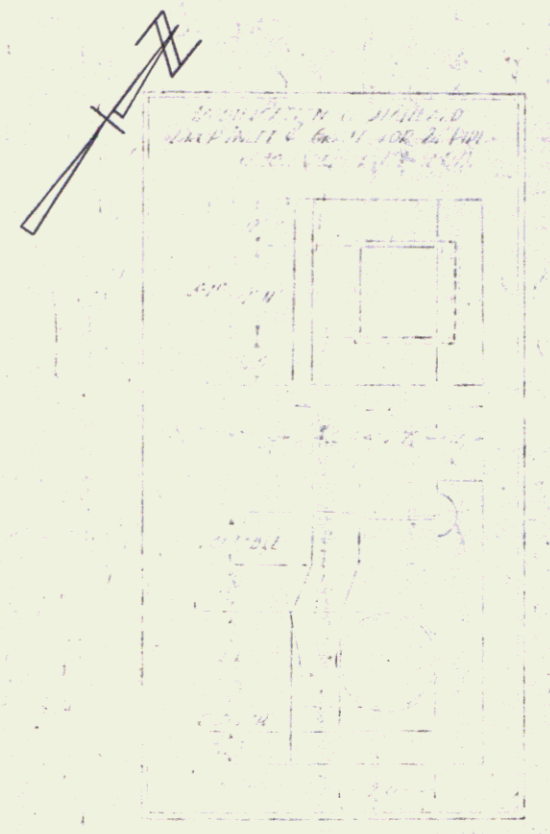


PLAN  
 1/32  
 1-48  
 RUTLAND  
 SHEET 25 OF 25 SHEETS

PROFILE  
 1/32  
 1-48  
 RUTLAND  
 SHEET 25 OF 25 SHEETS

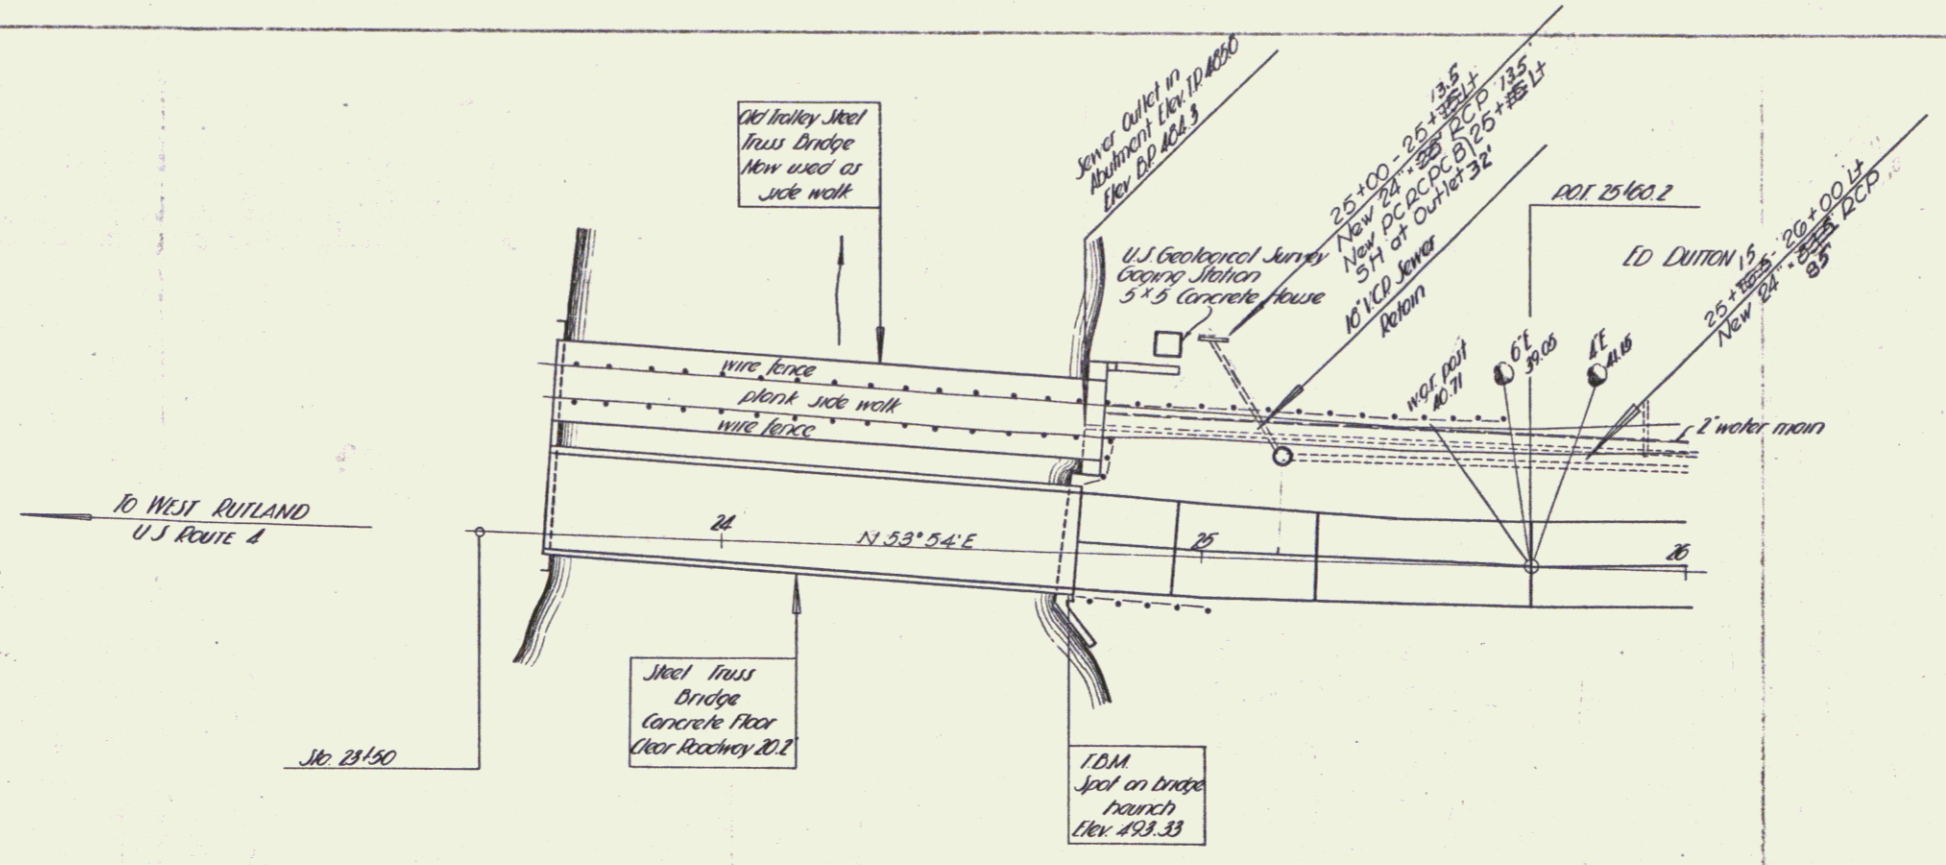

1 DM Jool on bridge baunch 9/11/21 of No 21/72 Rev. 493.33