


PLAN
 SCALE: AS SHOWN
 DATE: 10-26-29
 DRAWN BY: [Name]
 CHECKED BY: [Name]
 TITLE: [Title]

PROFILE
 SCALE: 1\"/>

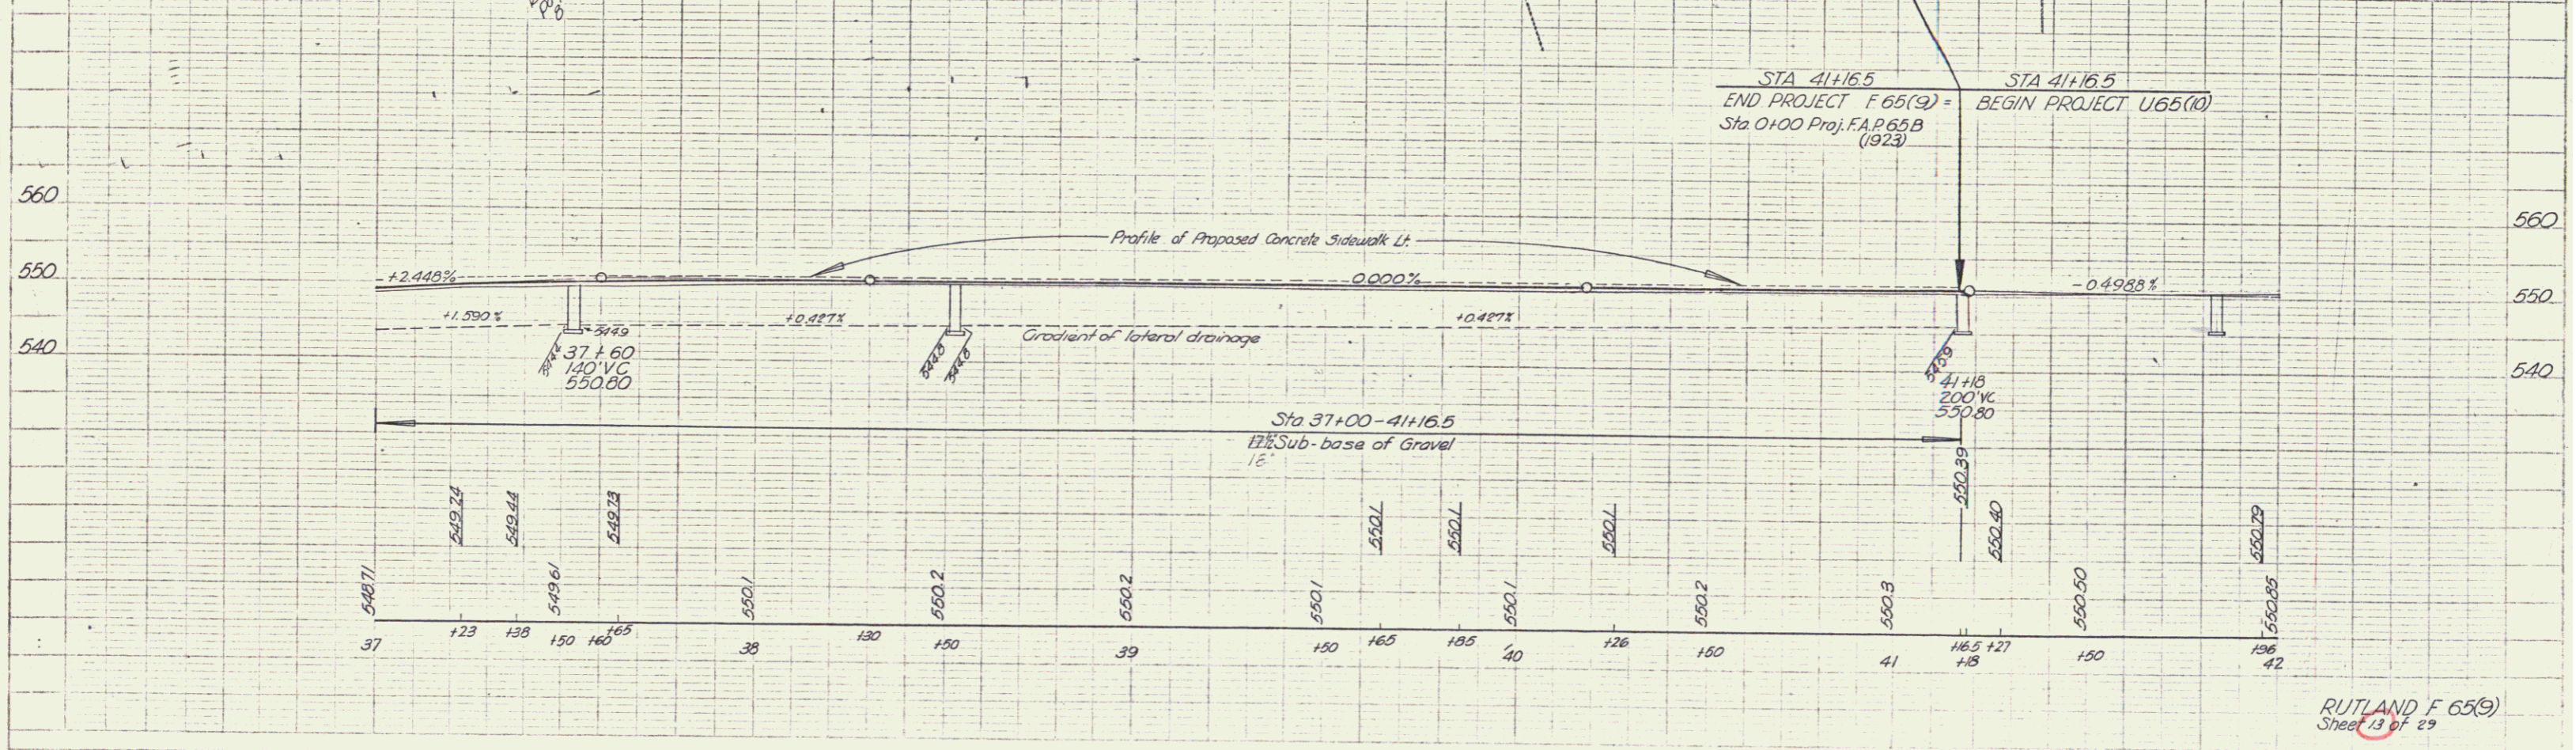

5