


PARCEL	INSTRUMENT	DATE	GRANTOR	GRANTEE	RECORDED	REMARKS
A	W-D	8-26-38	HENRY W & DELIA A TAYLOR	BOOK PAGE DATE	49 4-30-38	
X	W-D	4-26-38	FRED I SEWARD	"	45 4-30-38	
A	Q-C-D	3-26-38	ANNIE H FROST	"	41 4-30-38	
A & B	W-D	8-20-38	ADONIS B & DORA M PHILBRICK	"	47 4-30-38	
A & B	W-D	8-22-38	ALBION B & DORA M PHILBRICK	"	48 4-30-38	
C & D	W-D	8-22-38	ROBERT G HUBBARD & ANNIE H FROST	"	49 4-30-38	

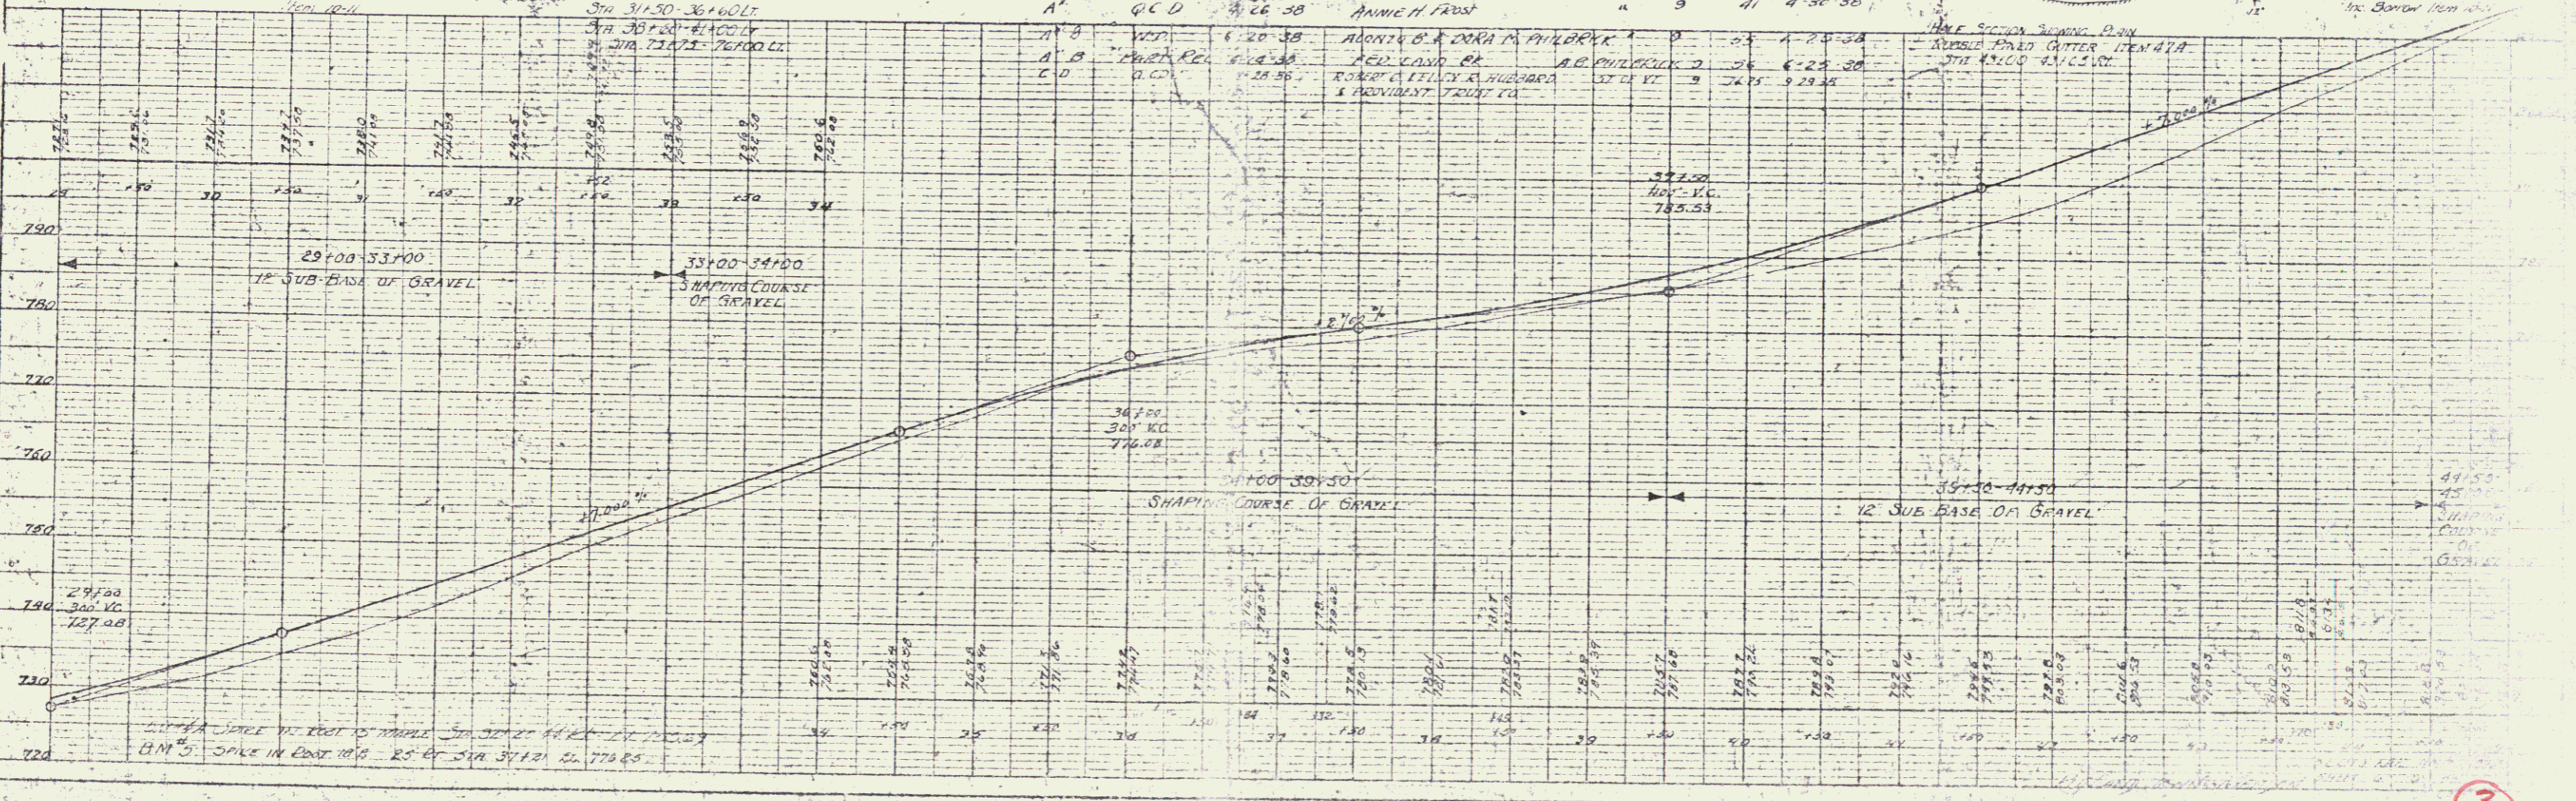

PLAN  
 1/4" = 10'  
 NOT TO SCALE  
 ALL DIMENSIONS  
 TO BE CHECKED  
 IN THE FIELD  
 BY THE CONTRACTOR

SECTION  
 1/4" = 10'  
 NOT TO SCALE  
 ALL DIMENSIONS  
 TO BE CHECKED  
 IN THE FIELD  
 BY THE CONTRACTOR

BP 020-2-1102 3  
 5