



0-40+50 Lt
 17 slope-gravel
 SODDED
 (Force Account Landscape Item)

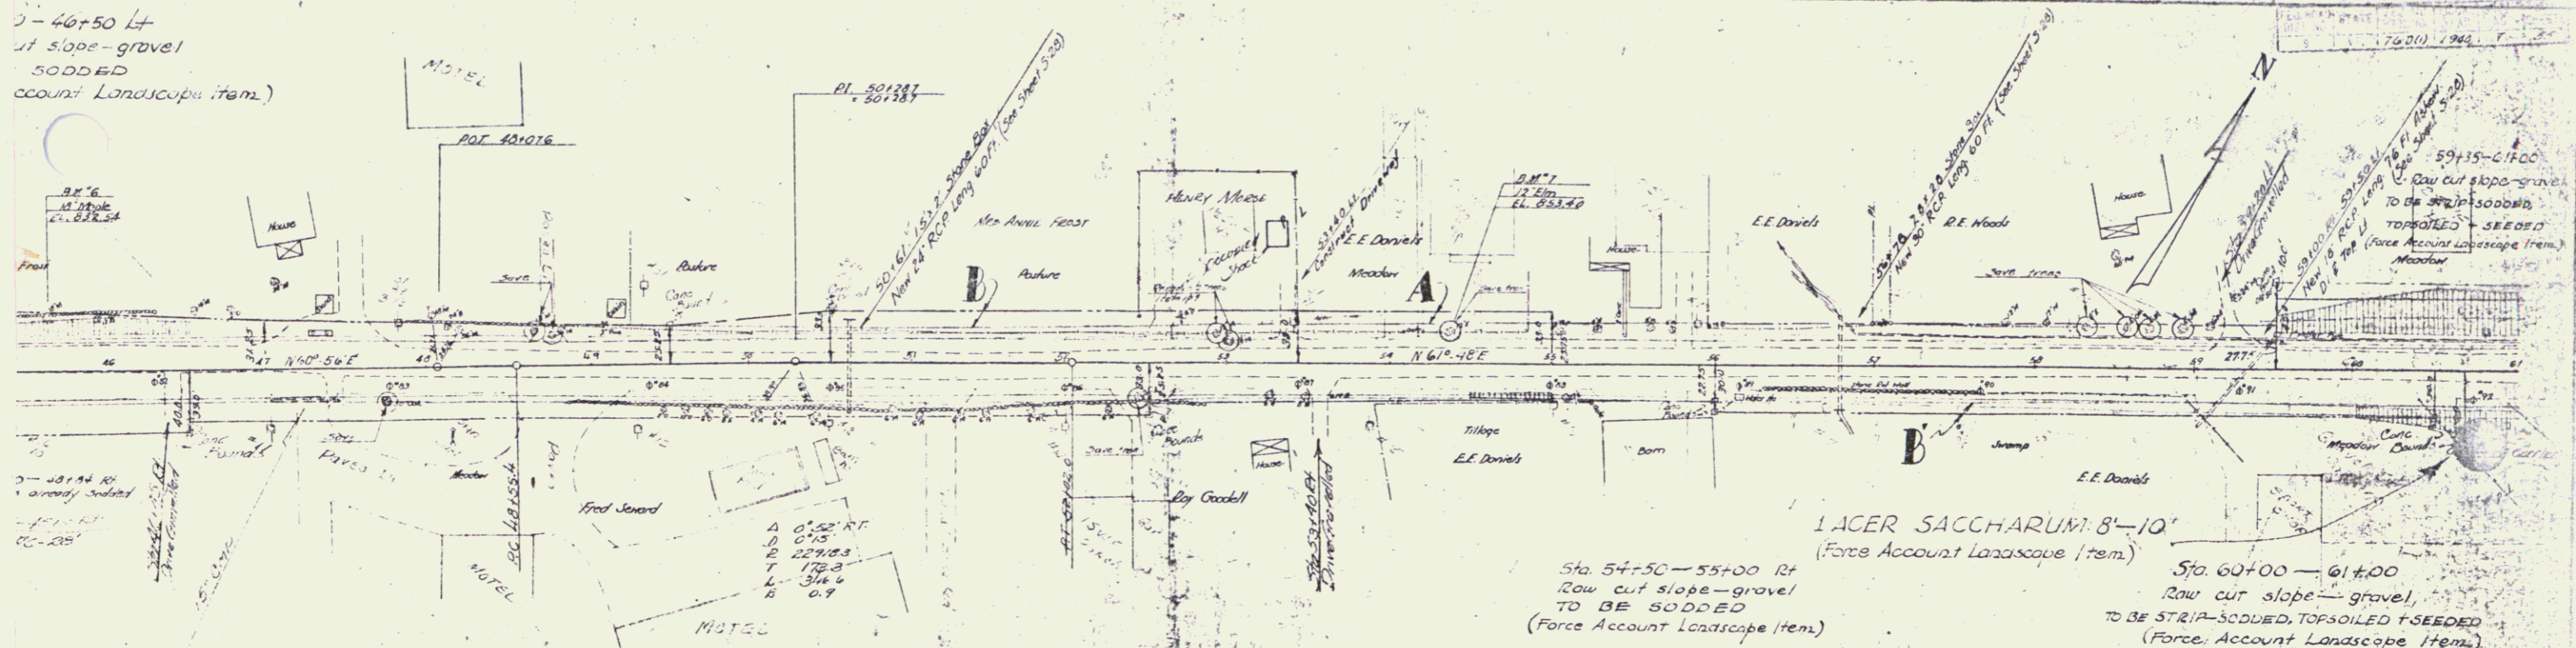

PARCEL	INSTRUMENT	DATE	GRANTOR	GRANTEE	RECORDED	REMARKS
B	G.C.D.	4-24-38	ANNIE H. FROST	ST OF VT	9 41	4-30-38
A-B	W.D.	4-26-38	E.E. DANIELS		9 46	4-30-38

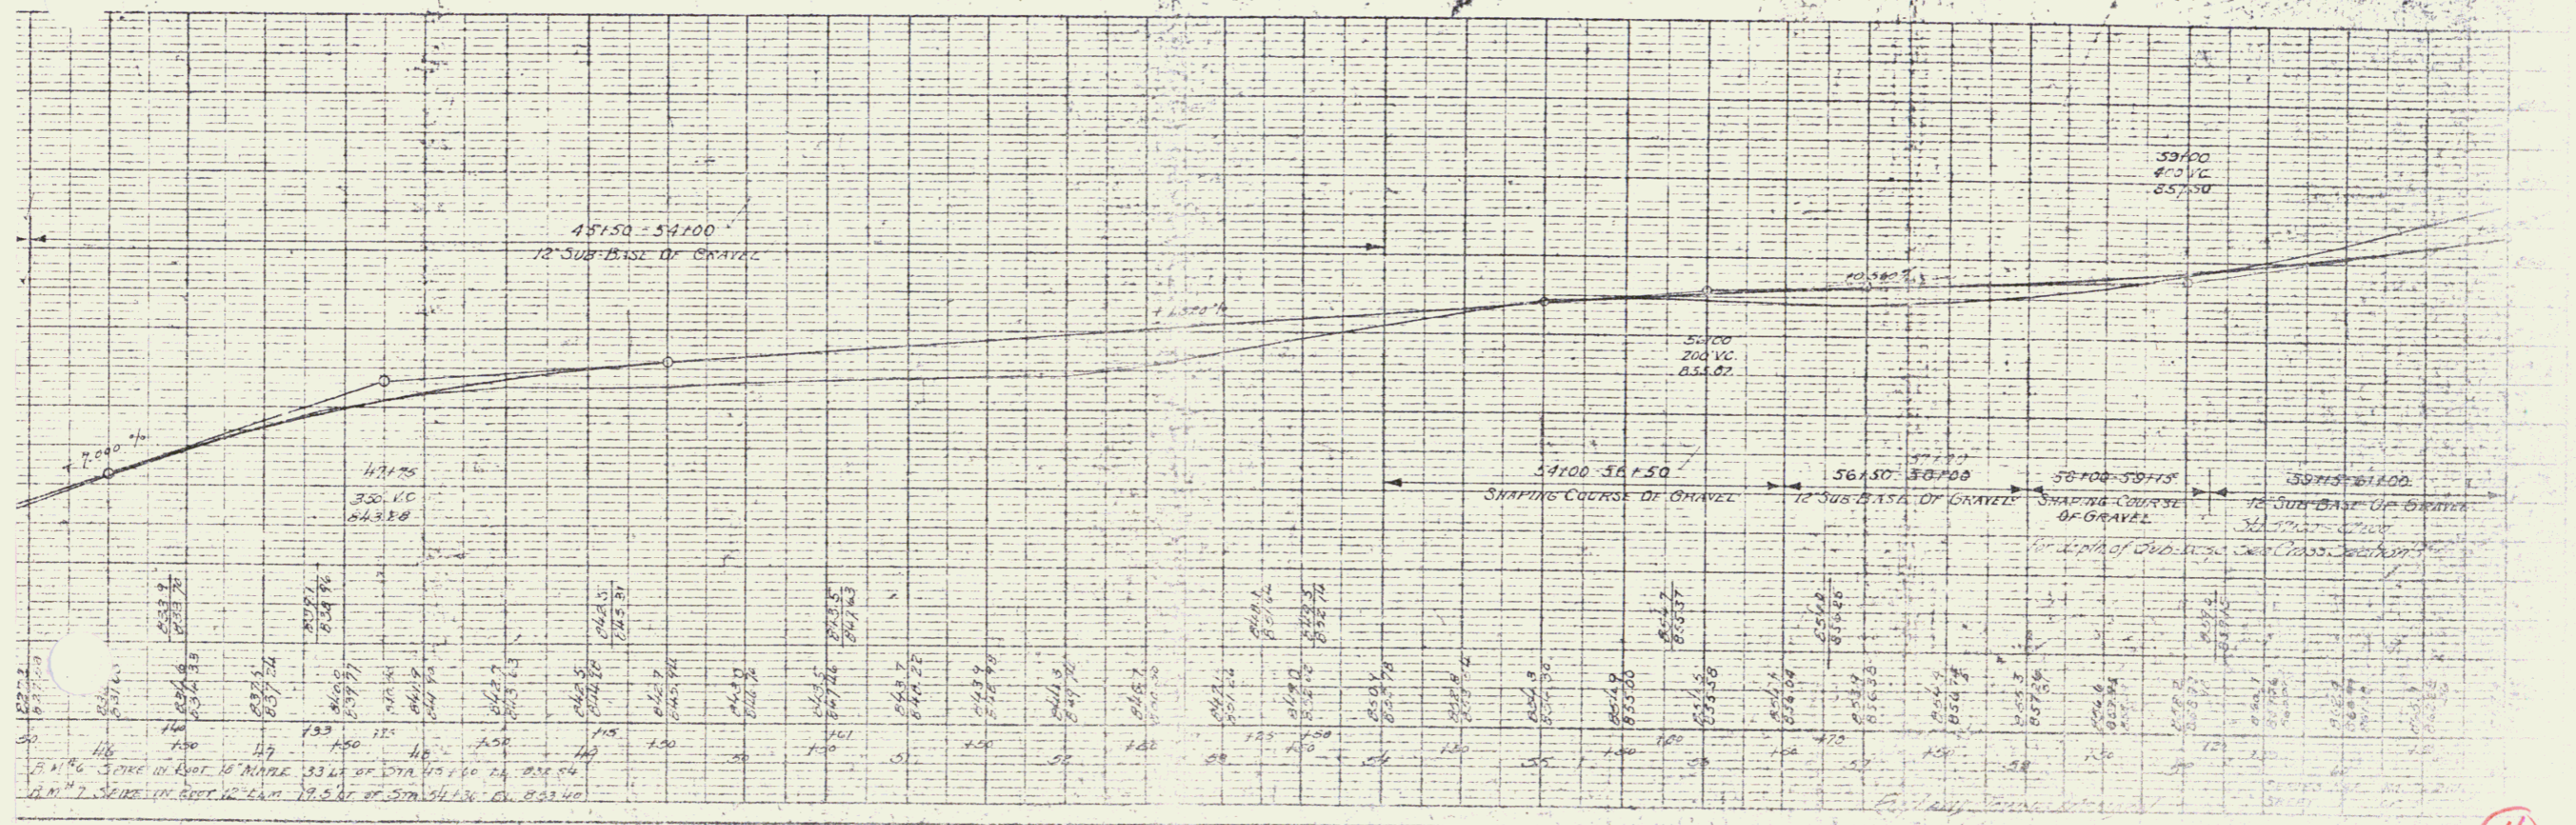

BP 020-2-7102

4
6