
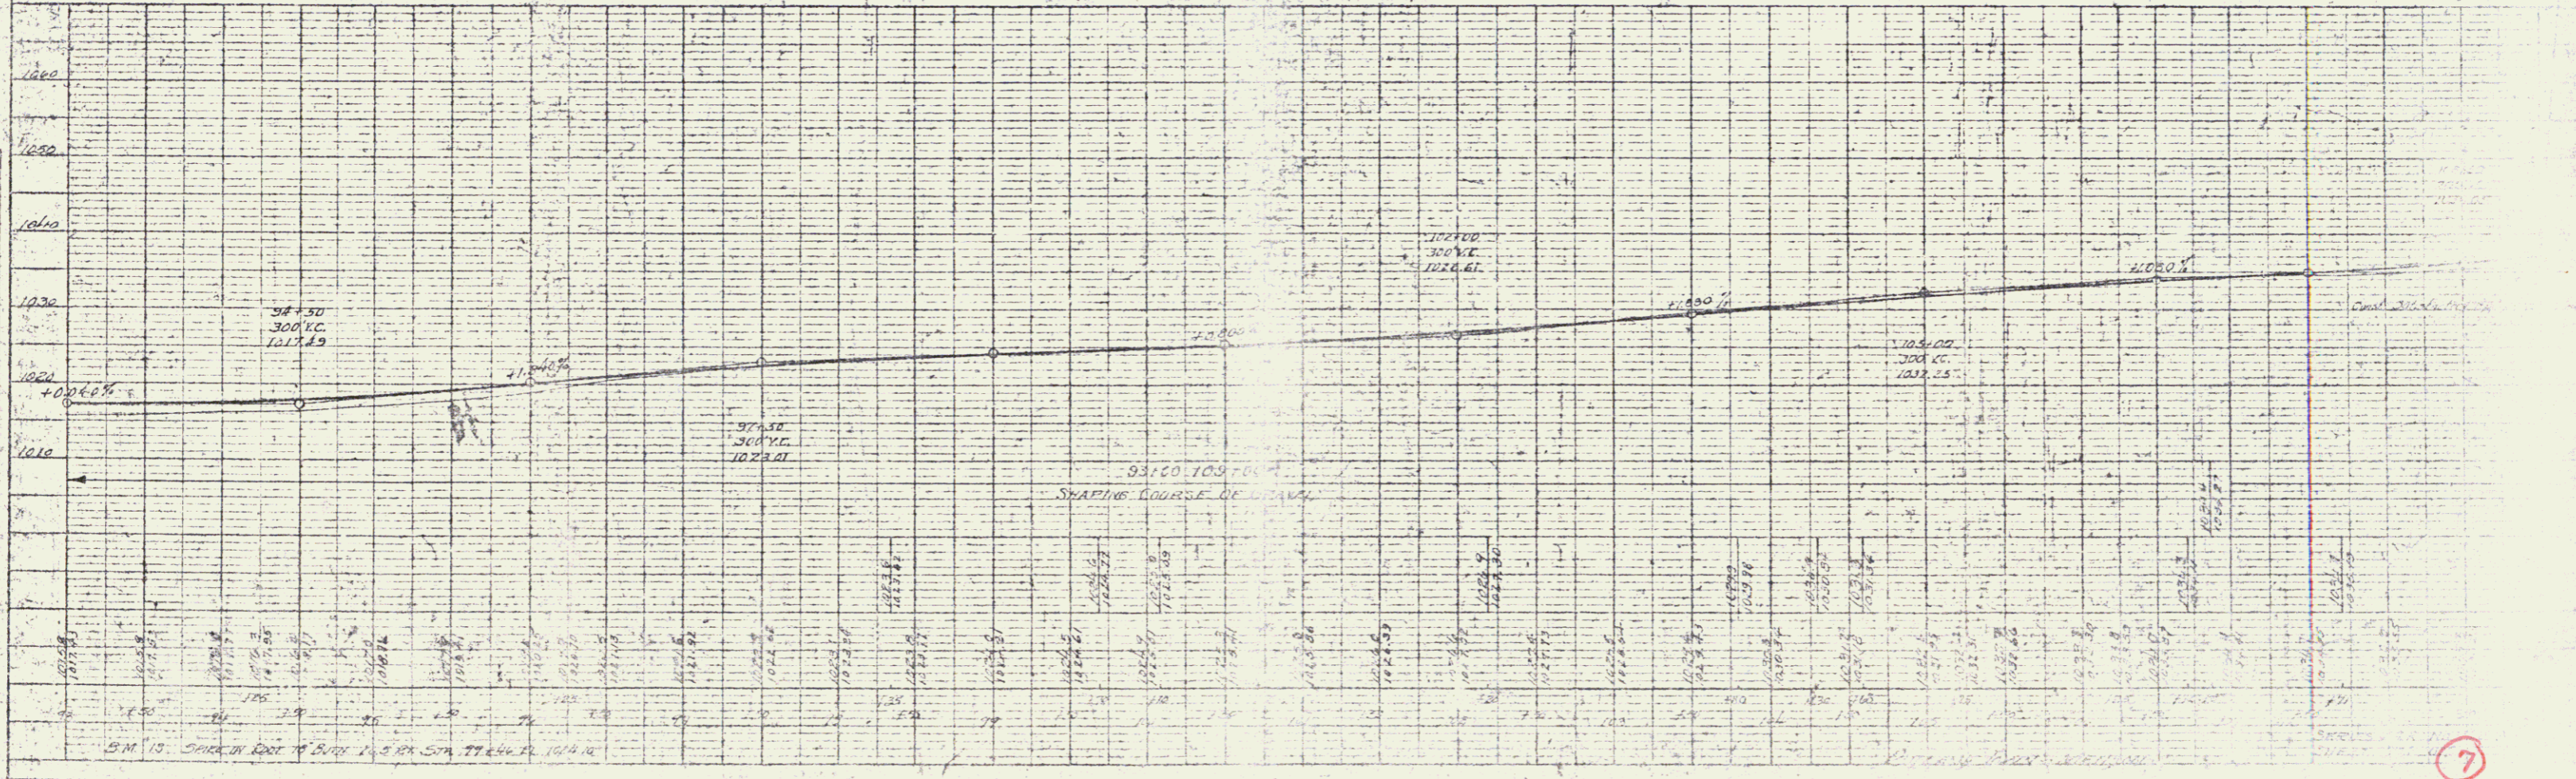


PLAN
 PROPERTY
 TITLE
 DATE
 SHEET NO.

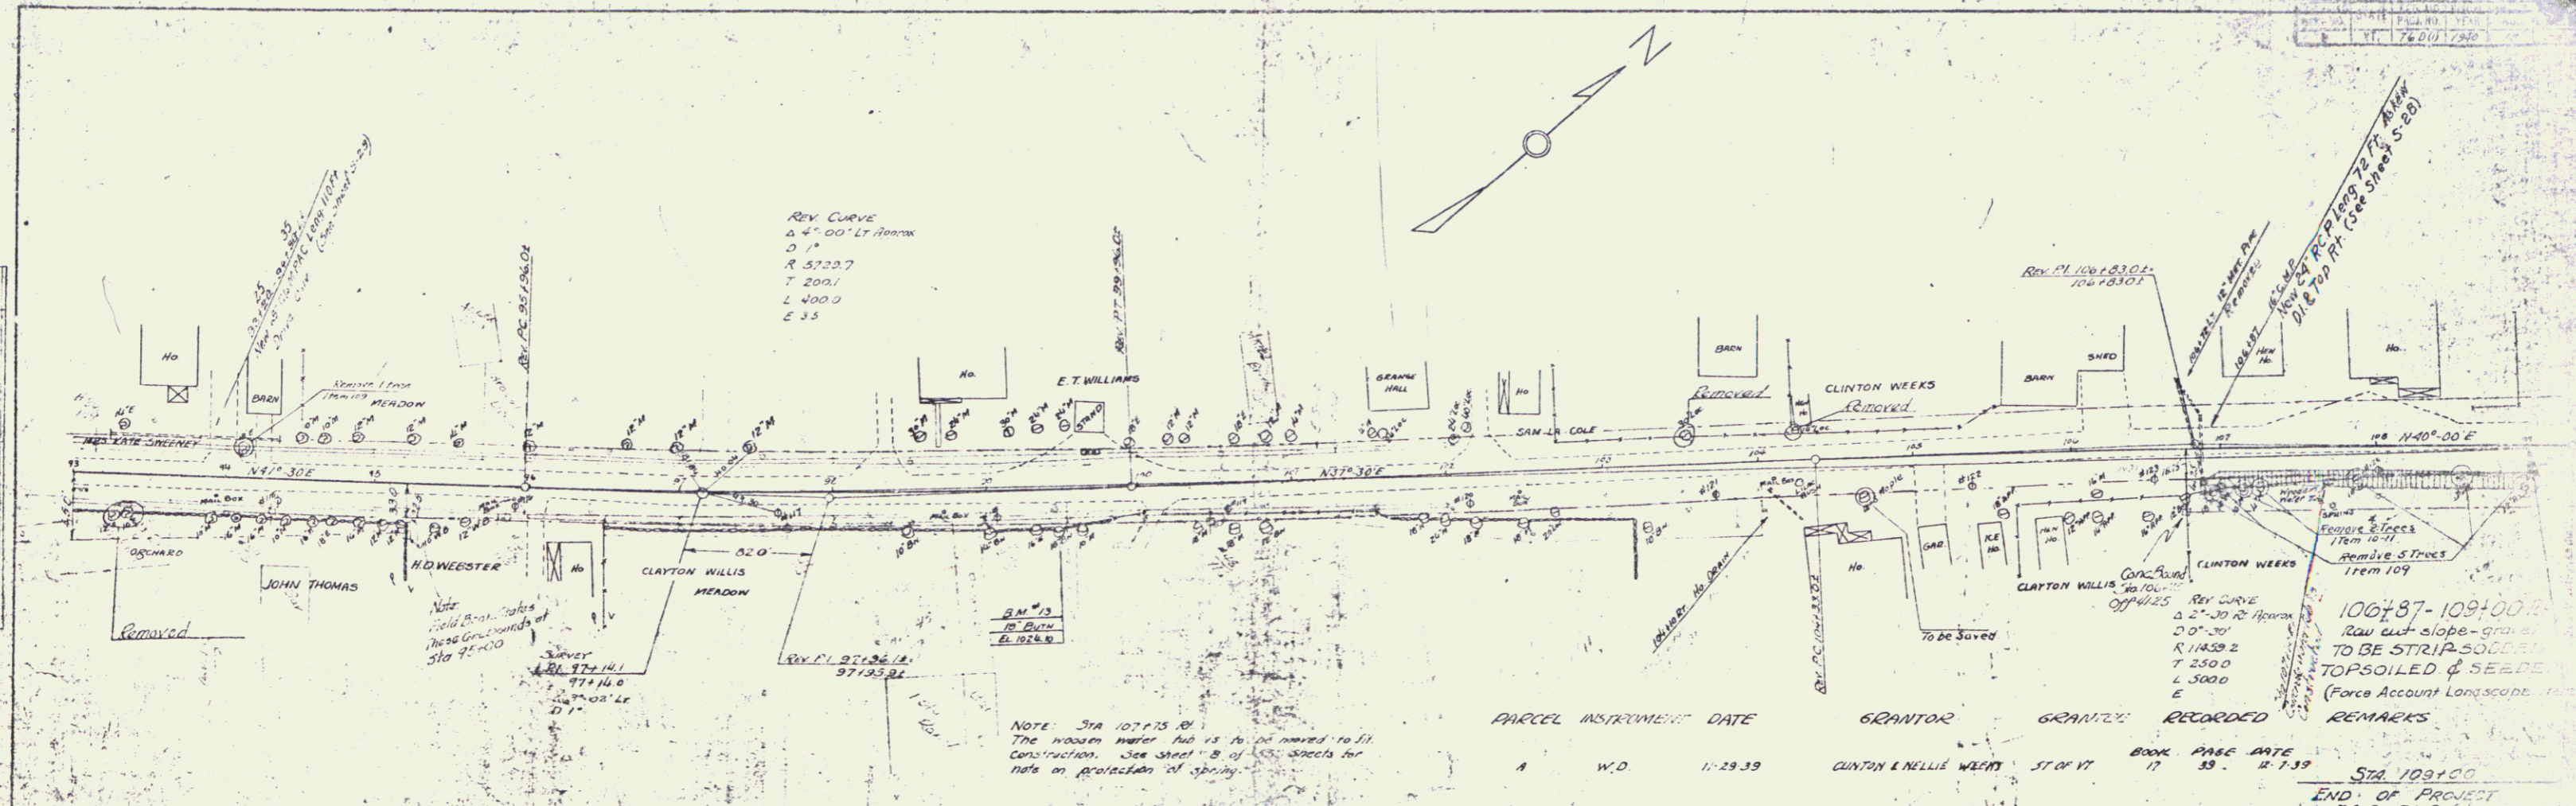

BP 020-2-7102

7