
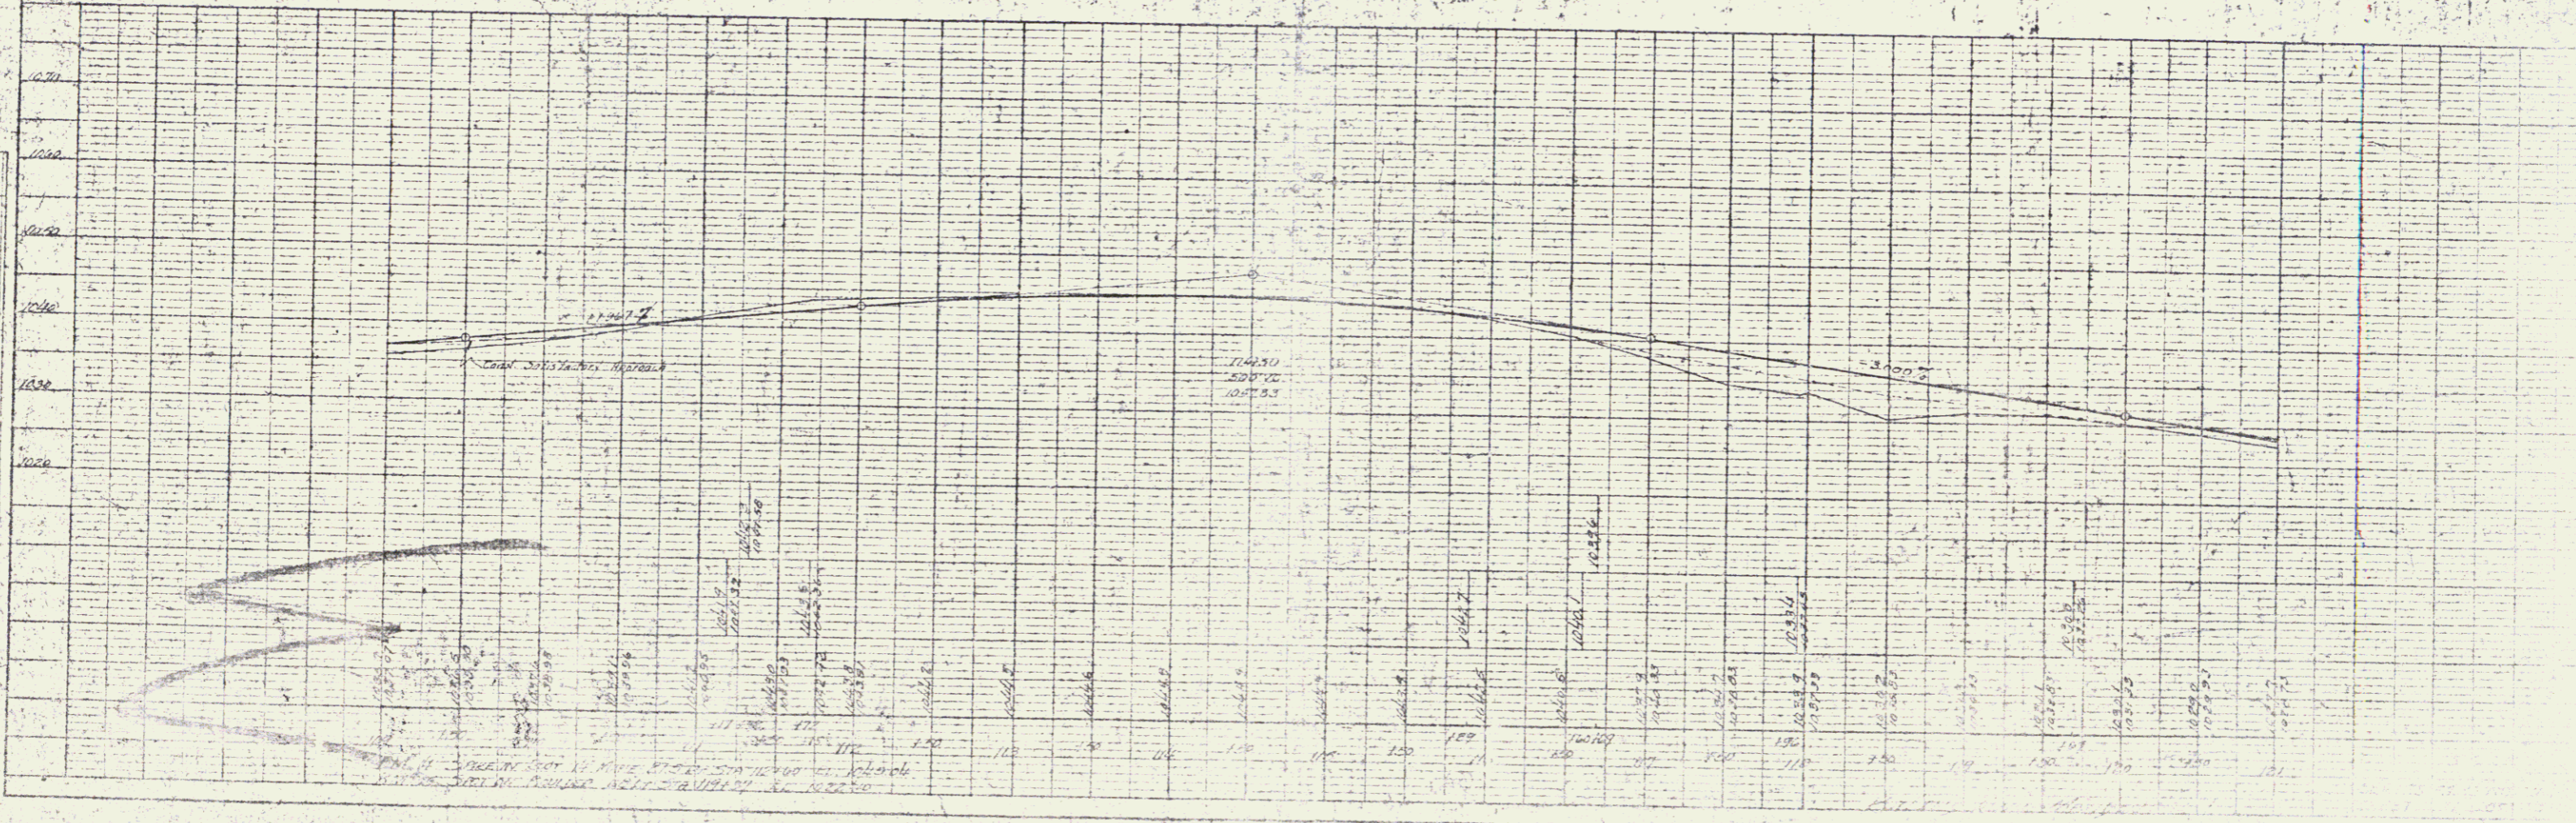
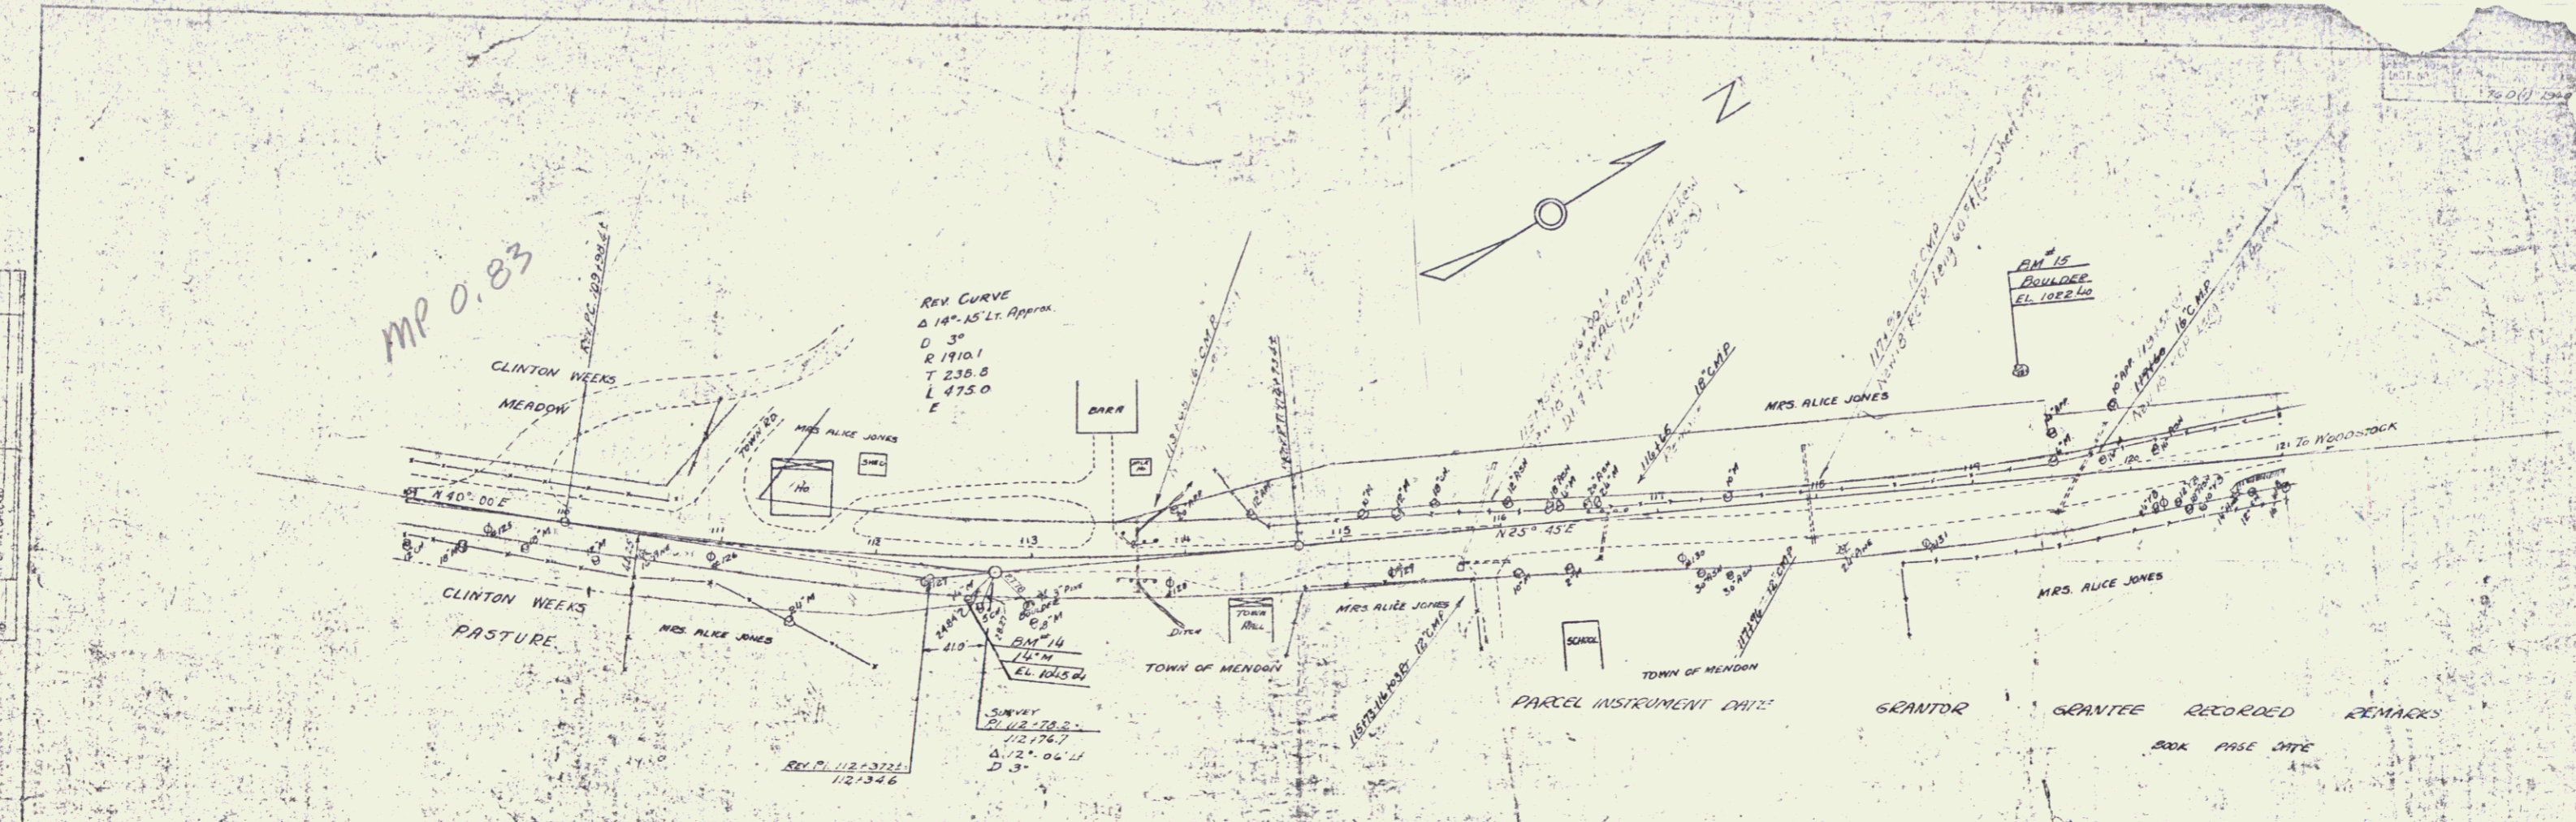


PLAN
 DATE
 BY
 CHECKED
 APPROVED

DATE
 BY
 CHECKED
 APPROVED

MP 0.83

REV CURVE
 Δ 14° 15' Lt. Approx
 D 3"
 R 1910.1
 T 230.8
 L 475.0
 E

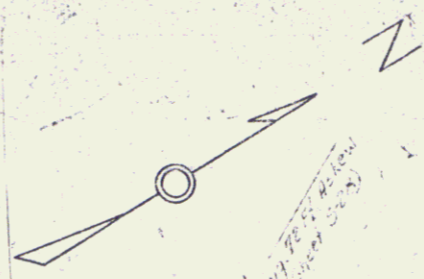

⑧