


ACQUIRED FROM CHARLES H. & FRANCES M. PRIOR BY WD. DATED MAY 14, 1938
AND RECORDED IN BK. 9 PG. 52, MAY 17, 1938 IN RUTLAND TOWN LAND RECORDS


QCD dated 9/16/81 BK 33 Pg 165
State of Vt. to Donald E. Steere +
Cecile C. O'Connor

MP 0051

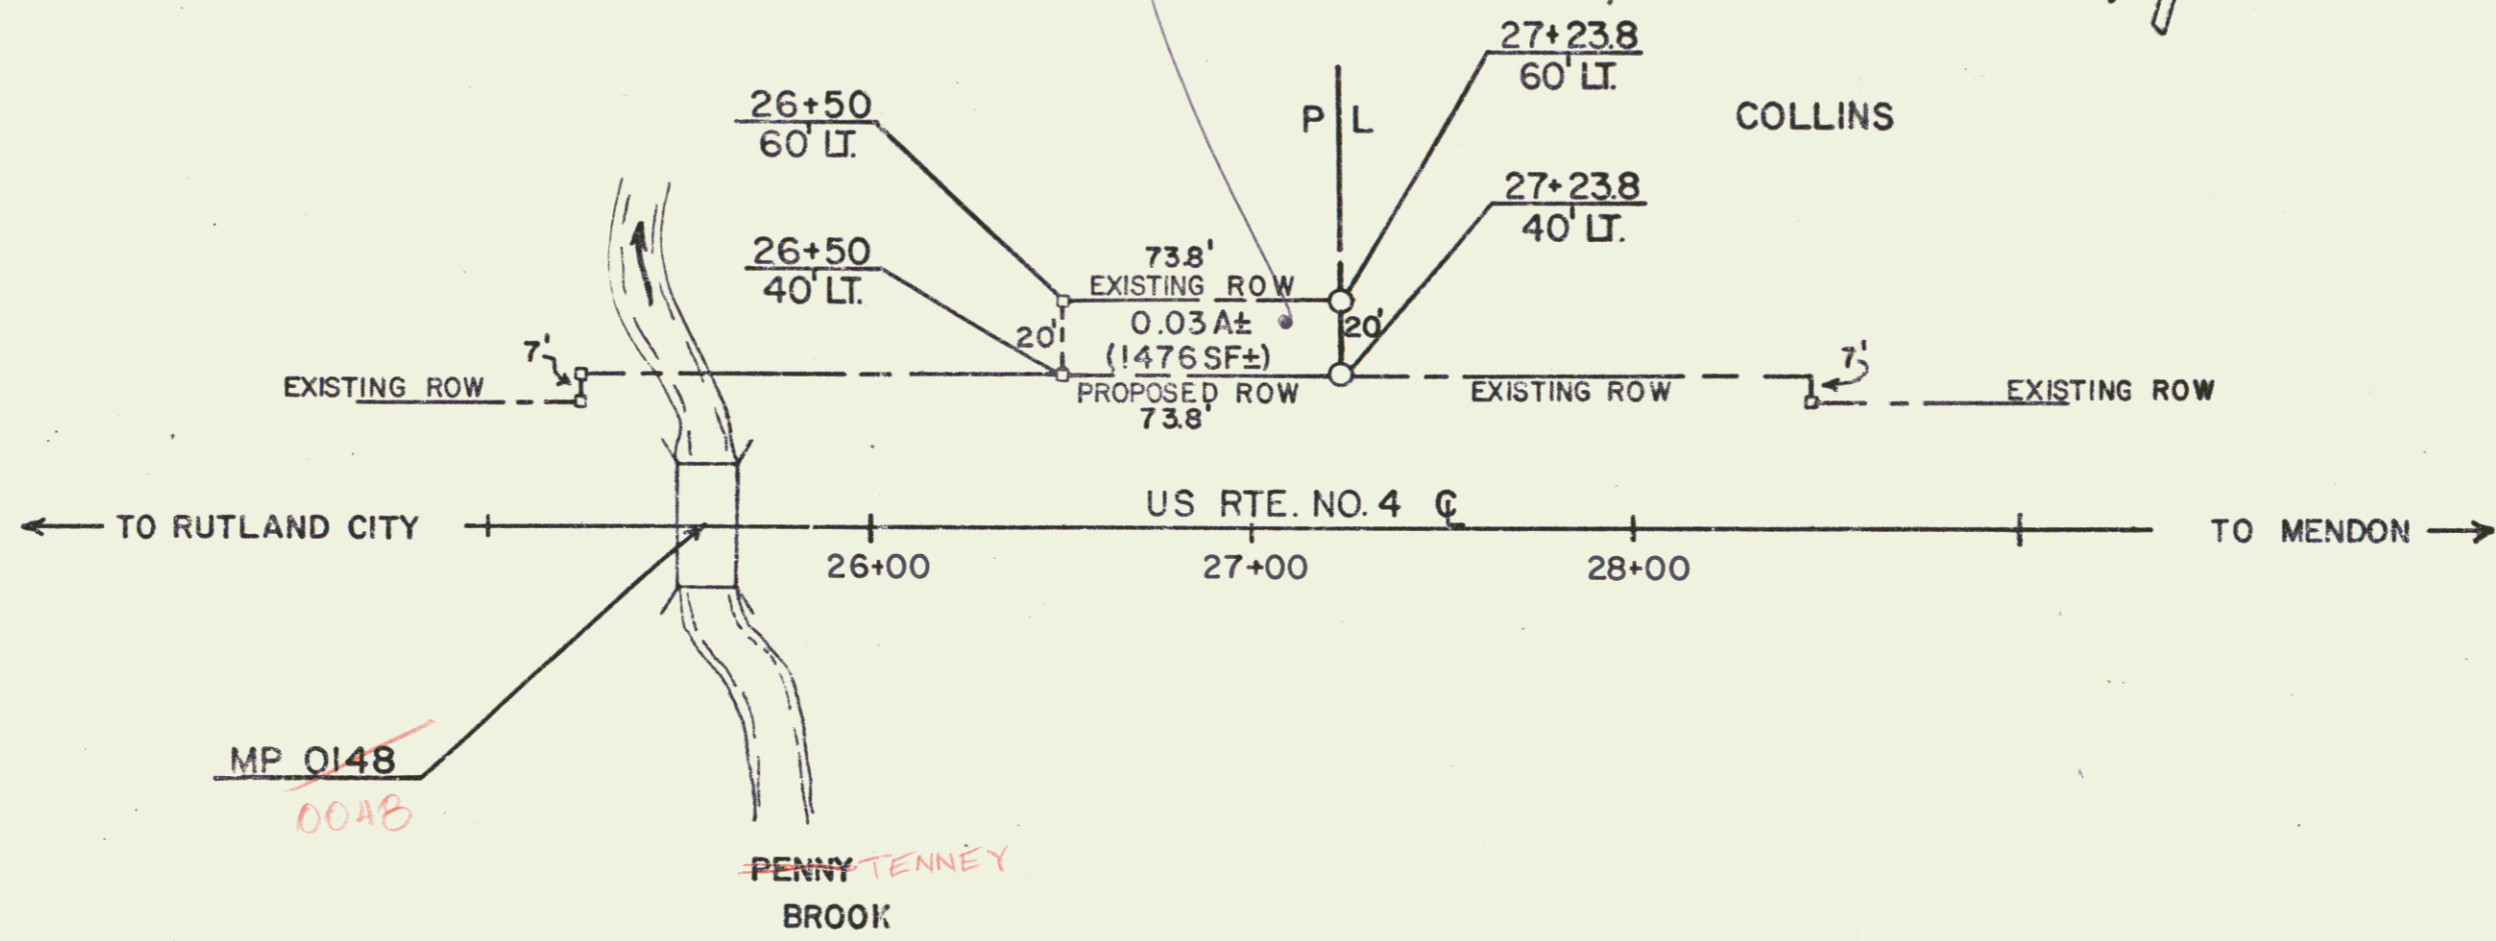

MP 0148
0048

□ - CONCRETE BOUNDS

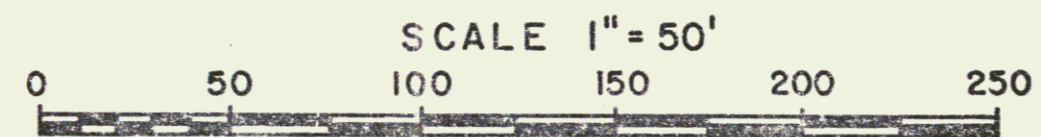

REF SHEET NO. 5		
STATE OF VERMONT AGENCY OF TRANSPORTATION		
TOWN OF RUTLAND (SA)		
RUTLAND-MENDON FAP 76D(1)		
APPROX SCALE 1" = 50'	DATE 9/1/81	DRAWN BY FJM