
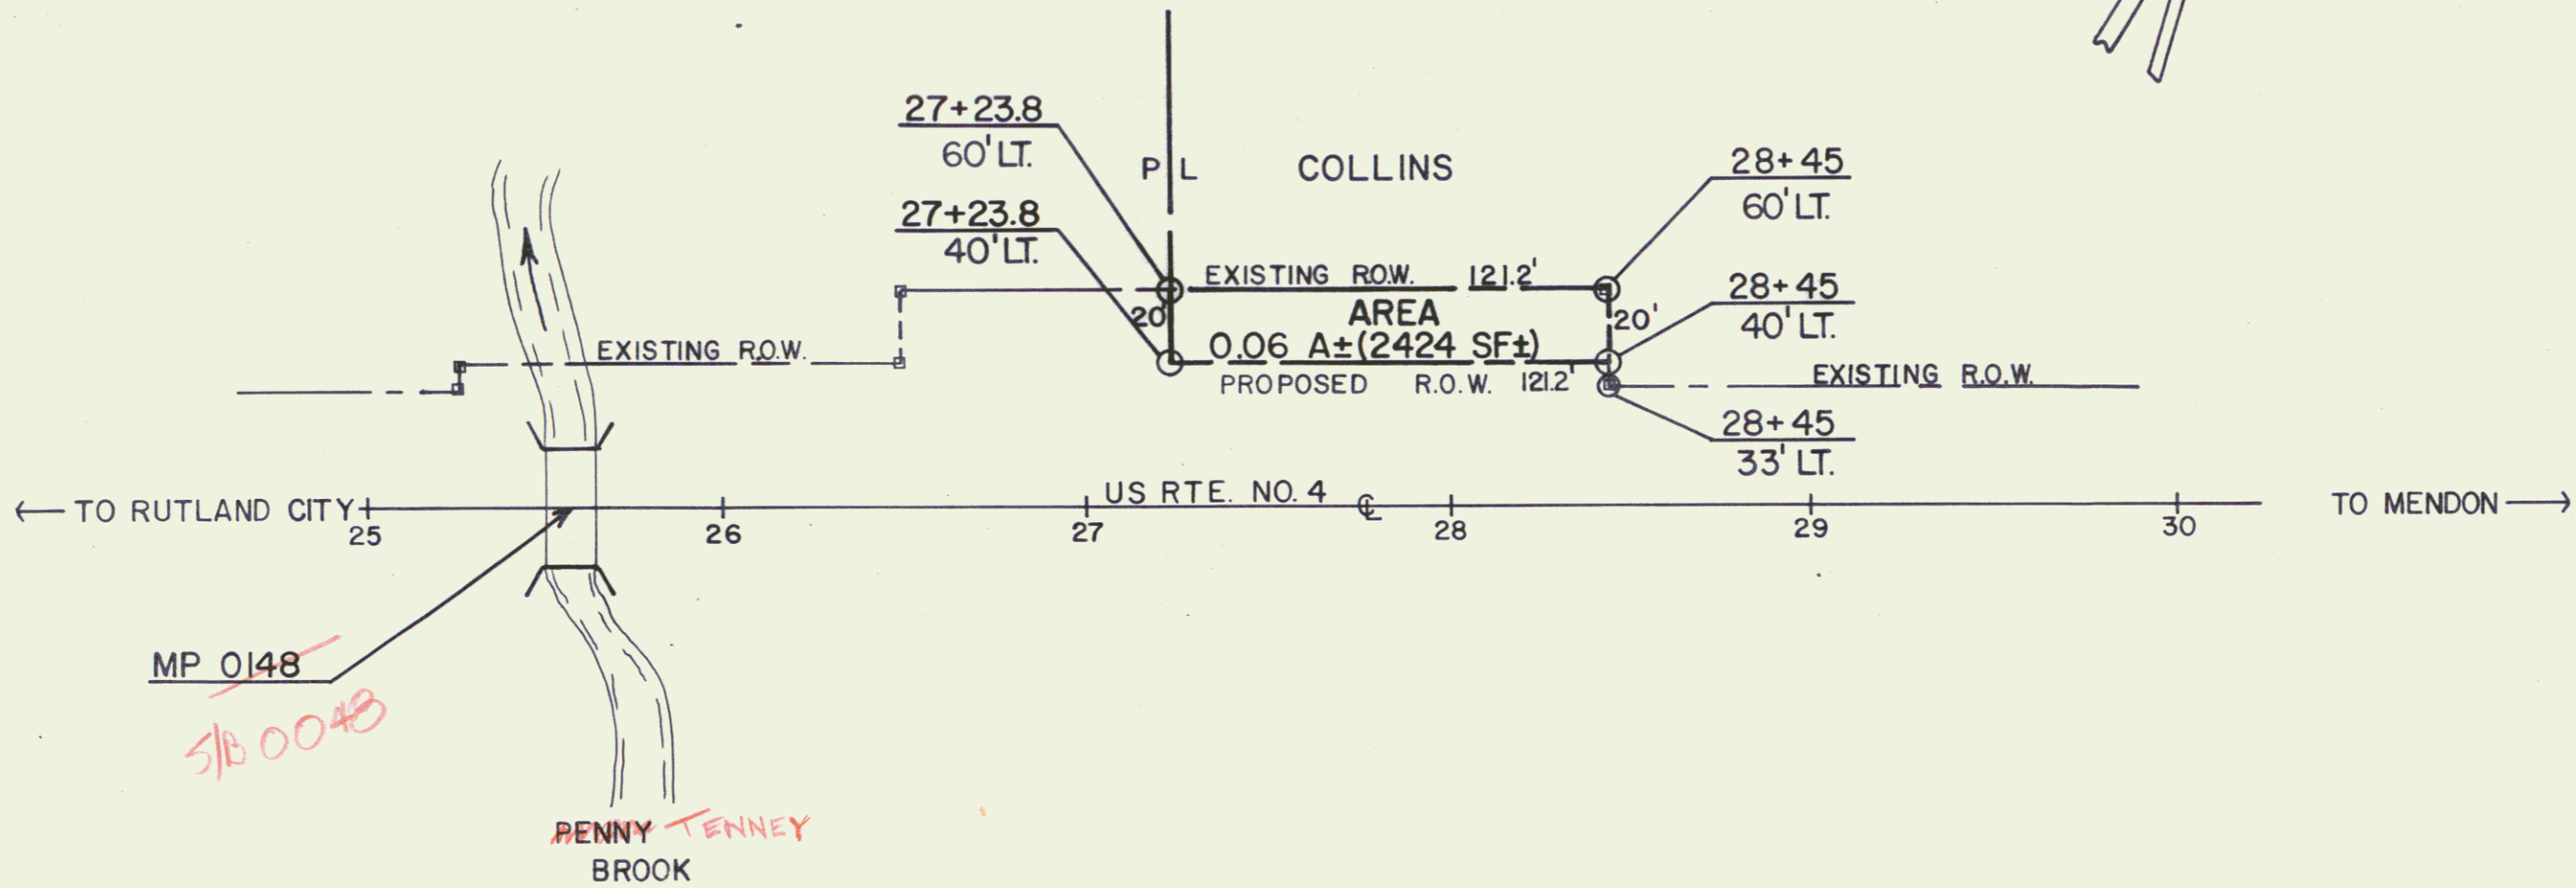


ACQUIRED FROM CHARLES H. & FRANCES M. PRIOR BY W.D. DATED MAY 14, 1938
 AND RECORDED IN BK.9 PG.52 ON MAY 17, 1938. RUTLAND TOWN LAND RECORDS
 ST. OF VERMONT TO SARAH L. BAILEY, ET AL BY Q.C.D. 11/12/80
 IN RUTLAND L.R. BK 31/573
 M.P. 0152

0057

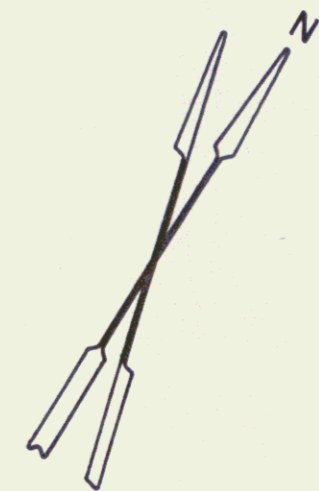

MP 0148
 51B 0048

□ - CONCRETE BOUNDS

SCALE 1" = 50'



REF. SHEET NO.5

5B

STATE OF VERMONT
 AGENCY OF TRANSPORTATION

TOWN OF RUTLAND

RUTLAND - MENDON FAP 76D(I)

APPROX. SCALE 1" = 50' DATE 10/24/80 DRAWN BY FJM

REV. 10-28-80