


45+00-46+50 Lt
Raw cut slope-gravel
TO BE SODDED
(Force Account Landscape Item.)


ED. ROAD DIST. NO.	STATE	TR. AND PROJ. NO.	YEAR	POST-MILE NO.	SHEET NO.
76-011	VT	7460	7	58	

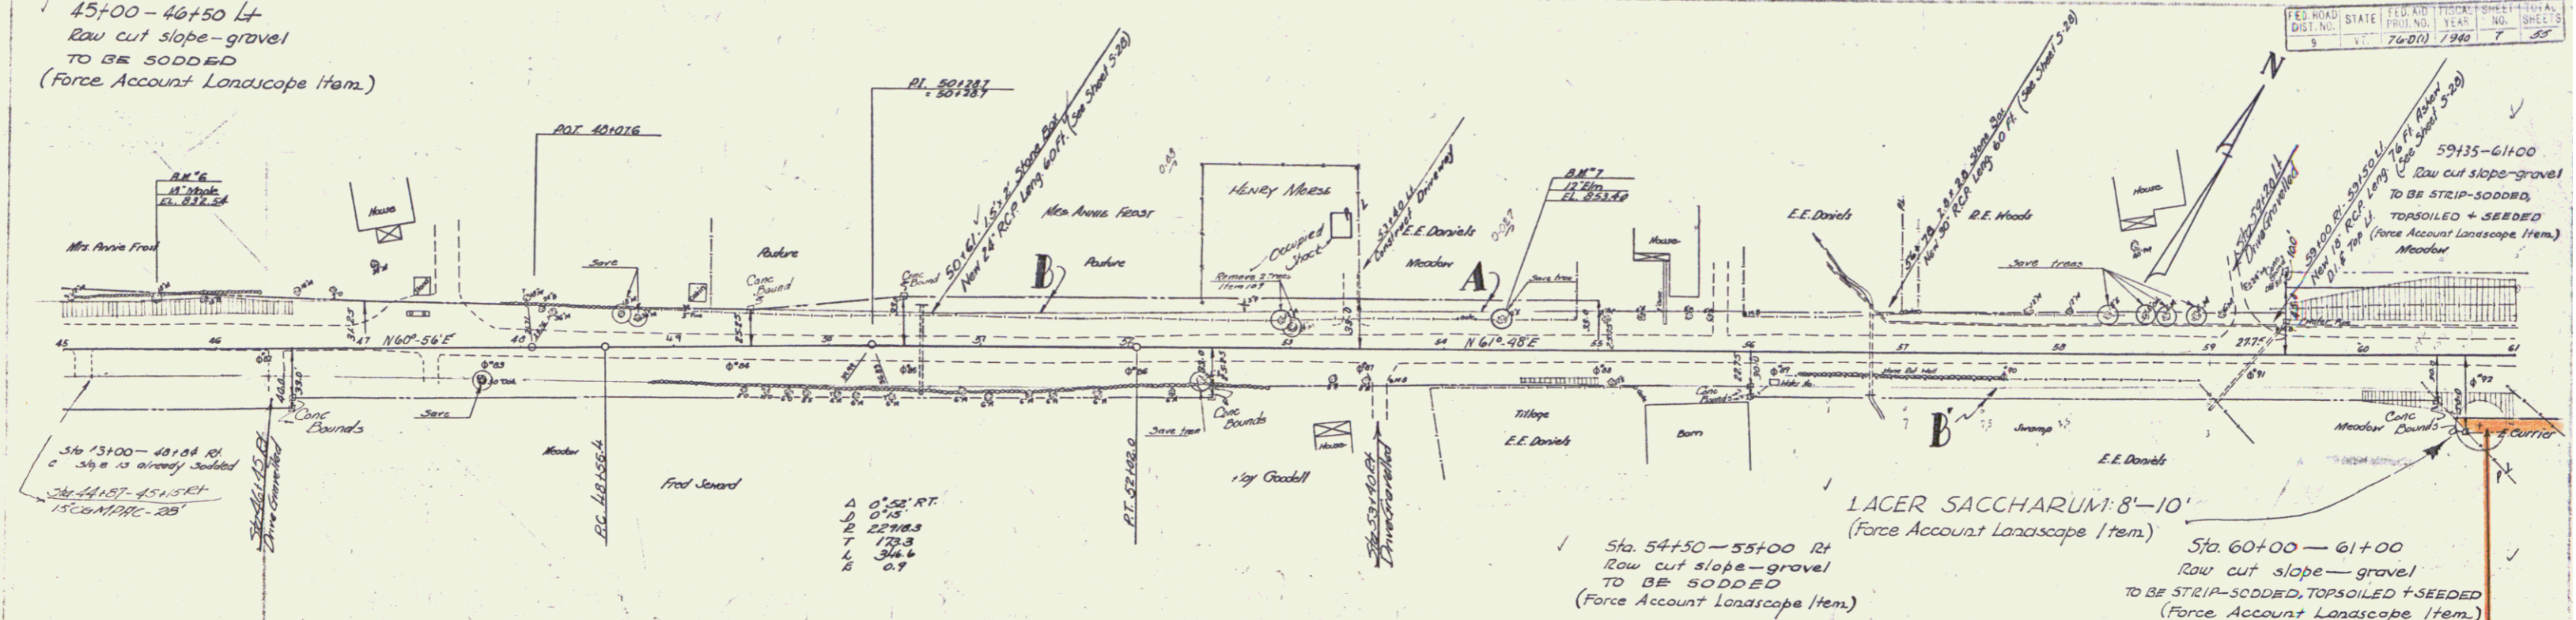

A 0.52 RT
D 0.78
E 22948.3
T 173.3
L 34.6
S 0.7

PARCEL	INSTRUMENT	DATE	GRANTOR	GRANTEE	RECORDED	REMARKS
B	Q.C.D.	4-26-38	ANNIE H. FROST	ST. OF VT	BOOK PAGE DATE	
A-B'	W.D.	4-26-38	E.E. DANIELS	"	9 41 4-30-38	
					9 46 4-30-38	

(985SF)±
State of Vermont to Eugene T. Stiles Sr.
By Q.C.D. Recorded I-8-75 Bk. 23 Pg. 312

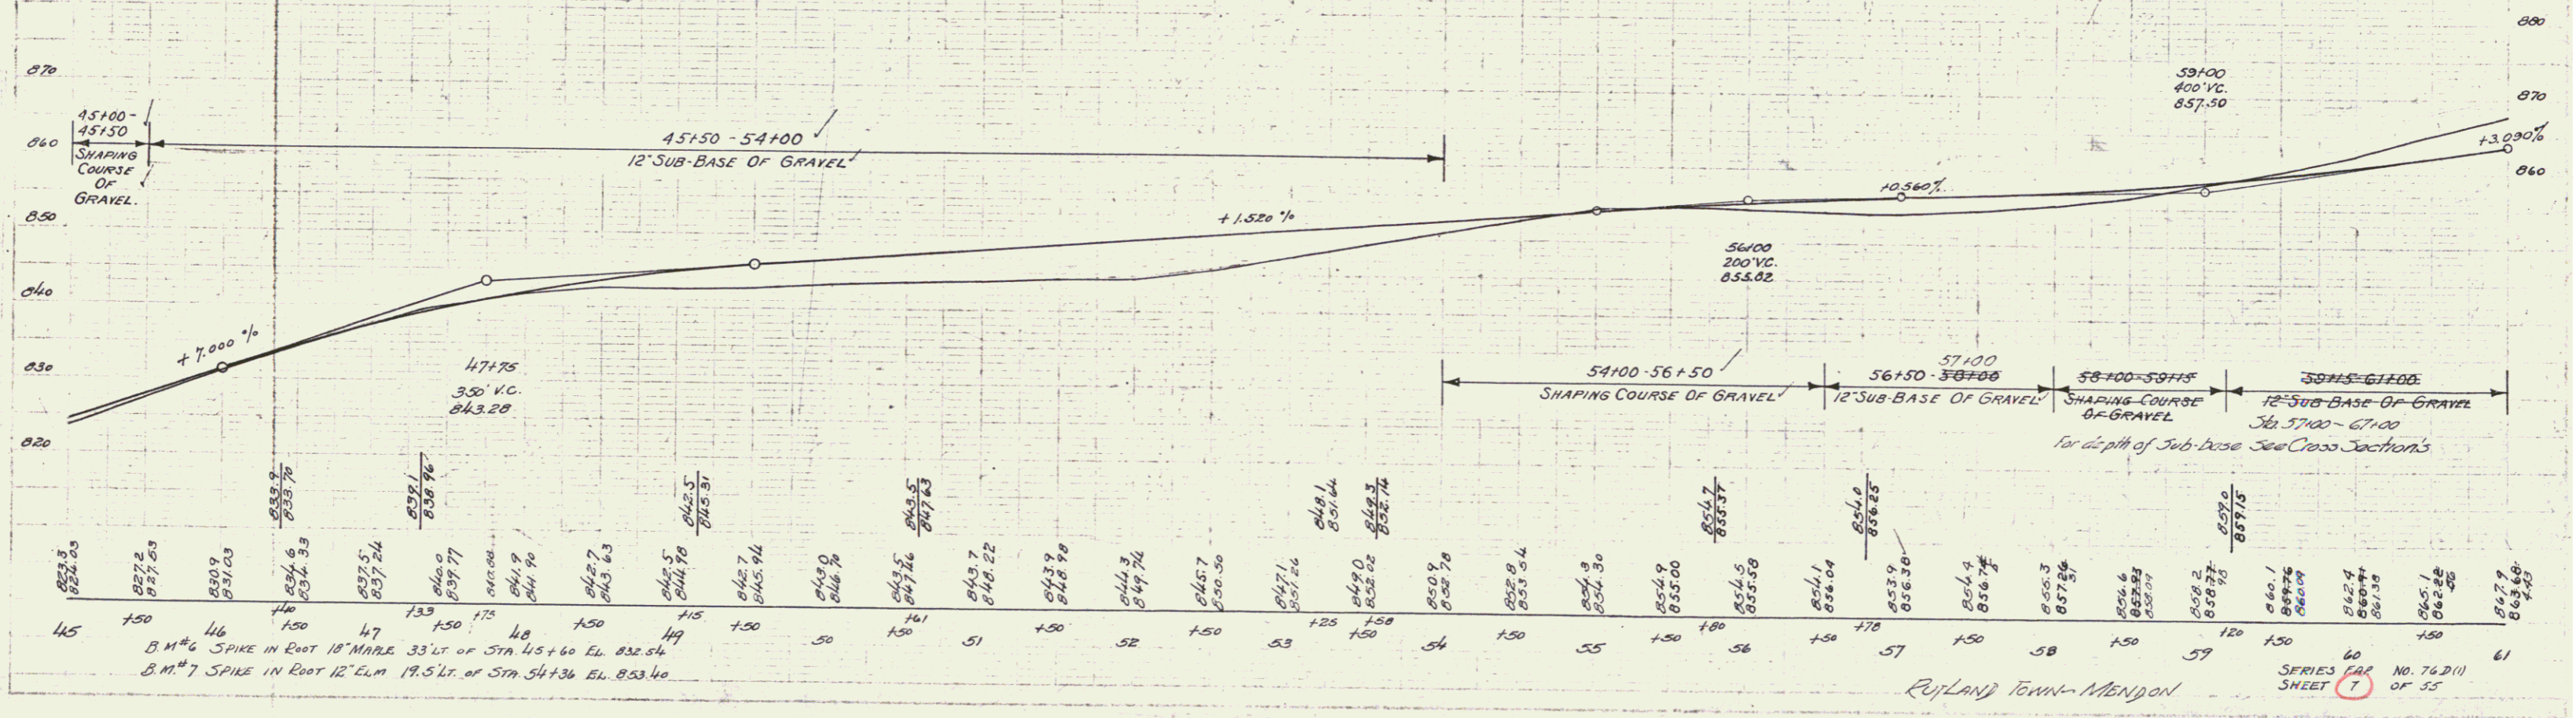

B.M. #6 SPIKE IN ROOT 18" MAPLE 33' LT. OF STA 45+60 EL. 832.54
B.M. #7 SPIKE IN ROOT 12" CUM. 19.5' LT. OF STA 54+36 EL. 853.40

RUTLAND TOWN-MENDON
SERIES FOR SHEET NO. 76-011 OF 55