

NOTE
 On The Right From STA. 79+40' To STA. 83+00'
 By Right Of Way Agreement It Is Made A Condition
 Of This Easement That The Stone Wall Adjacent To The
 Highway Shall Be Removed And The Trees Remained Shall
 Be Cut Up And Piled Adjacent To The Said Right Of Way Herein
 Conveyed And Remain The Property Of Said Mandigo.

84+50 - 90+00 Rt
 10 ACER SACCHARUM: 8'-10'
 (Force Account Landscape Item.)

86+50 - 90+00 Lt
 5 ACER SACCHARUM: 8'-10'
 (Force Account Landscape Item.)

HALF SECTION SHOWING C.R.M. RETAINING WALL
 STA. 90+10 - 91+10 Rt.

77+00 - 79+00 Rt
 5 ULMUS AMERICANA: 8'-10'
 (Force Account Landscape Item.)


84+25 - 90+10 Rt
 Raw cut slope - gravel
 To Be STAIR-ROADED, TOPSOILED & SEEDED
 (Force Account Landscaping Item.)

PARCEL	INSTRUMENT	DATE	GRANTOR	GRANTEE	RECORDED	REMARKS
B-C-D	W.D.	4-30-38	DR. JOHN M. & SARAH G. THOMAS	ST. OF VT.	BOOK PAGE DATE 15 443-50 4-30-38	Raw Slope - Gravel TO BE SOODED
A	W.D.	4-30-38	GEORGE H. SERGEANT	"	15 451 4-30-38	(Force Account Landscape Item.)
	A.C.	5-14-38	JOHN J. & FLORENCE M. MANDIGO	"	31 17 11-1-39	

CURVE # 4
 A. 0' 50" R
 D. 91.42
 E. 22719.3
 L. 123.4
 T. 306.7
 E. 0.9

The drive RL of Sta. 91+00 is to be relocated by the property owner at Sta. 92+50 on the right.

The contractor shall arrange his work to permit the owner to move the driveway on Rt. of Sta. 89+50 before const. is begun.

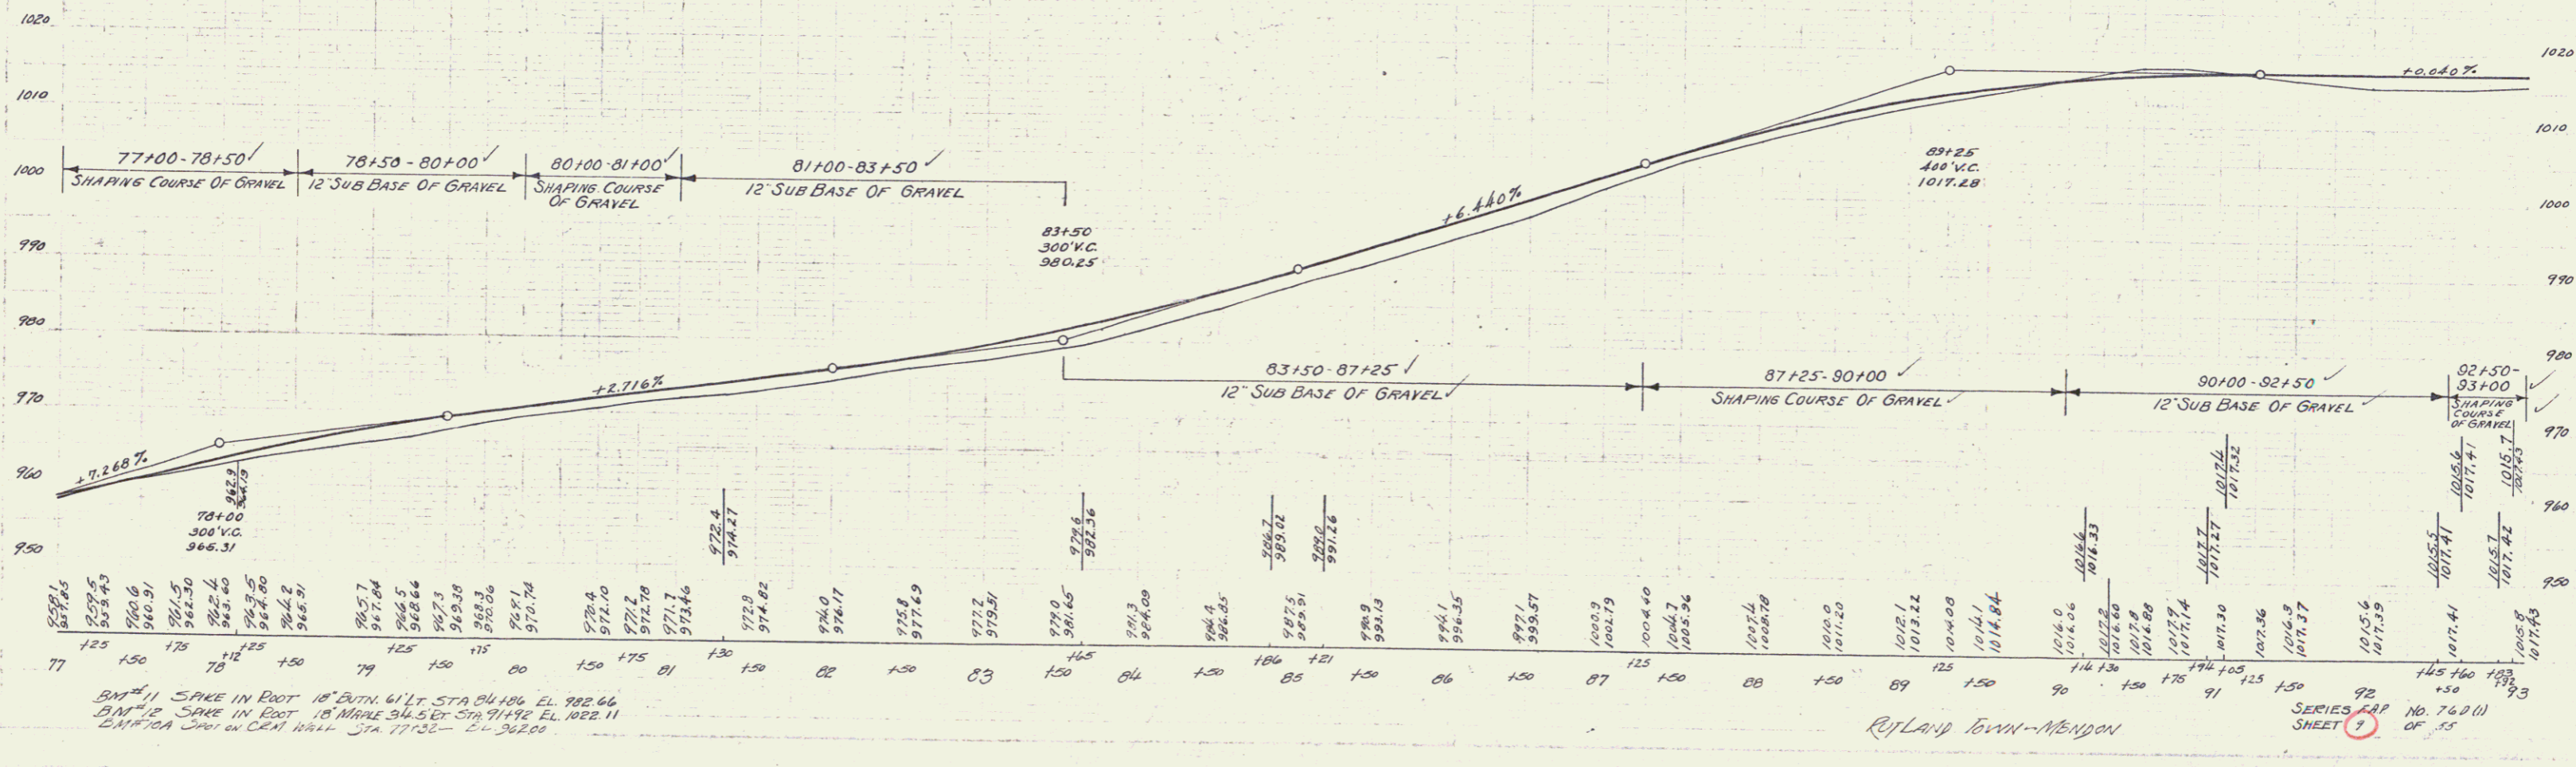

BM #1 SPIKE IN FOOT 10" BUT. W/ LT STA. 84+100 EL. 982.66
 BM #2 SPIKE IN FOOT 10" BUT. 34.5' EX. STA. 91+92 EL. 1022.11
 BM #3 SPIKE IN CENT. WALL STA. 77+25 EL. 966.31

REYLAND TOWN - MENDON
 SERIES MAP No. 760 (1)
 SHEET 7 OF 35