
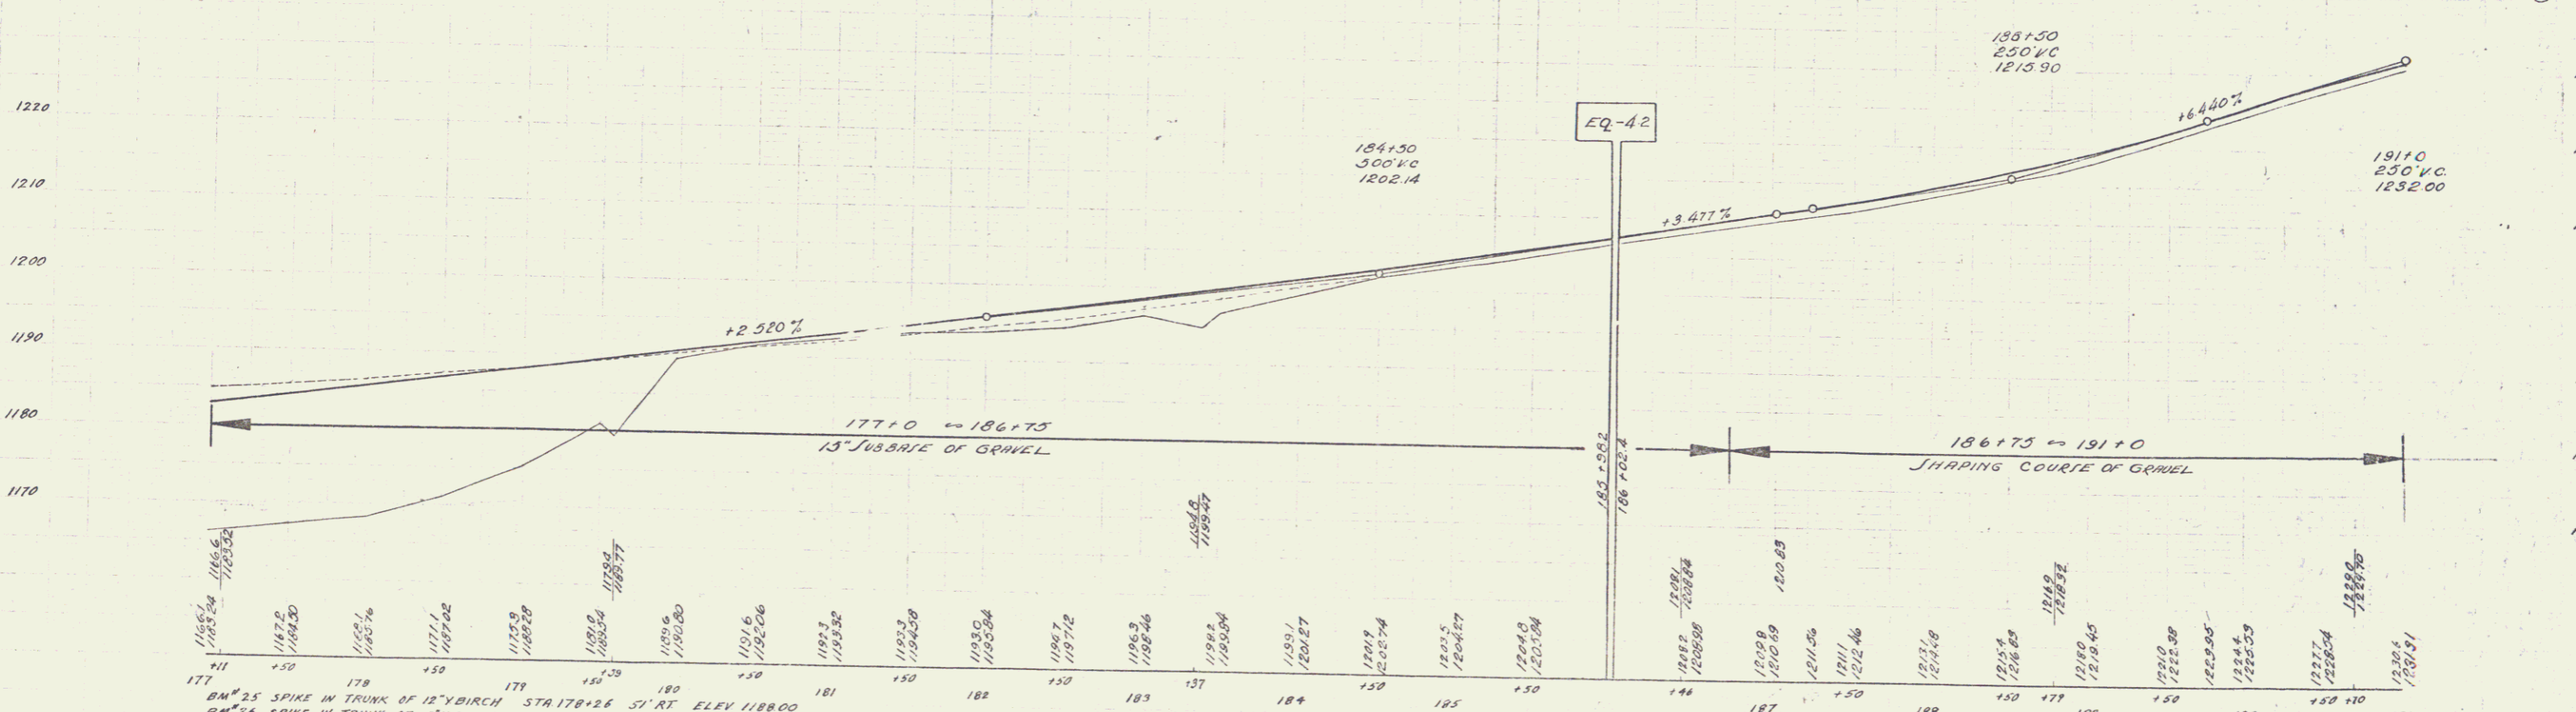


G.M. LANE
 C.E. PATTERSON
 J.H. CASES
 J.M. CASES
 THARCO
 1/41
 1/41

1/41
 1/41
 G.M. LANE
 C.E. PATTERSON
 J.H. CASES
 J.M. CASES

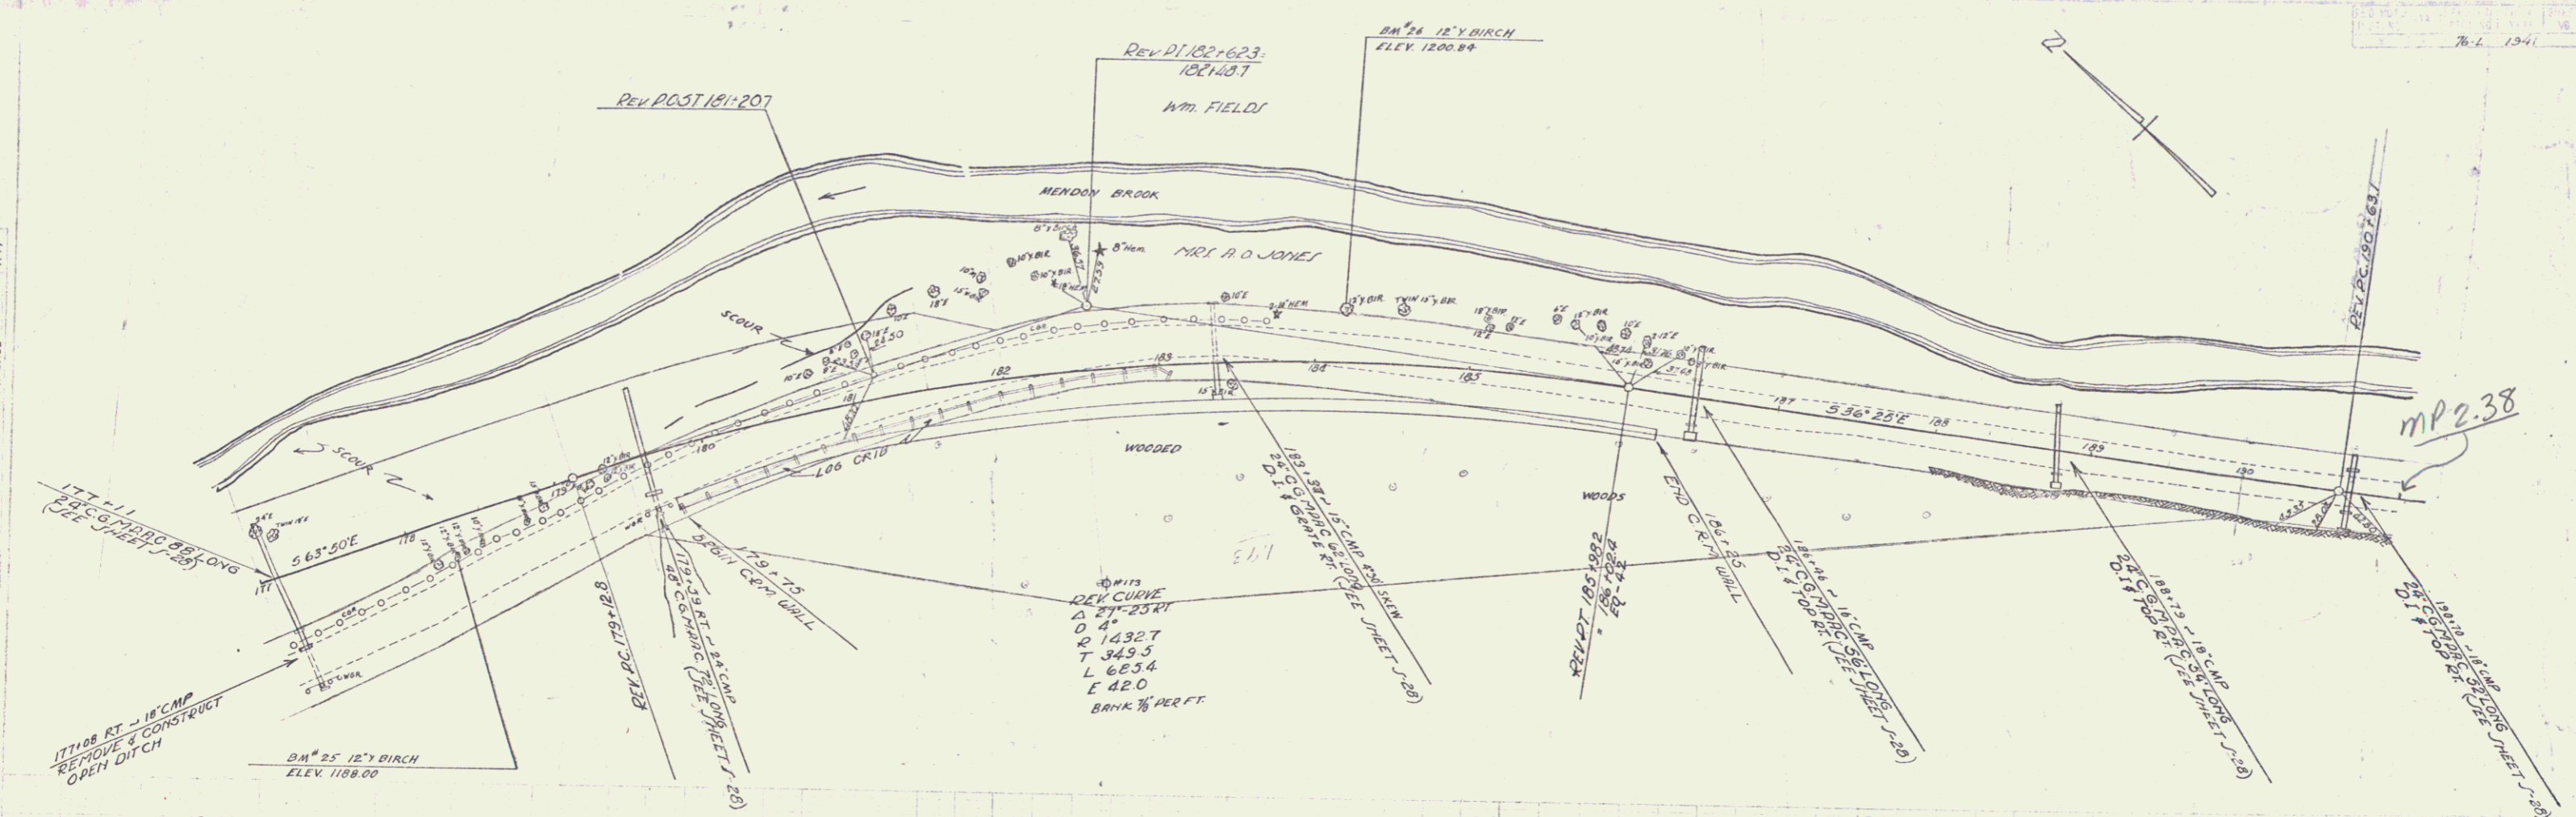

177 BM #25 SPIKE IN TRUNK OF 12" BIRCH STA 178+24 ST. RT. ELEV 1188.00
 178 +50
 179 +50
 180 BM #26 SPIKE IN TRUNK OF 12" BIRCH STA 184+22 ST. RT. ELEV 1200.84
 181 +50
 182 +50
 183 +50
 184 +50
 185 +50
 186 +50
 187 +50
 188 +50
 189 +50
 190 +50
 191 +50

SERIES NO 76-L
 SHEET 5 OF

5