
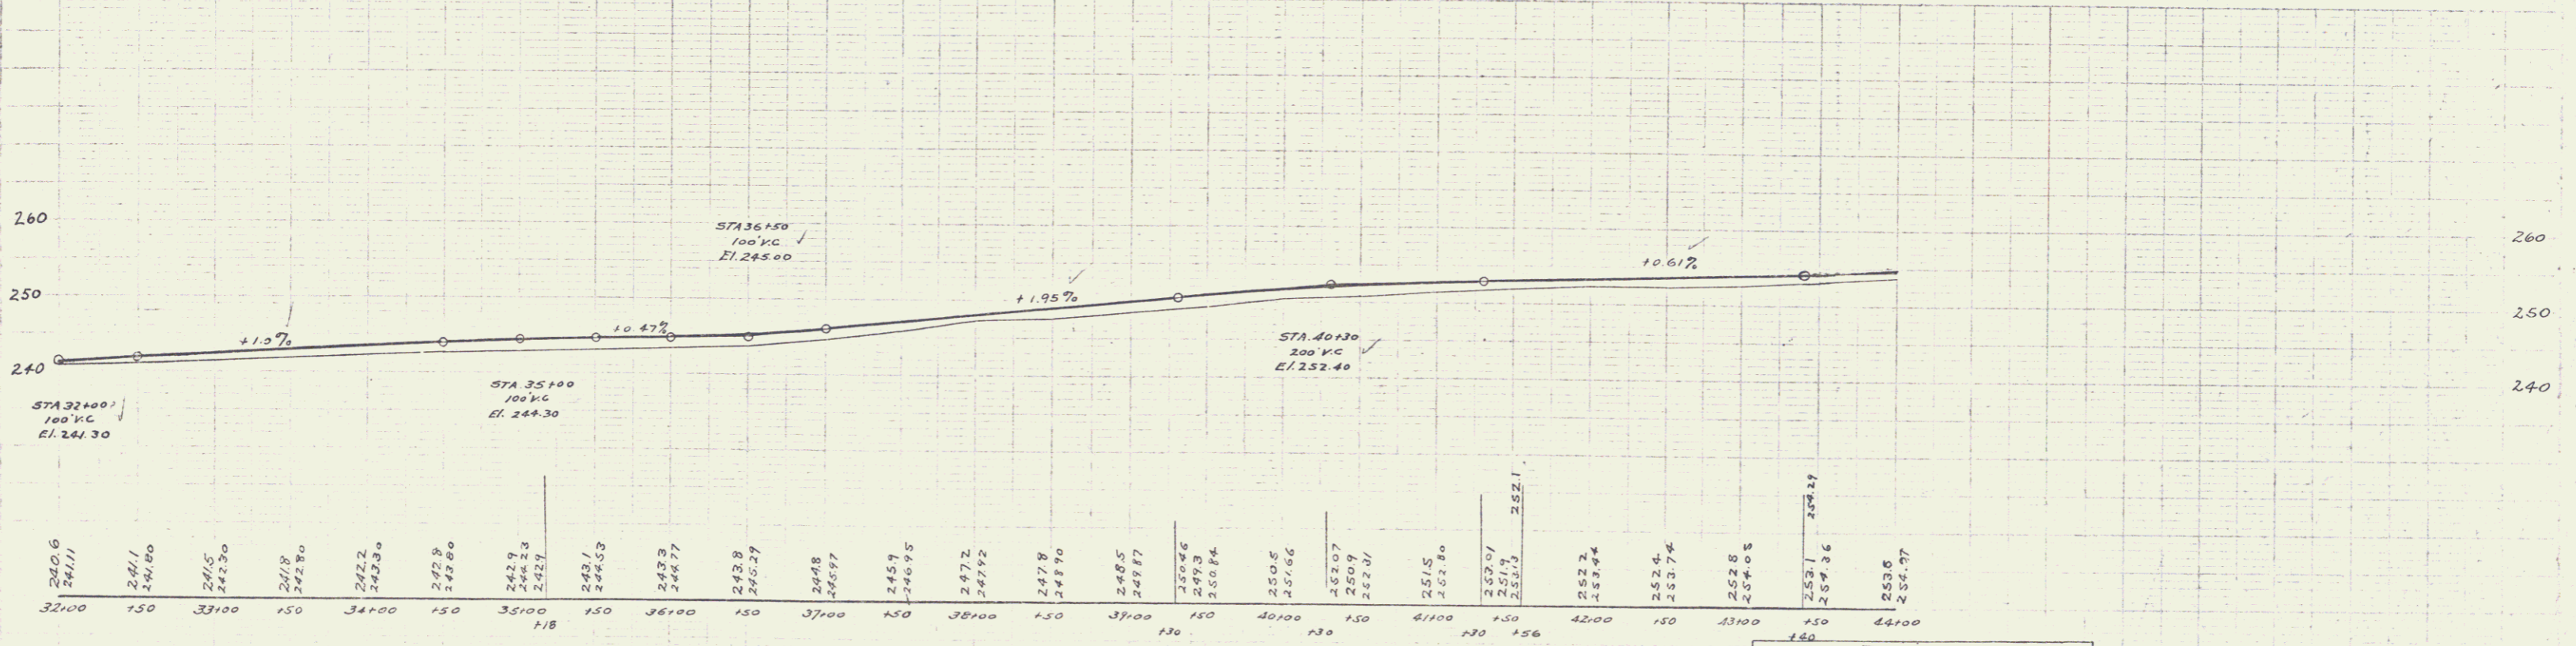


NEW CORR GALV METAL PIPE CULVERTS REQUIRED.

STA	SIZE	LENGTH	CEMENT/RUBBLE MASONRY
41+56	16"	30'	27 @ 40¢
35+18	16"	30'	27

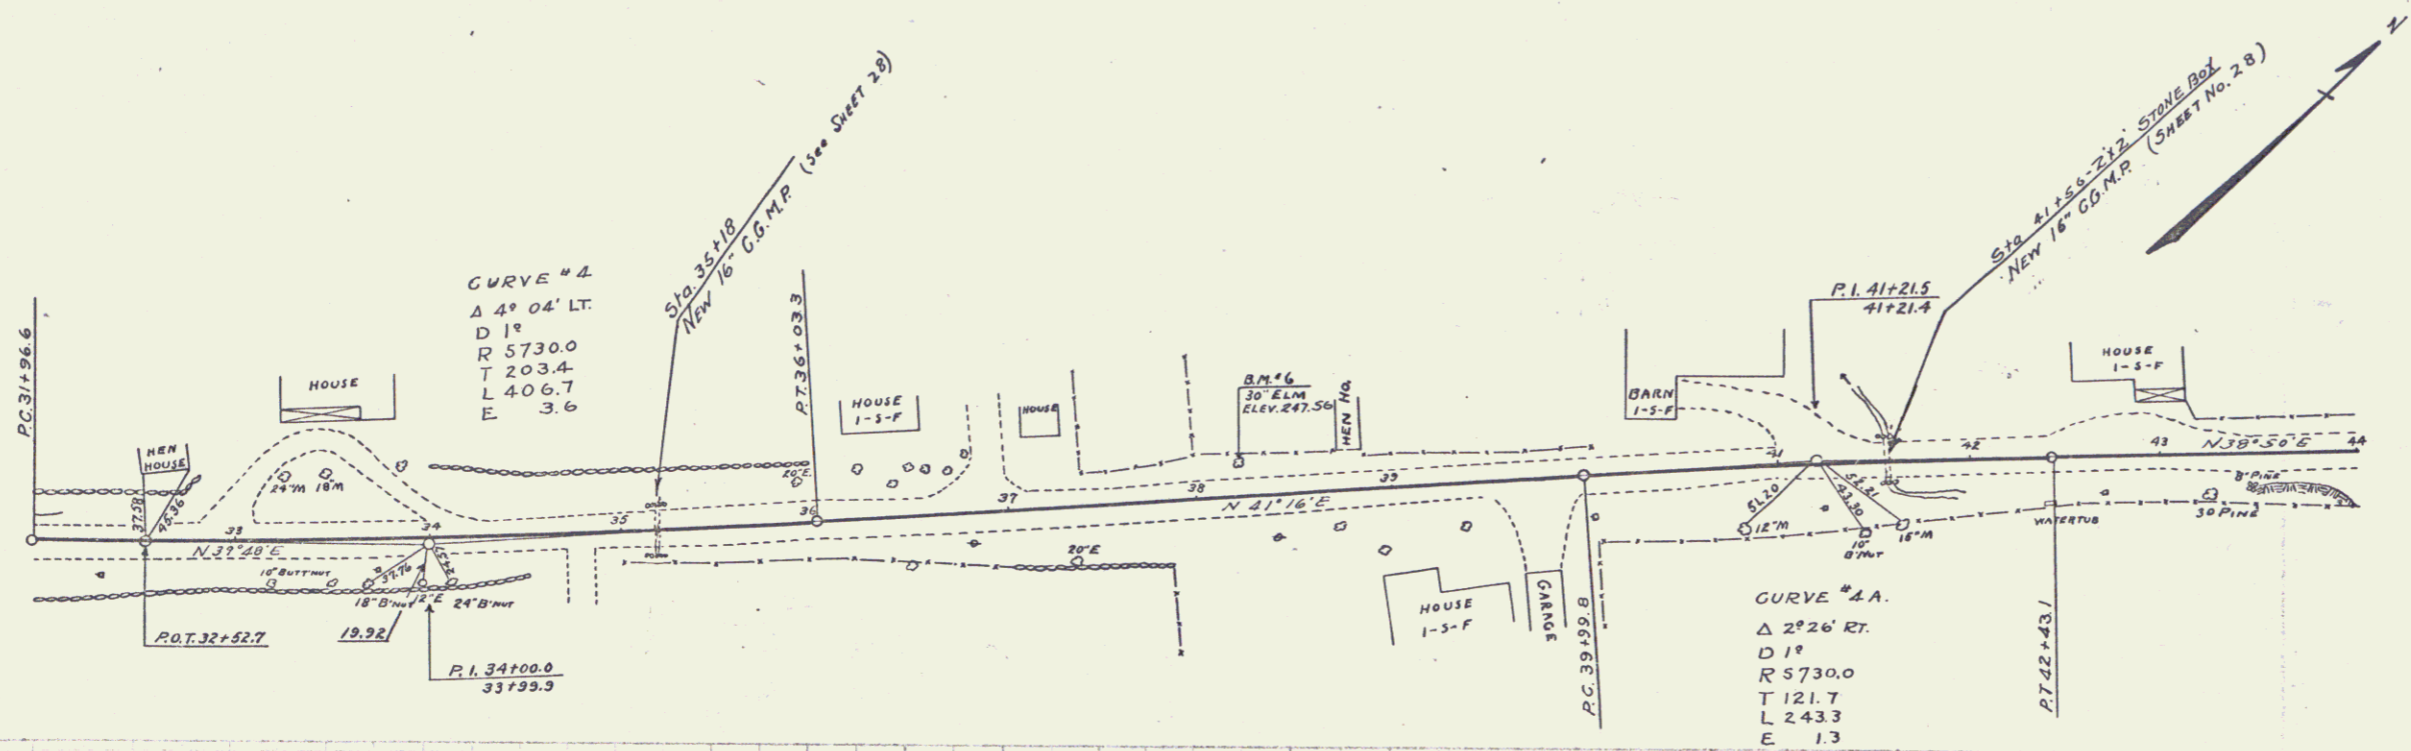

32+00	240.6
32+10	241.1
32+20	241.6
32+30	242.1
32+40	242.6
32+50	243.1
32+60	243.6
32+70	244.1
32+80	244.6
32+90	245.1
33+00	245.6
33+10	246.1
33+20	246.6
33+30	247.1
33+40	247.6
33+50	248.1
33+60	248.6
33+70	249.1
33+80	249.6
33+90	250.1
34+00	250.6
34+10	251.1
34+20	251.6
34+30	252.1
34+40	252.6
34+50	253.1
34+60	253.6
34+70	254.1
34+80	254.6
34+90	255.1
35+00	255.6
35+10	256.1
35+20	256.6
35+30	257.1
35+40	257.6
35+50	258.1
35+60	258.6
35+70	259.1
35+80	259.6
35+90	260.1
36+00	260.6
36+10	261.1
36+20	261.6
36+30	262.1
36+40	262.6
36+50	263.1
36+60	263.6
36+70	264.1
36+80	264.6
36+90	265.1
37+00	265.6
37+10	266.1
37+20	266.6
37+30	267.1
37+40	267.6
37+50	268.1
37+60	268.6
37+70	269.1
37+80	269.6
37+90	270.1
38+00	270.6
38+10	271.1
38+20	271.6
38+30	272.1
38+40	272.6
38+50	273.1
38+60	273.6
38+70	274.1
38+80	274.6
38+90	275.1
39+00	275.6
39+10	276.1
39+20	276.6
39+30	277.1
39+40	277.6
39+50	278.1
39+60	278.6
39+70	279.1
39+80	279.6
39+90	280.1
40+00	280.6
40+10	281.1
40+20	281.6
40+30	282.1
40+40	282.6
40+50	283.1
40+60	283.6
40+70	284.1
40+80	284.6
40+90	285.1
41+00	285.6
41+10	286.1
41+20	286.6
41+30	287.1
41+40	287.6
41+50	288.1
41+60	288.6
41+70	289.1
41+80	289.6
41+90	290.1
42+00	290.6
42+10	291.1
42+20	291.6
42+30	292.1
42+40	292.6
42+50	293.1
42+60	293.6
42+70	294.1
42+80	294.6
42+90	295.1
43+00	295.6
43+10	296.1
43+20	296.6
43+30	297.1
43+40	297.6
43+50	298.1
43+60	298.6
43+70	299.1
43+80	299.6
43+90	300.1
44+00	300.6

B. M. No. 6 30" Elm. 16' Lf. of Sta. 38+21 Elev. 247.56

REVISIONS
4. 21-30 Sta. 35+18 - 16" C.G.M.P. Lf. 30'