
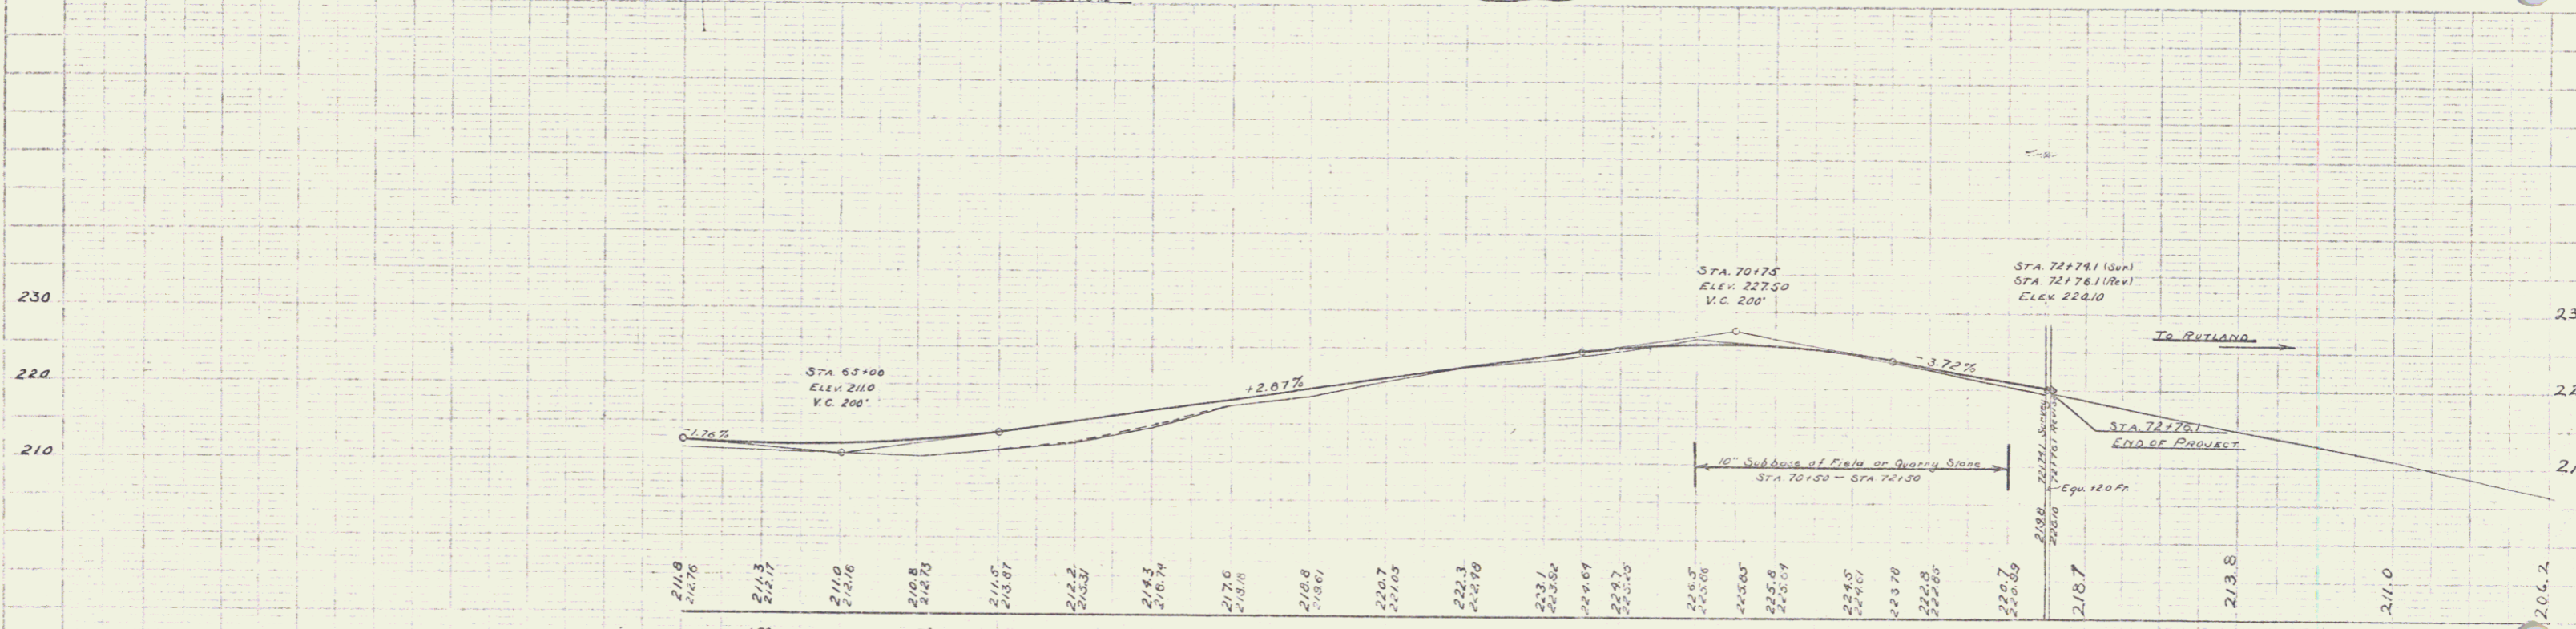


CABLE GUARD RAIL REQUIRED
 ON RIGHT
 STA 69+00 - 70+69 Length 669 Lin Ft

NEW CURVES REQUIRED
 Sta 69+75
 313 Concrete Box
 Concrete Class A (F24)
 Reinforcing Steel
 15 Cu Yds
 869 Lbs

WOOD GUARD RAIL REQUIRED
 ON LEFT
 STA 69+63 - 69+87 Length 24 Lin Ft

FED ROAD STATE PROJ NO. YEAR
 76.8 1976 12 12

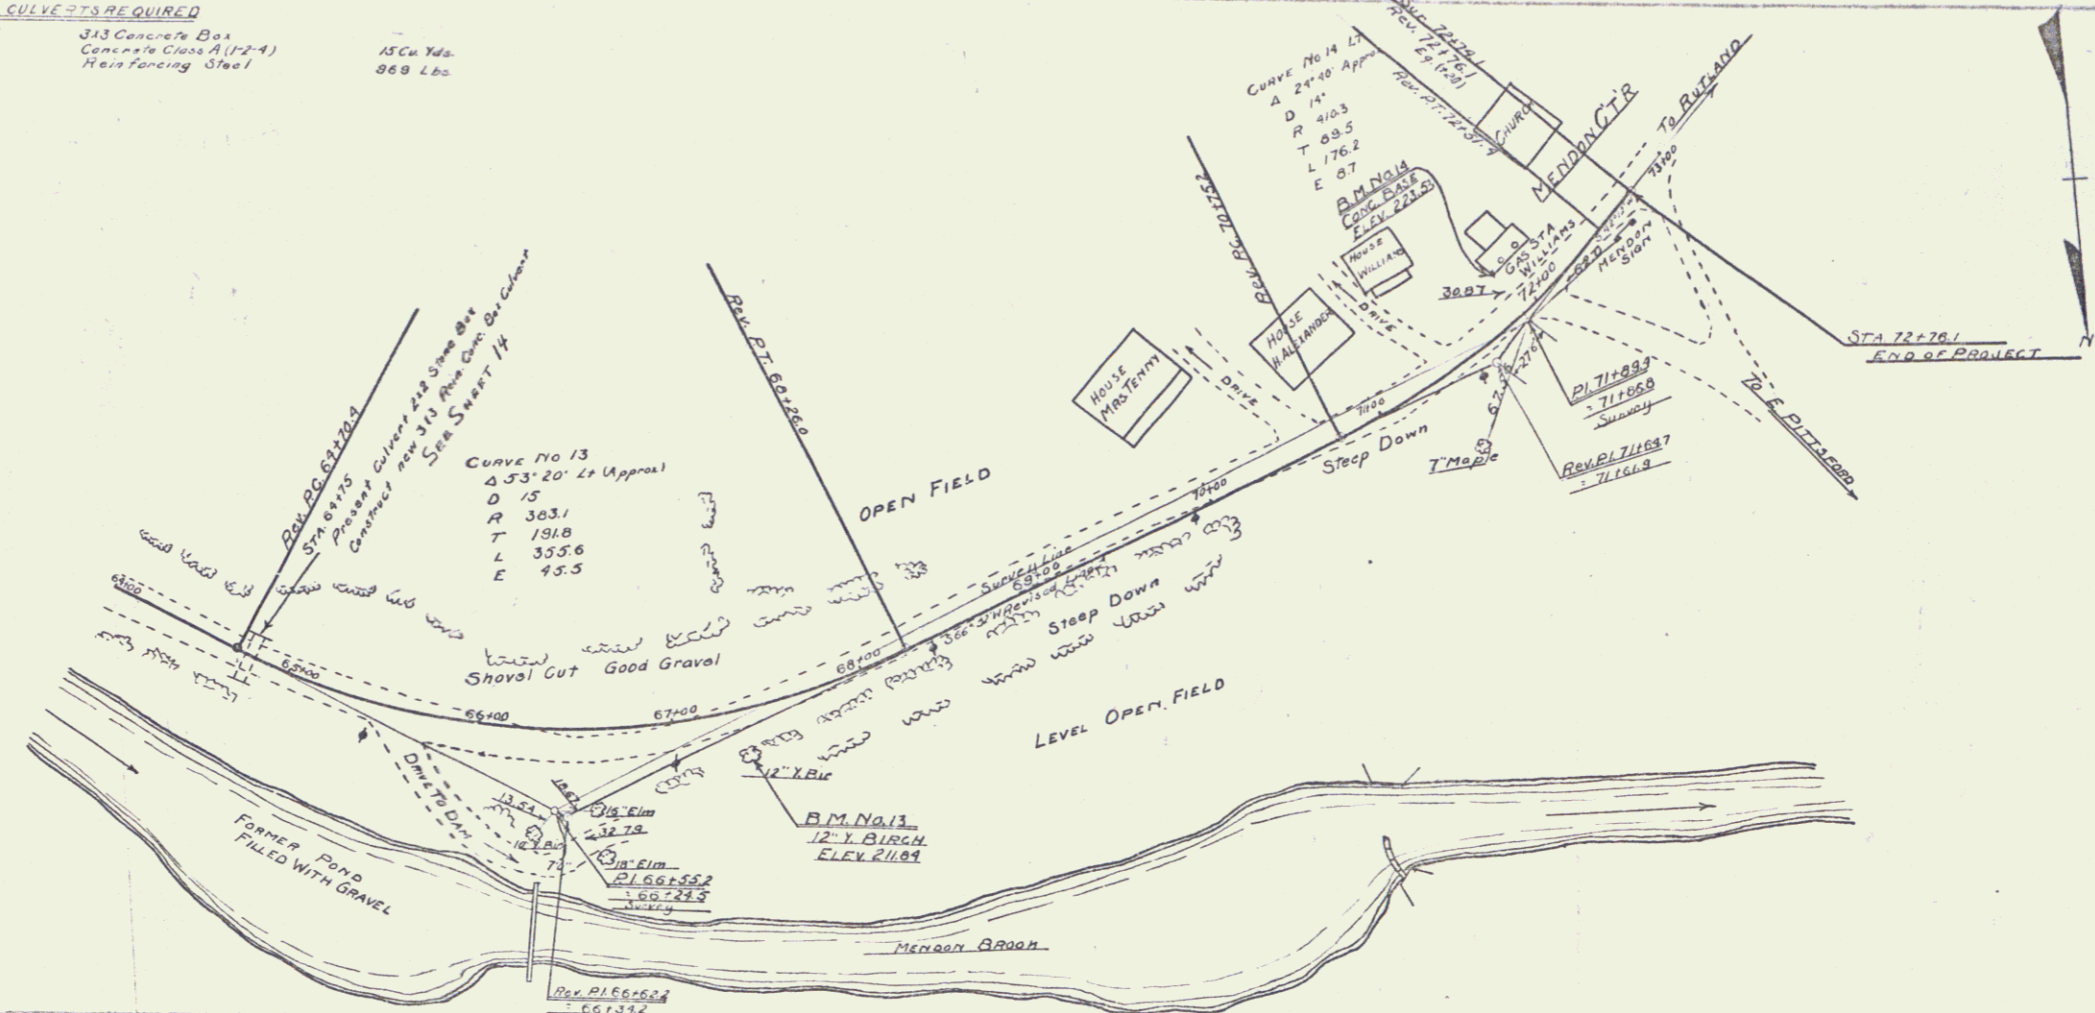

B.M. NO. 13 SPIKE IN 12" BIRCH RT. STA. 67+93 ELEV 211.81
 B.M. NO. 14 N.E. CORNER CONC. BASE LT. STA. 71+95 ELEV 223.53

SERIES P. M. 78B
 Sheet 12 of 22
 12