

WOOD GUARD RAIL REQUIRED

CULVERT STATION	LEFT	RIGHT
63+47	24'	24'
68+45	24'	24'
71+32	24'	24'
75+02	24'	24'



NEW CORRUGATED GALVANIZED METAL PIPE CULVERTS REQUIRED

STATION	DIAM	LENGTH	CONC. A	REIN. STEEL	CONC. RUB. MASSIVE
63+47	18"	34'	---	---	3.5'
71+32	14"	34'	---	---	2.5'
75+02	14"	34'	---	---	2.5'

NEW REIN. CONC. BOX CULVERTS REQUIRED

STATION	SIZE	CONC. A	REIN. STEEL
68+45	3x3'	182x4	1218 lbs.

76B 1930 17 69

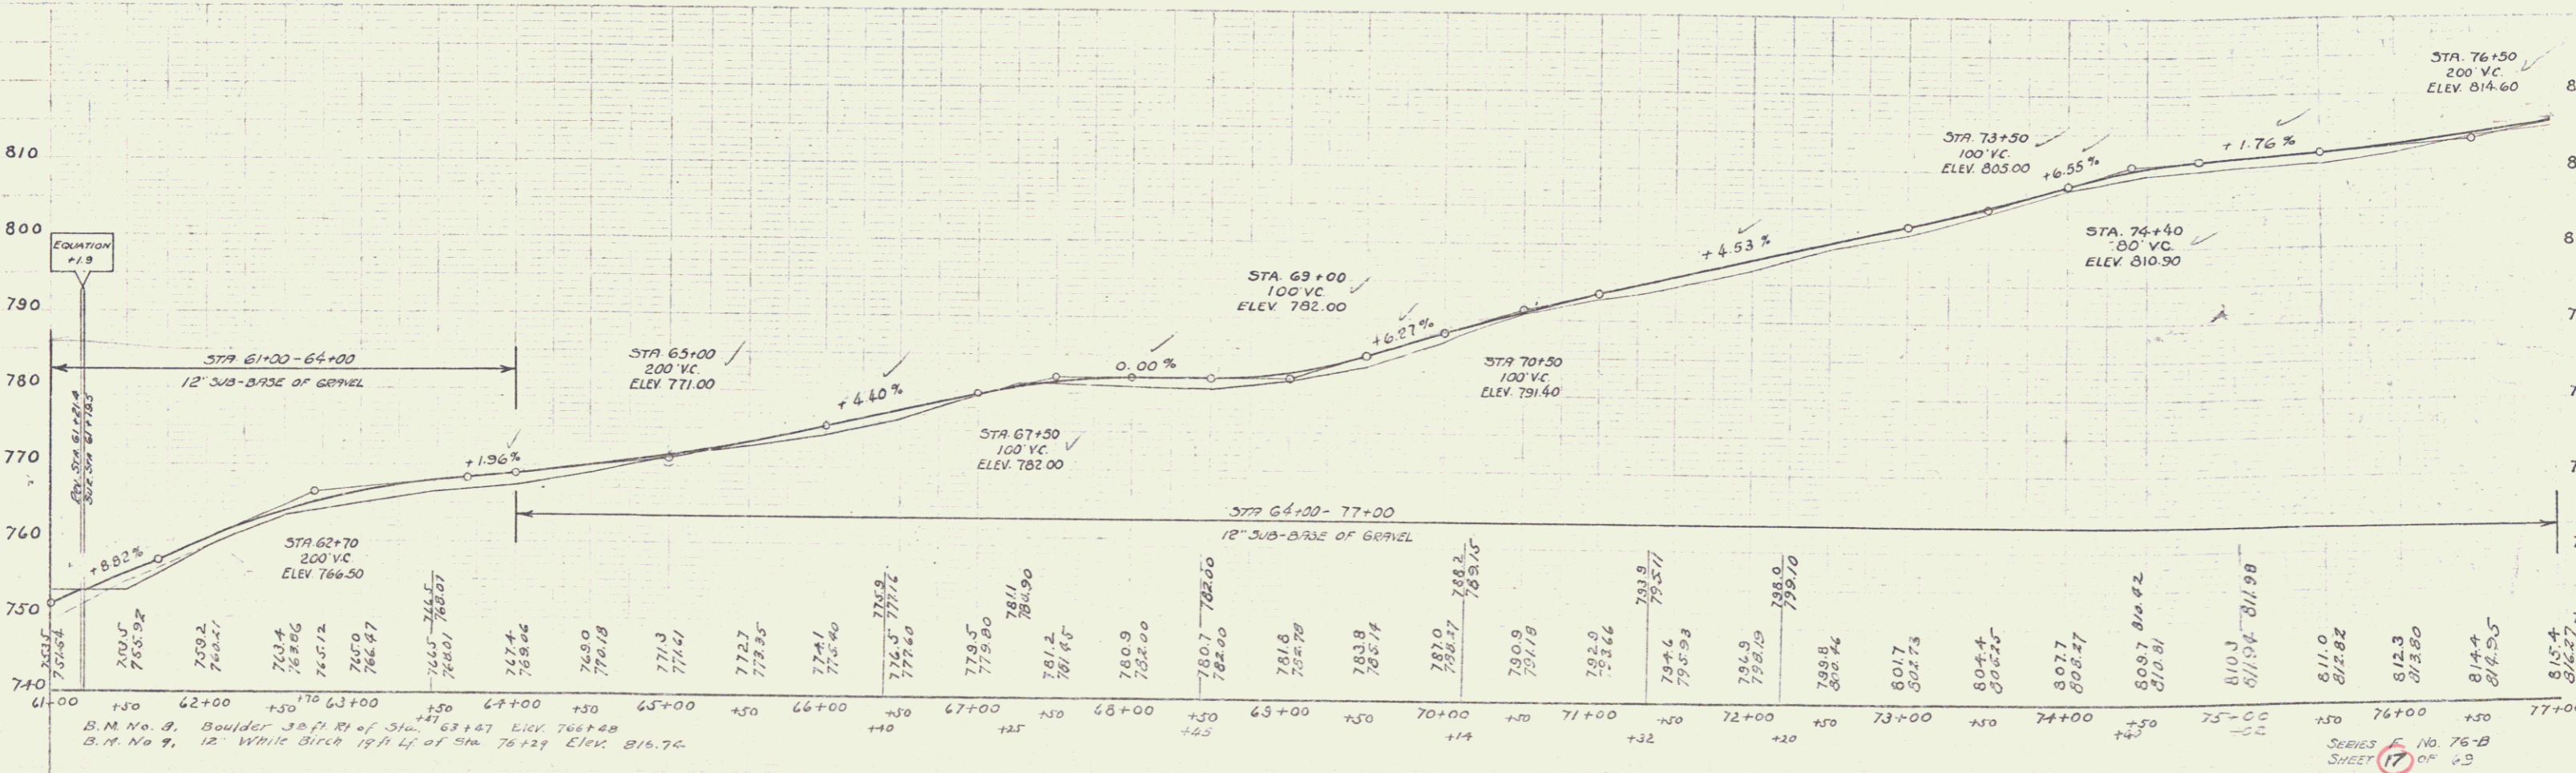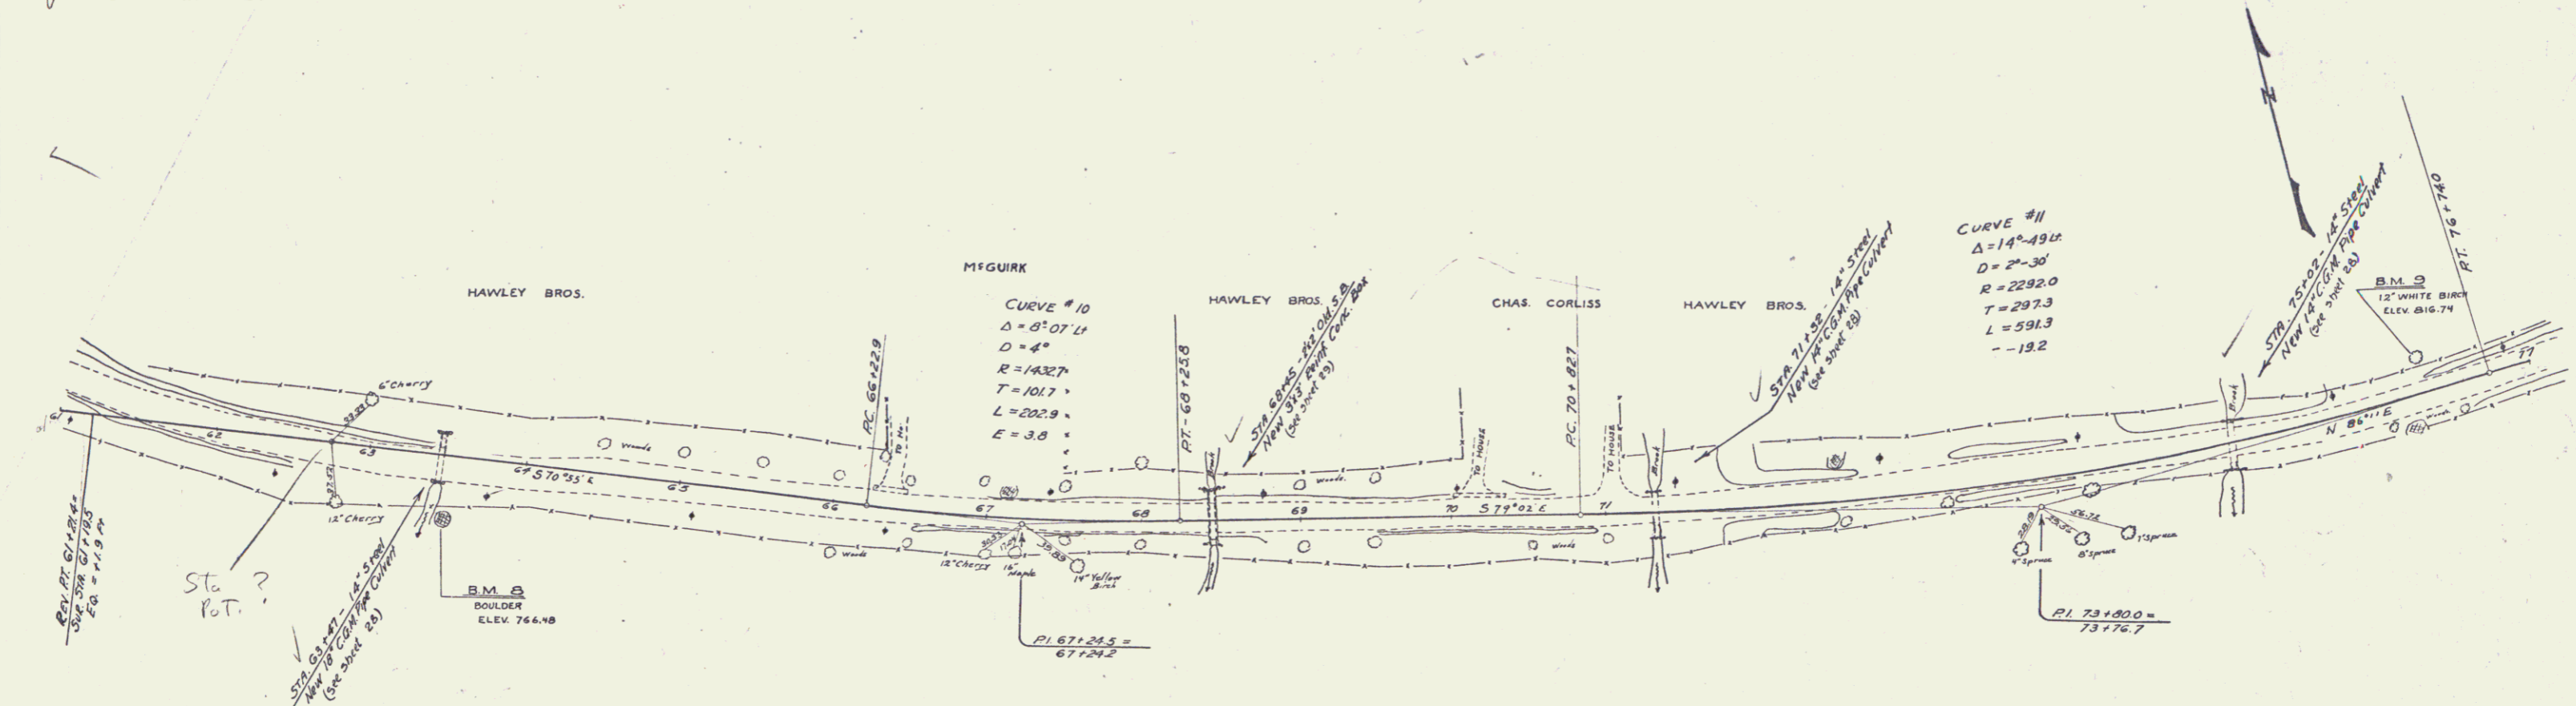

B.M. No. 8, Boulder Sta. 71 R of Sta. 63+47 Elev. 766.48
 B.M. No. 9, 12' White Birch 17' N of Sta. 76+50 Elev. 816.74

SERIES No. 76-B
 SHEET 17 OF 43

5