
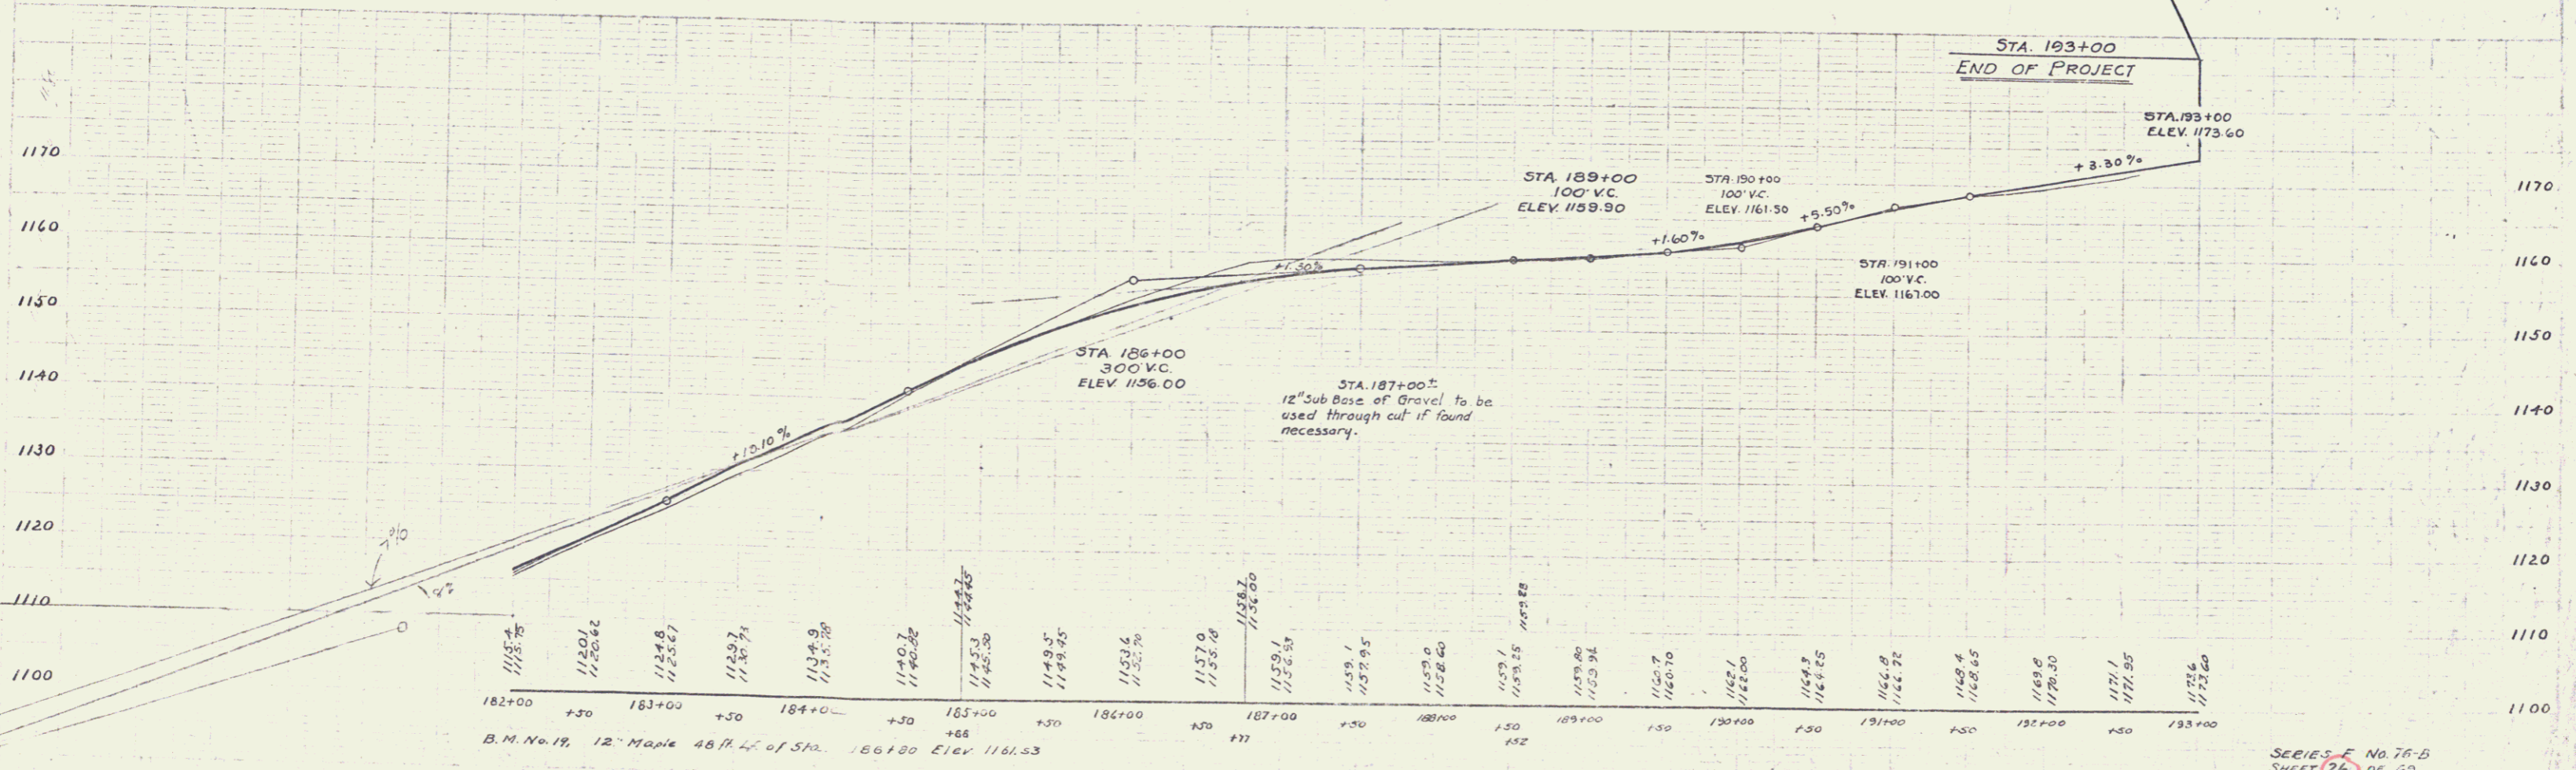


WOOD GUARD RAIL REQUIRED
 CULVERT STATIONS LEFT RIGHT
 188+52 24' 24'

CABLE GUARD RAIL REQUIRED
 STA. TO STA. LEFT RIGHT
 186+64-187+60 - 96

NEW CORRUGATED GALVANIZED METAL PIPE CULVERTS REQUIRED
 STATIONS DIMS. LENGTH CONC. RINGS REIN. STEEL CONC. S.S. MANHOLE
 188+52 18' 42' - - - 3.3 cy.

STATE 83
 76-B 1930 26 69

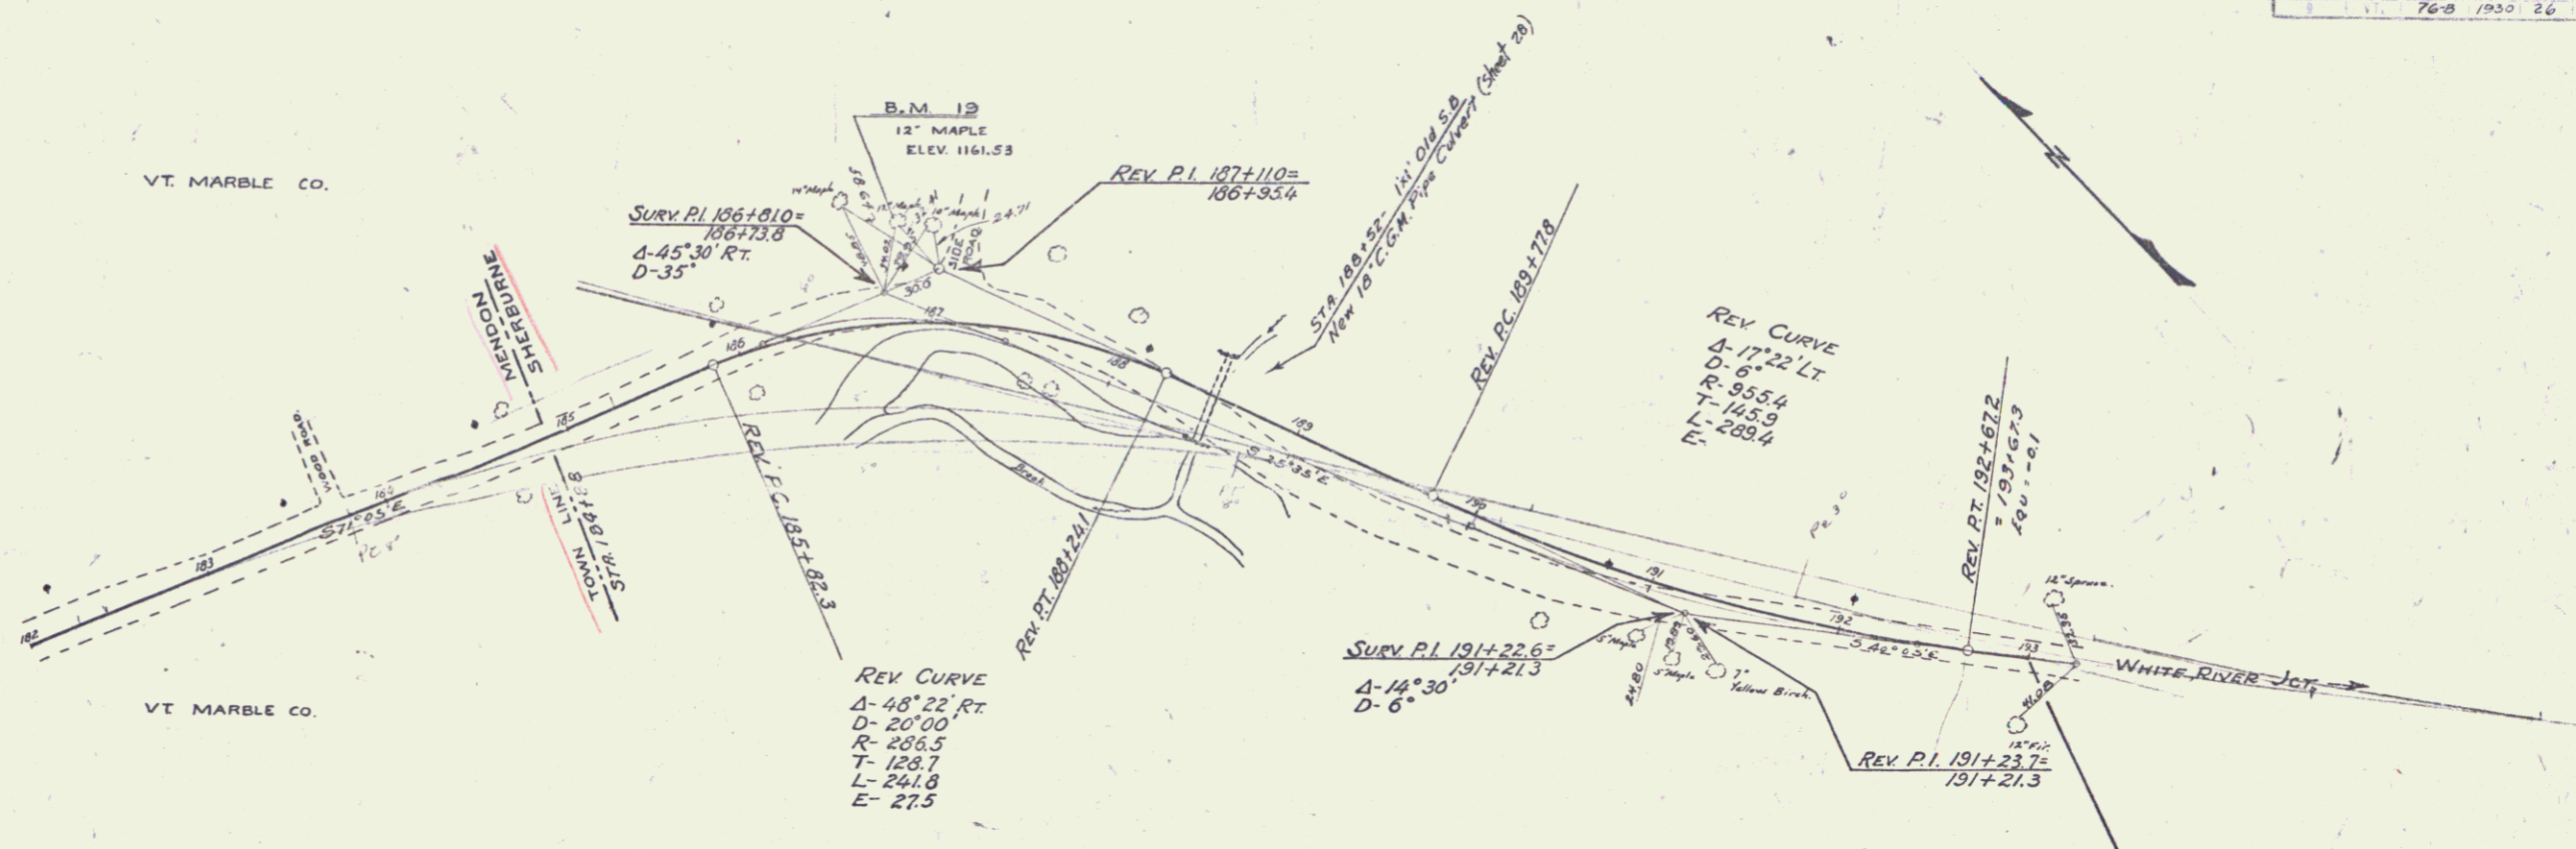

SERIES F No. 76-B
 SHEET 26 OF 69