


details
 Contact RAPT.
 Nancy Rice.

#21 HAROLD L. & EDITH D. BARBER
 (109±) STA 312+95-317+52±
 COND 6/22/56
 RECORDED WENON-BK 19 - PG 102/115-6/22/56
 510 311+31 Water Pipe Sleeve
 316± Right-of-Way Bid Item
 Install sleeves for water pipe, Item 4.31 -
 Sleeve to be furnished by State of Vermont
 Trench Excavation, Item 103

1003.58

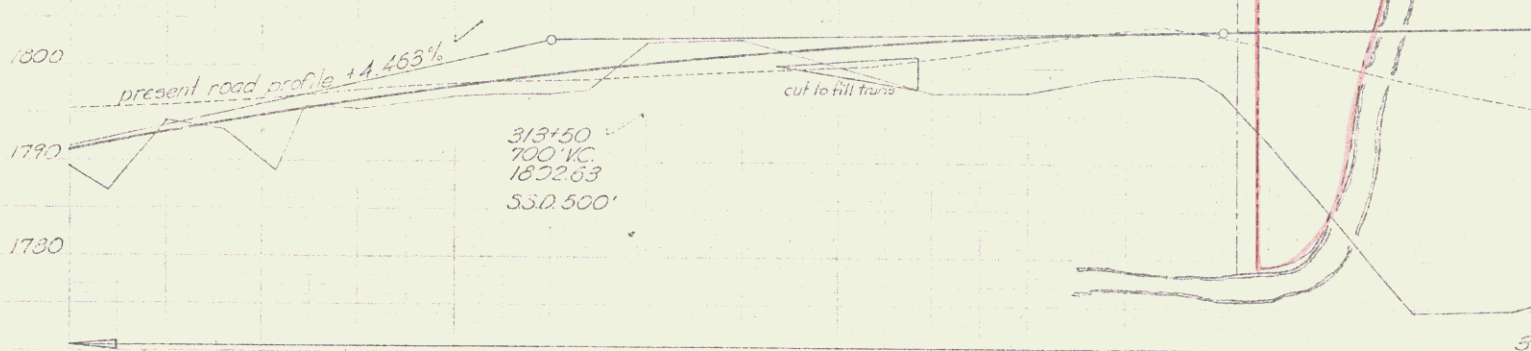

1789.4	1786.9	1794.2	1793.3	1789.0	1795.5	1796.5	1797.1	1797.1	1797.6	1802.4	1802.8	1803.2	1797.3	1797.5	1799.0	1799.5	1799.9	1797.6	1792.4	1786.5	1788.7	1784.6	1774.9
+20	+50	+80	+07	+50	+25	+50	+50	+50	+50	+50	+50	+50	+50	+50	+50	+50	+50	+50	+50	+50	+50	+50	+50
311			312			313			314			315		316			317						318

~~511+53 Spot on Gas Pump Foundation 120' Lt. Sta 312+95 elev 1797.06~~
~~511+55 Spot on Gas Pump Foundation 120' Lt. Sta 312+95 elev 1797.06~~
~~511+55 Spot on Gas Pump Foundation 120' Lt. Sta 312+95 elev 1797.06~~