


10-22
3-52
G. Long
J. Clark

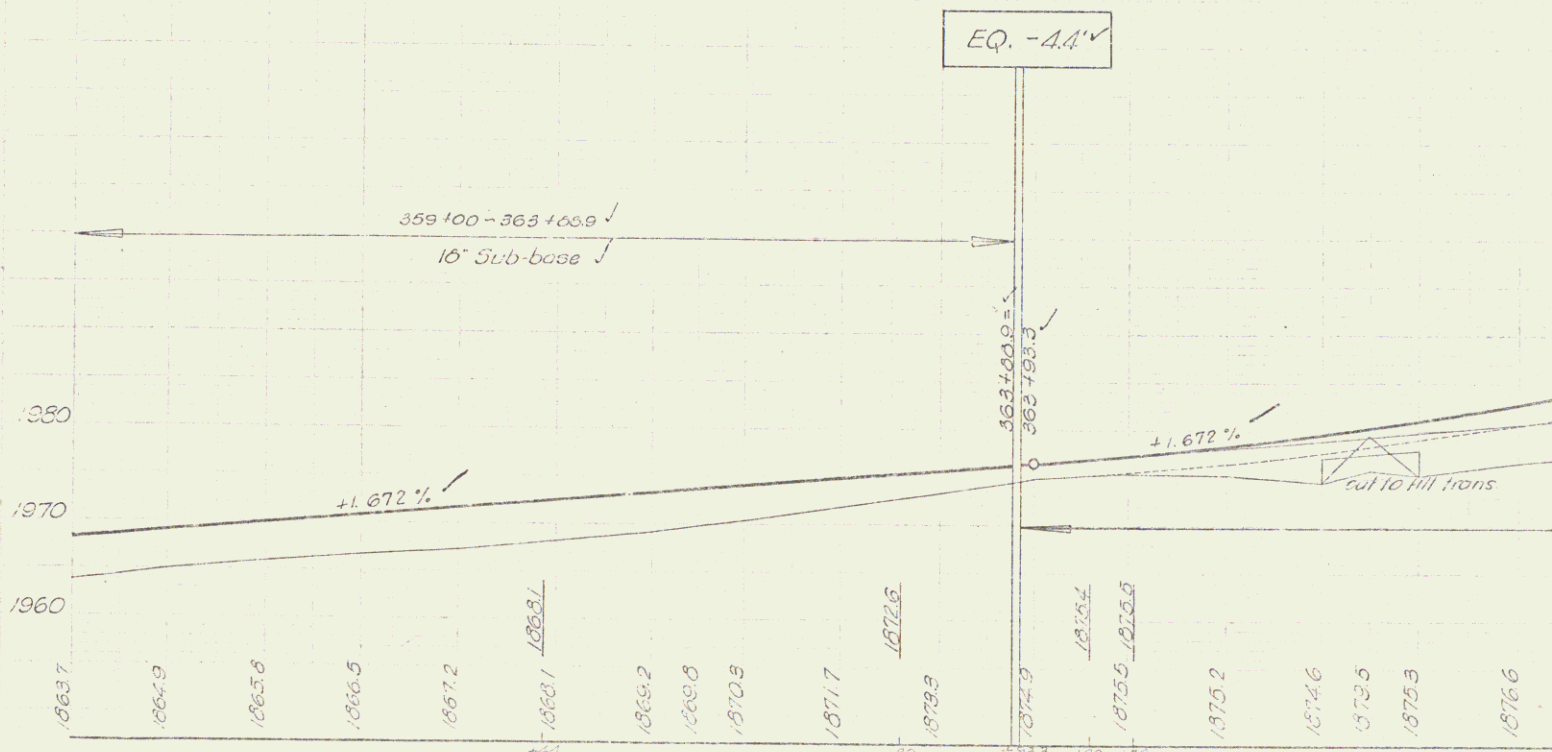

359 +50 360 +50 361 +50 362 +25 +50 363 +50 364 +50 365 +50 366 +50

BM # 61 SIR 12" hem 49' rt sta 362+7.4 elev 1866.09
 BM # 62 SIR 12" hem 47' rt sta 368+02 elev 1866.75
 BM # 63 SIR 12" spr 125' rt sta 369+45 elev 1866.05
 BM # 64 SIR 12" hem 61' rt sta 374+36 elev 1875.8748
 BM # 61.4 SIR 12" hem 66' lt sta 362+27 elev 1872.03