


~~10' Maple~~
~~2007-92~~

~~10' Maple~~
~~2025-49~~

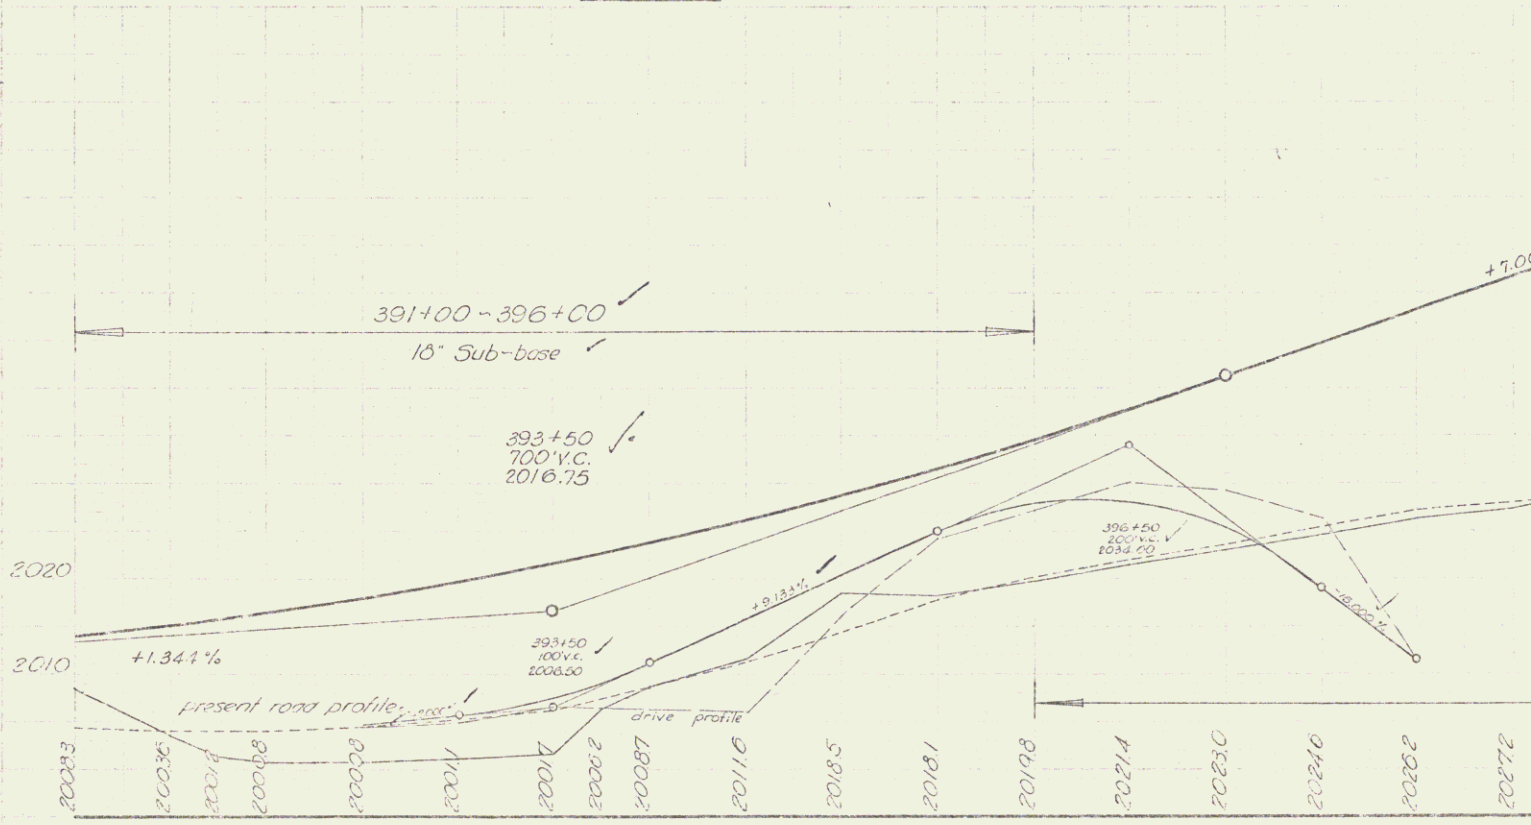

391 392 393 394 395 396 397 398

~~BT 69 STR 10 maple 75' 11" 510 394+35 elev 2007-92~~ ~~BT 77 STR 12 75 43 21' 510 401+22 elev 2010-08~~

~~BT 70 STR 10 maple 72' 11" 510 398+11 elev 2025-49~~ ~~BT 72 STR 33 80 oak 72' 21" 510 412+75 elev 2009-08~~