



DEMOLITION & REMOVAL OF BUILDINGS, ITEM 586
174+35 RT
182+50 L

CONSTRUCT DRIVE
175+50 LT & RT
182+50 L

THREE CABLE GUARD RAIL WITH STEEL POSTS, ITEM 543
170+00-171+66 RT
171+34-171+66 LT
172+36-172+38 RT
173+08-173+32 LT
174+55-174+73 REV
174+91-176+27 LT
176+71-184+80 LT

PLANK GUARD RAIL
176+50 Lt 16'

#20 GEORGE H. & SARAH E. STEVENS
(A.2.75) STA 173+53-184+32
CULVERT RIGHTS STA 182+00, 178+50
COND 12/4/59
REC BRIDGEWATER

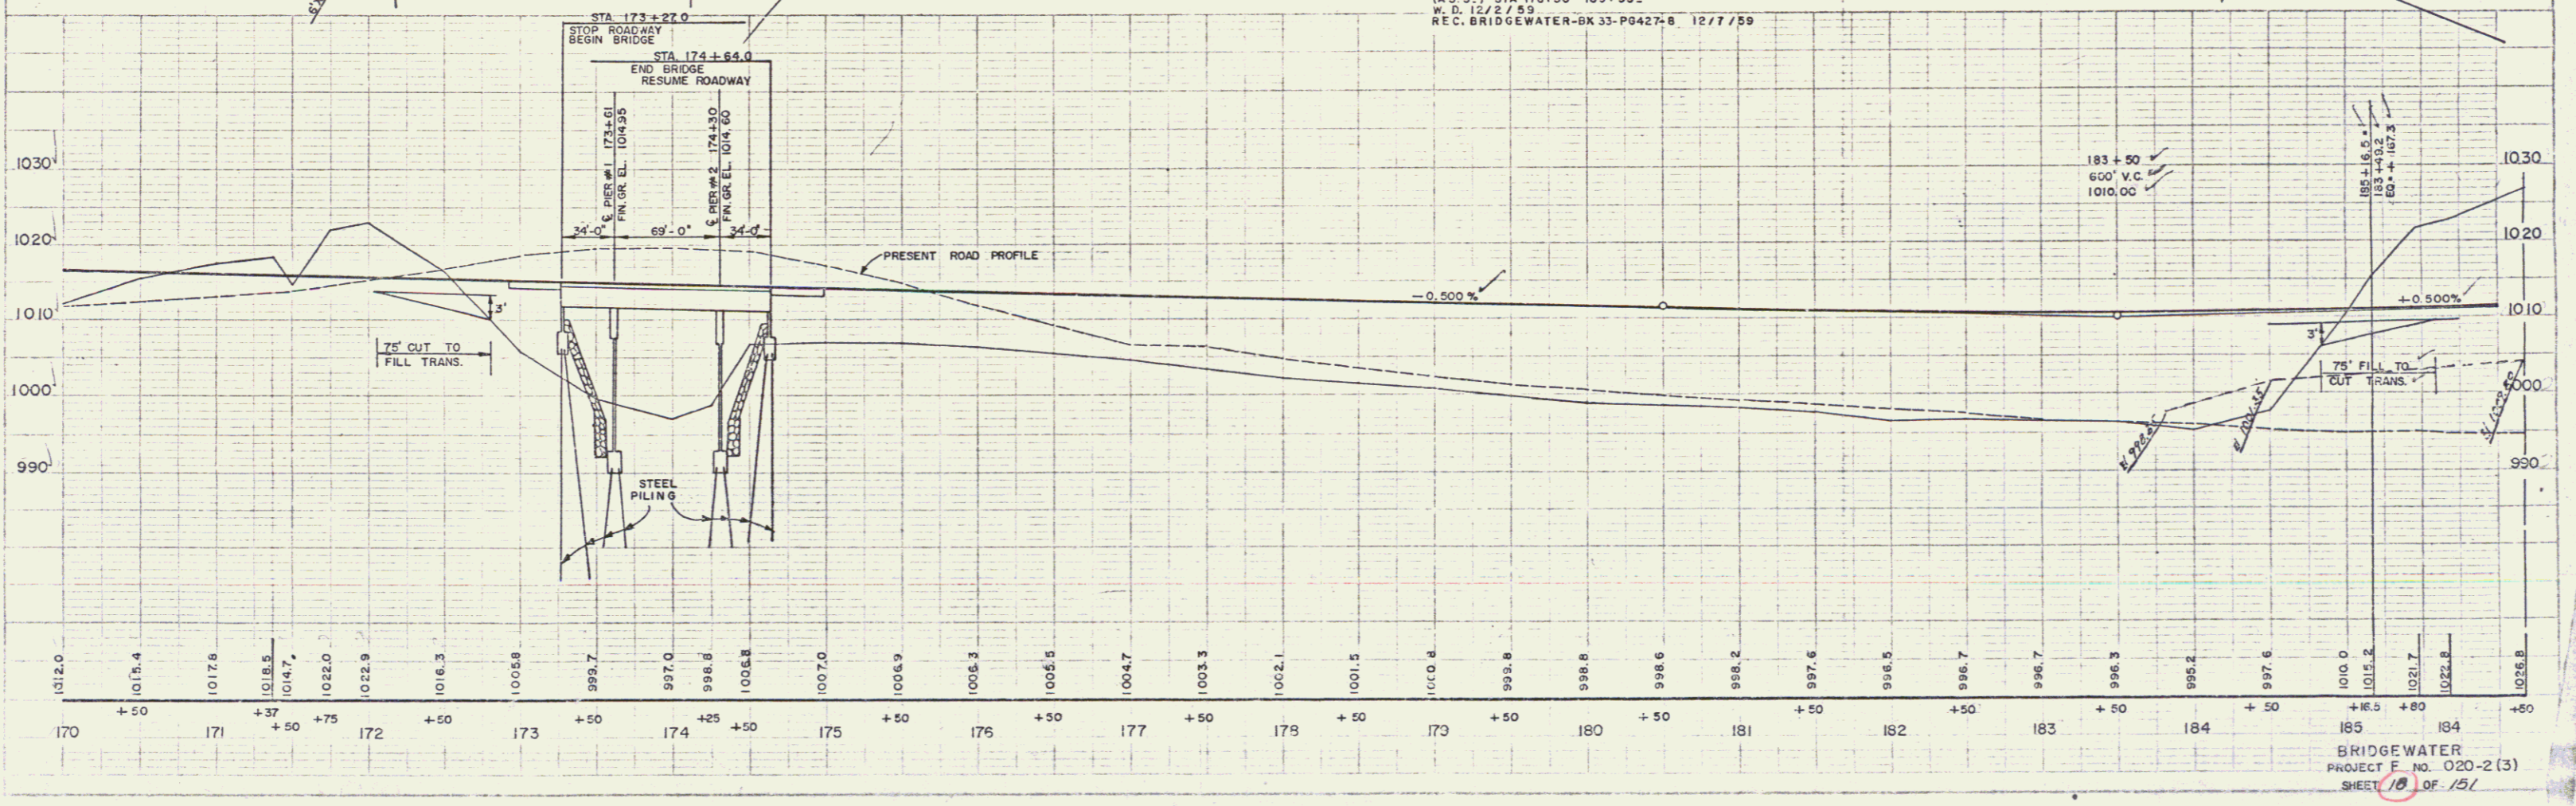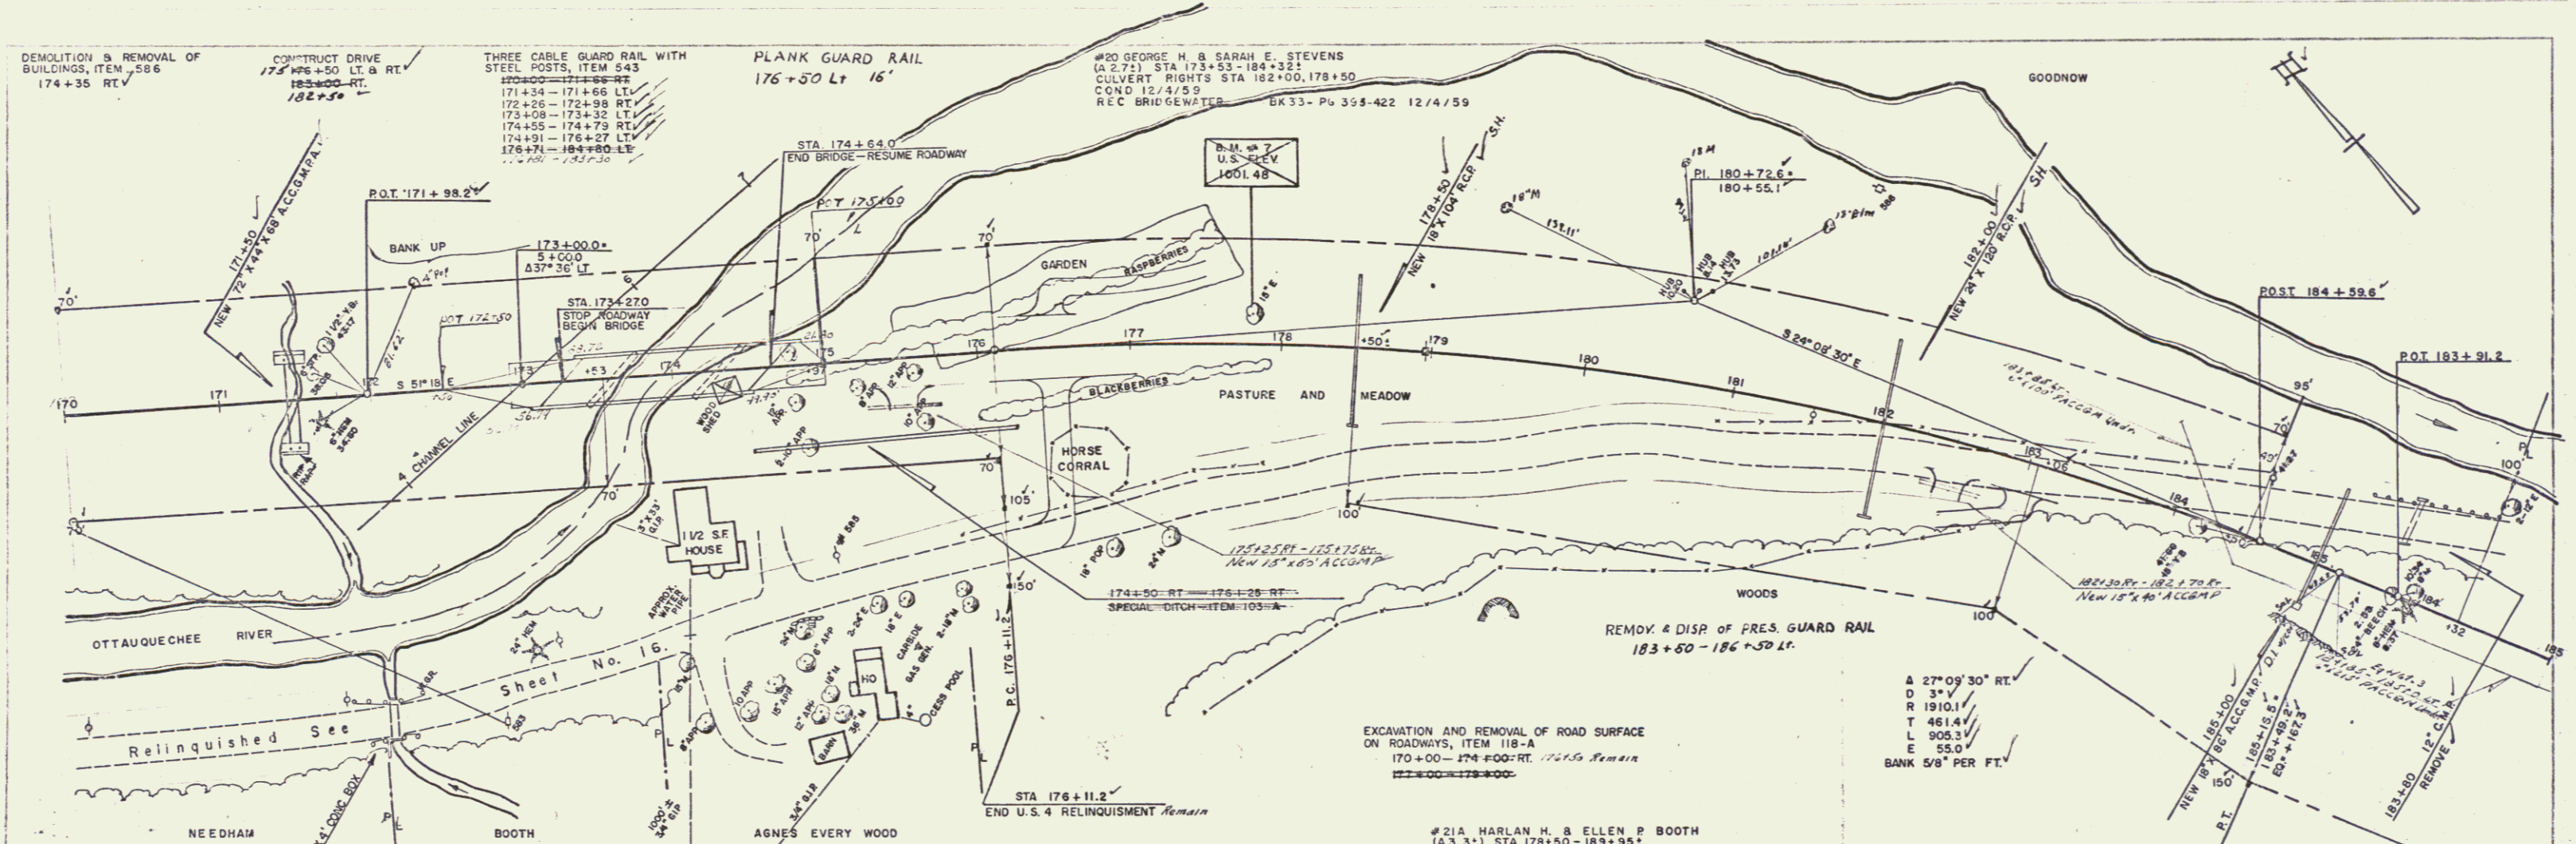

BRIDGEWATER
PROJECT E. NO. 020-2(3)
SHEET 10 OF 15

9