


INDEX OF SHEETS

SHEET NO 1	TITLE PAGE
2	TYPICAL CROSS-SECTION OF IMPROVEMENT 8" BITUMINOUS CONCRETE PAVEMENT, ITEM 241-B MOD.
3	QUANTITY SHEET (ITEMS)
4	QUANTITY SHEET (DRAINAGE)
5-7	EARTHWORK SHEETS
8-24	PLAN AND PROFILE SHEETS
25	DETAILS OF 7 1/2" C.G.M.P.P. (STA. 238+07.5)
26	A-61 DRILLING AND BLASTING OF SOLID ROCK SUBGRADE
27	B-1 BANKING TABLES
28	B-5 TYPICAL SLOPE GRADING
29	B-12 SIDE ROAD INTERSECTION
30	B-13 DRIVES
31	D-1 PRECAST R.C.P. DROP INLETS
32	D-2 CEMENT RUBBLE MASONRY
33	D-4 FLUSHING BASINS
34	E-1 BARRICADES, SIGNS AND LIGHTS
35	E-9 FEDERAL AID CONSTRUCTION IDENTIFICATION SIGNS
36	G-3 THREE CABLE GUARD RAIL WITH STEEL POSTS
37	G-4 MARKER POSTS-PLANK GUARD RAIL
38	J-1 PROJECT AND BOUNDARY MARKERS
39	PRELIMINARY INFORMATION SHEET (BRIDGE AT STA. 223+60.5)
40	GENERAL PLAN ELEVATION, PROFILE & SECTIONS
41	BORING LOGS, FRAMING PLAN AND SECTION
42	DETAILS OF ABUTMENT NO. 1
43	DETAILS OF ABUTMENT NO. 2
44	DETAILS OF ABUTMENT NO. 2
45	APPROACH SLAB
46	REINFORCING STEEL SCHEDULE
47	PRELIMINARY INFORMATION SHEET (BRIDGE AT STA. 255+50)
48	GENERAL PLAN ELEVATION, PROFILES AND SECTIONS
49	BORING LOGS, FRAMING PLAN AND SECTIONS
50	DETAILS OF ABUTMENT NO. 1
51	DETAILS OF ABUTMENT NO. 2
52	DETAILS OF PIER
53	APPROACH SLAB
54	REINFORCING STEEL SCHEDULE
55	SCB-30-58 (SHEET 1) SUPERSTRUCTURE
55A	SCB-30-58 (SHEET 2) SUPERSTRUCTURE
56	SB-56-57 (SHEET 1) BRIDGE RAILING
56A	SB-56-57 (SHEET 2) BRIDGE RAILING
57	SB-20-56 BEARINGS AND DIAPHRAGM
58	SB-45-57 (15° SKEW) APPROACH SLAB
59	SB-45-57 (45° SKEW MOD.) APPROACH SLAB
60	SB-22-58 EXPANSION JOINT DETAILS
61-125	CROSS SECTIONS
126-134	CHANNEL SECTIONS (STA. 223+44.2)
135-141	CHANNEL SECTIONS (STA. 255+06.4)

STATE OF VERMONT
DEPARTMENT OF HIGHWAYS
PROPOSED IMPROVEMENT
FEDERAL AID PROJECT
TOWN OF BRIDGEWATER
COUNTY OF WINDSOR
U.S. ROUTE 4
RUTLAND-WHITE RIVER JCT. ROAD

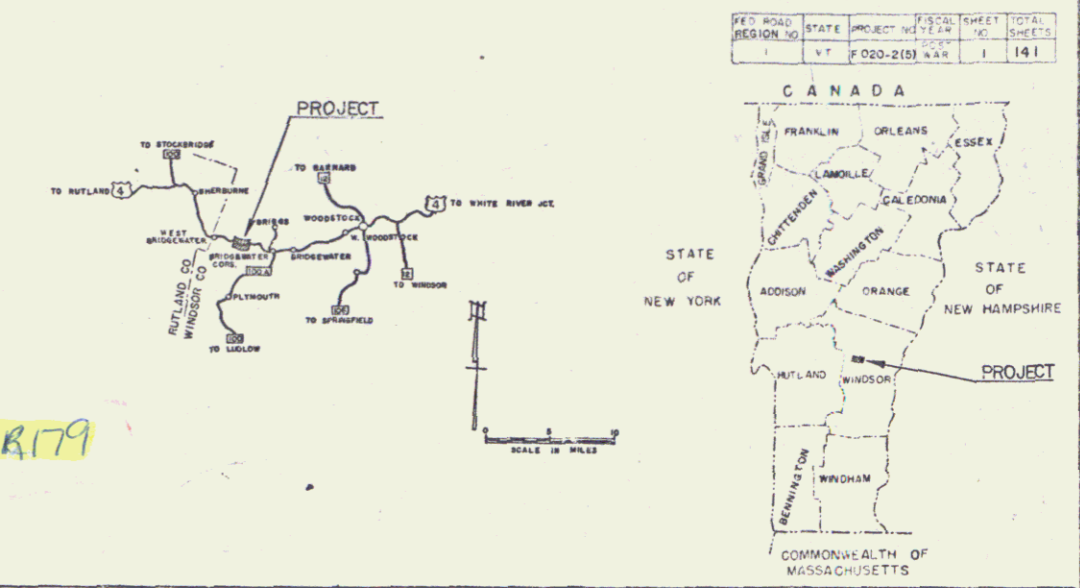

BEGINNING AT A POINT 11,231.1 FEET EASTERLY OF THE
SHERBURNE-BRIDGEWATER TOWN LINE AND EXTENDING
EASTERLY 11,121.3 FEET.

LENGTH OF ROADWAY 10,854.3 FEET = 2.056 MILES
LENGTH OF BRIDGES 267.0 FEET = 0.050 MILE
LENGTH OF PROJECT 11,121.3 FEET = 2.106 MILES


ADT 1960	1300
ADT 1980	2550
DIV 1960	360
D	58%
T	10%
V	50 MPH

PROJECT NAME & NUMBER TYPE PAVEMENT AREA
BRIDGEWATER F 020-2(5) BIT. CONC. PAV'T. 32,536 S.Y.

RECORD PLANS
MATERIALS

GRANULAR BORROW - ERNEST ADAMS - BRIDGEWATER, VERMONT.
SUB-BASE OF GRAVEL & SUB-BASE OF SAND-EDGAR PIT-SHERBURNE, VT.
SUB-BASE OF CRUSHED ROCK & PENETRATION MACADAM CRUSHED STONE
BASE COURSE - FARMERS LIME CO.-BRIDGEWATER, VERMONT.
REFINED TAR & CUTBACK ASPHALT-ALL STATES ASPHALT CO.-SUNDERLAND, MASS.
TAR EMULSION-KOPPER'S CO.-EVERETT, MASS.
ASPHALT CEMENT-ALL STATES ASPHALT CO.-SUNDERLAND, MASS.
BITUMINOUS CONCRETE-L.M. PIKE & SON INC.-WILMINGTON, N.H.
REINFORCING & STRUCTURAL STEEL-BETHLEHEM STEEL CO.-BETHLEHEM, PA.
& STEEL PILING
REINFORCED CONCRETE PIPE-AMERICAN MARIETTA CO.-WINDSOR, VT.
ASPH. CTD. CORR. GALV. METAL PIPE-NEW ENGLAND METAL CULVERT
CO.-WHITE RIVER JUNCTION, VERMONT.
THREE CABLE GUARD RAIL, STEEL GUIDE & MARKER POSTS-
S.T. GRISWOLD & CO. INC.-ESSEX JUNCTION, VT.
BRIDGE RAILING-WARD-WELLER CO. INC.-NEWTON LOWER FALLS,
MASS.
GRANITE BRIDGE CURB-BARRETTO GRANITE-MILFORD, N.H.

CONTRACTOR-S.V. ROSSI CONST. CO. INC. CONTRACT DATED-APRIL 18, 1961.
TORRINGTON, CONN. STARTED-MAY 3, 1961.
RESIDENT ENGINEER-PAUL J. JETTE. COMPLETED-OCTOBER 31, 1962.
INSPECTORS-A. DAVIS, C. HARPAN, E. NEWTON. ACCEPTED-OCTOBER 31, 1962.
B. T. BIRT.
RECORD PLANS-PAUL J. JETTE.

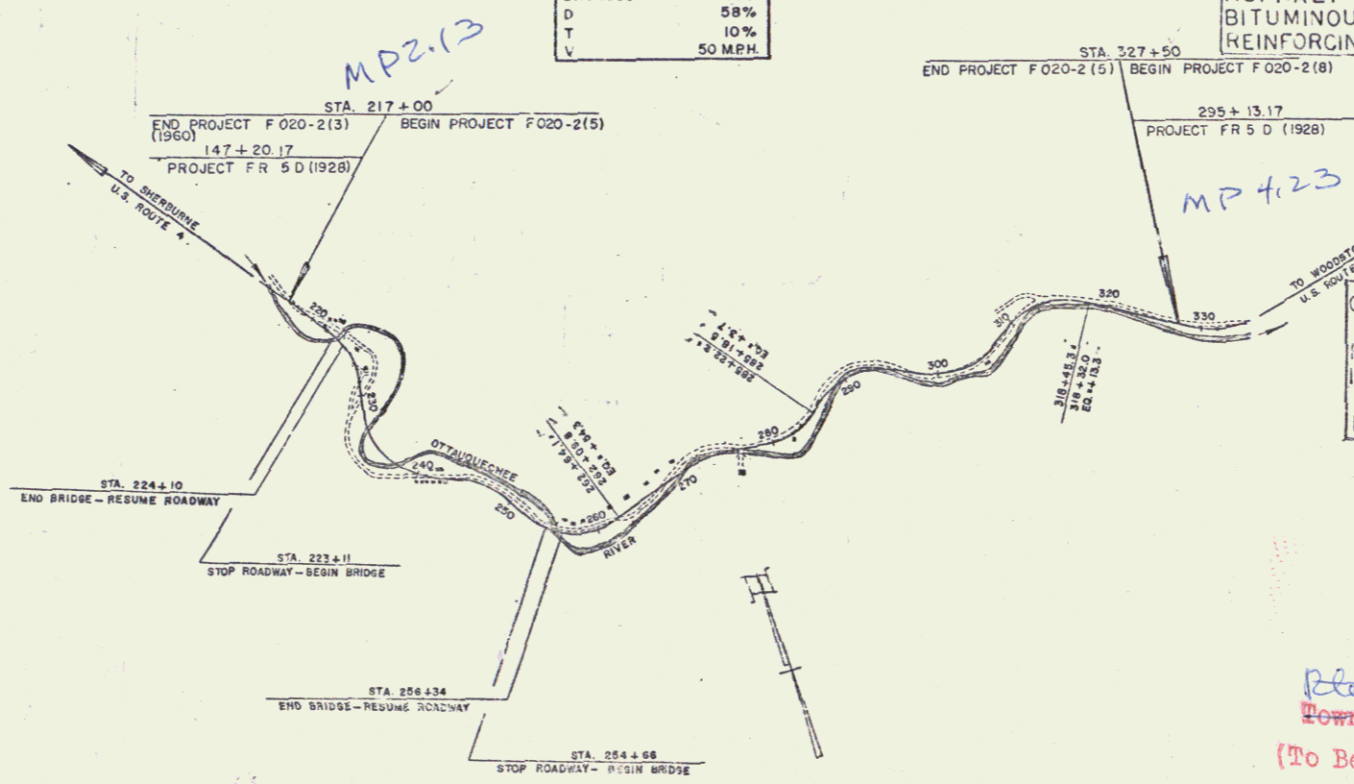

BRIDGEWATER F 020-2(5)
CONTRACTOR-S.V. ROSSI CONSTRUCTION CO. INC.
TORRINGTON, CONN.
RECORD PLANS - PAUL J. JETTE.
CONSTRUCTION COMPLETED-OCTOBER 31, 1962.

RC	TO	DATE
FE	BY	
ST	BY	
UL	BY	
OL	BY	
TR	BY	
RE	BY	
SL	BY	
CL	BY	
PL	BY	
TE	BY	
CE	BY	
DE	BY	
RE	BY	
TE	BY	

SCALES

TITLE	1" = 1000'
TYPICAL	1" = 2'
PLAN	1" = 50'-20"
PROFILE HORIZONTAL	1" = 50'
PROFILE VERTICAL	1" = 10'
CROSS-SECTIONS	1" = 5' @ 10'

RIGHT-OF-WAY DIVISION
TOWN FILE
PERPETUAL
Town of U.S.
(To Be Returned To R.O.W. Division)

THESE PLANS ARE SUBJECT TO SUCH REVISIONS AS MAY BE
REQUIRED BY THE BUREAU OF PUBLIC ROADS OR THE COMMISSIONER
OF HIGHWAYS.
CONSTRUCTION IS TO BE CARRIED ON IN ACCORDANCE WITH
THE PLANS AND THE STANDARD SPECIFICATIONS FOR HIGHWAY AND BRIDGE
CONSTRUCTION OF JANUARY 1956 SUBMITTED TO THE BUREAU OF
PUBLIC ROADS AS APPROVED JULY 5, 1956 INCLUDING ALL SUBSEQUENT
APPROVED REVISIONS AND SUCH REVISION SPECIFICATIONS AND SPECIAL
PROVISIONS AS ARE SUBMITTED WITH THE PLANS.

NOTE: ANY FURTHER INFORMATION CONCERNING
THESE PLANS SHOULD BE OBTAINED FROM THE
ENGINEER. THIS NOTICE IS TO BE KEPT
WITHIN THE FIELD OFFICE OF THE LOCAL
FILE.

APPROVED DATE	APPROVED DATE	APPROVED DATE	APPROVED DATE	APPROVED DATE	APPROVED DATE
DATE 20 Sept 1959	DATE 21 Sept 1959	DATE 25 Sept 1959	DATE 29 Sept 1959	DATE 29 Sept 1959	DATE 29 Sept 1959

PROJECT F NO. 020-2 (5)
SHEET 1 OF 141 SHEETS

MP 2.12
MP 4.23
Bridge Water