


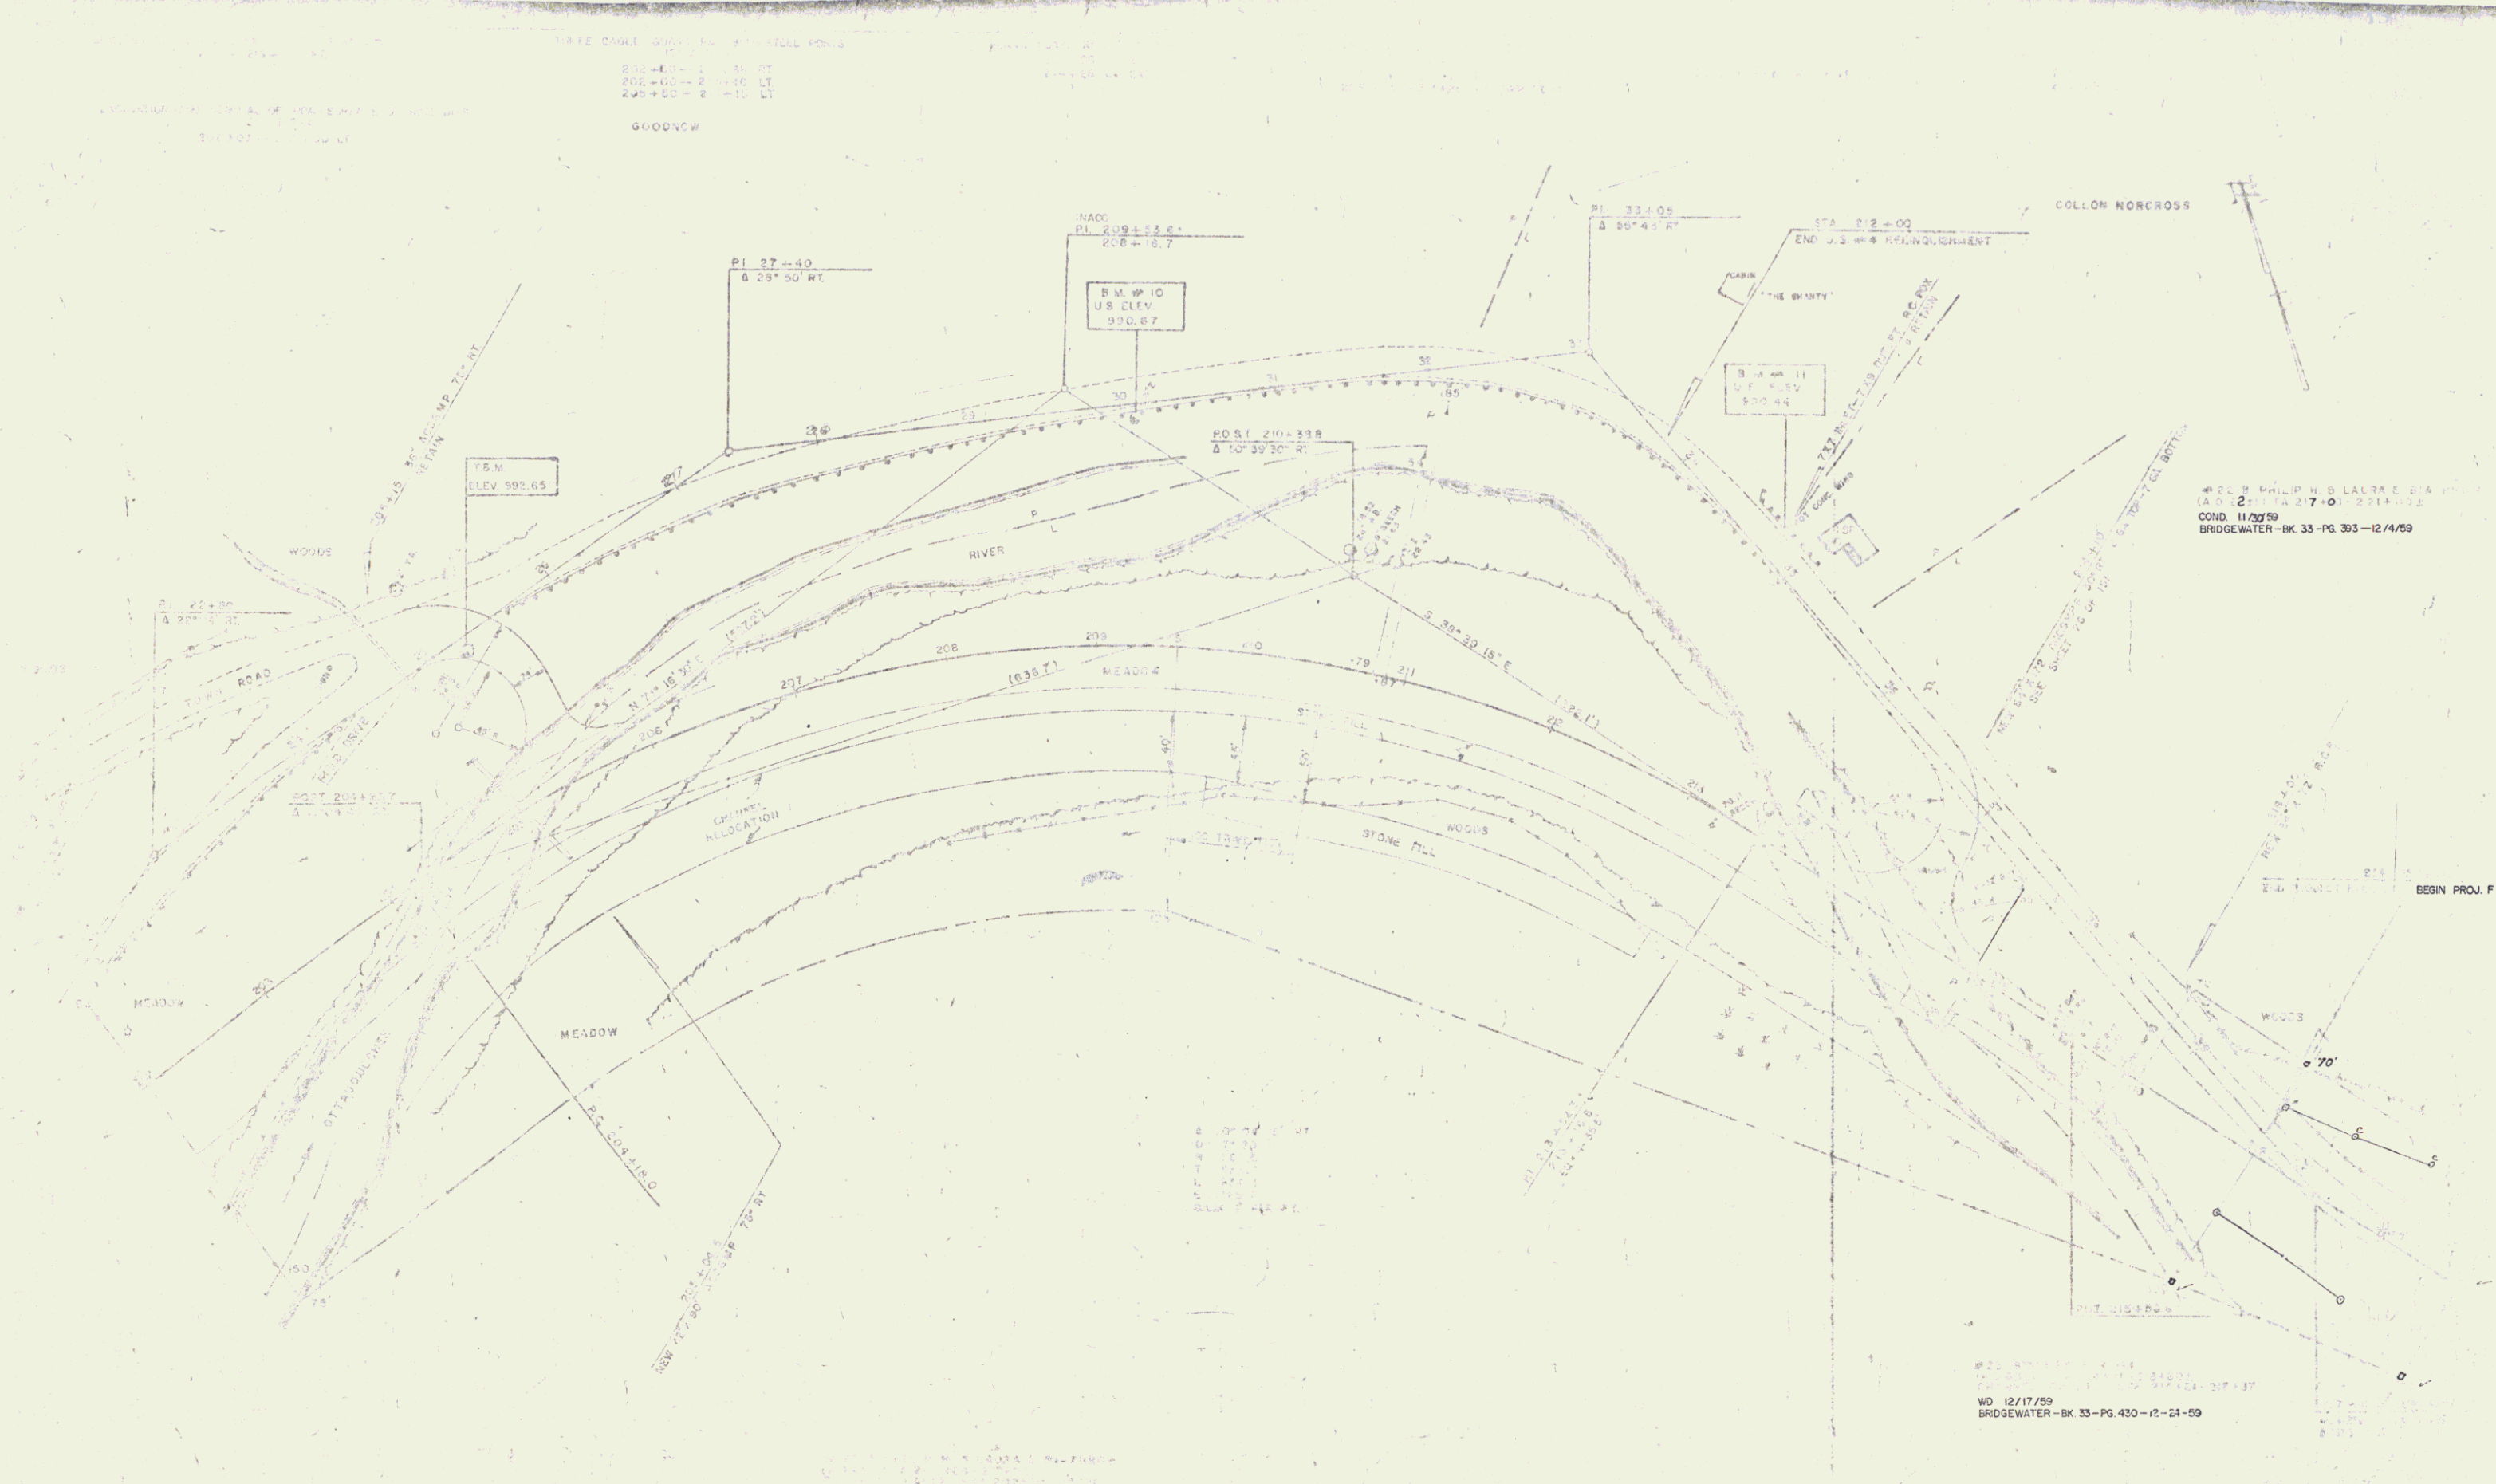

COND. 11/27/59
BRIDGEWATER - BK 33 - PG 393 - 12/4/59

WD 12/17/59
BRIDGEWATER - BK 33 - PG 430 - 12-24-59

BEGIN PROJ. F020-2(5)

020-2 (5)
141