

SURVEYED BY
CALLED BY
9-57
10-30
KALLO
WOODS

EXCAVATION & REMOVAL OF ROAD SURFACE on ROADWAY, Item 118-A
234+00-236+50 Rt. 239+50-240+25 Rt.
242+00-250+00 Lt.

DEMOLITION & REMOVAL of BUILDINGS
Item 586
240+10 Rt. No. 5
240+70 Rt. No. 6
240+85 Rt. No. 7
241+20 Rt. No. 8
241+50 Rt. No. 9
242+30 Rt. No. 11
242+80 Rt. No. 12

REMOVAL & DISPOSAL OF PRESENT GUARD RAIL, ITEM 550
18+05 - 21+80 S. L.
244+01 - 244+60
245+28 - 248+71

CONSTRUCT BARRICADE, Item 541-A
246+00-247
247+00 Lt.

UNCLASSIFIED CHANNEL EXCAVATION
Item 106-C
234+00 - 238+25 Lt.

CONSTRUCT DRIVES
LT. RT.
241+50 238+00


DRILLING & BLASTING of SOLID ROCK SUBGRADE, Item 114, Mod.
247+00 - 250+00
245+00 - 245+40
STONE FILL FOR SLOPE PROTECTION
Item 522 245+00
244+00 - 245+40
235+50 - 238+40

THREE CABLE GUARD RAIL w/STEEL POSTS, Item 543
234+00 - 238+25 Lt. 235+14
234+00 - 238+30 Rt.
237+11 - 238+75 Lt. 245+05-248+10

STEEL GUIDE POSTS
243+10 - 261+50 Lt.

Δ 75° 20' Lt.
D 74' 30"
R 768.5
T 590.2
L 1004.4
E 201.3
Bank 1' per ft.

POST 241+29.0 =
28+05.2 SIDELINE
Δ 5° 30' Rt.

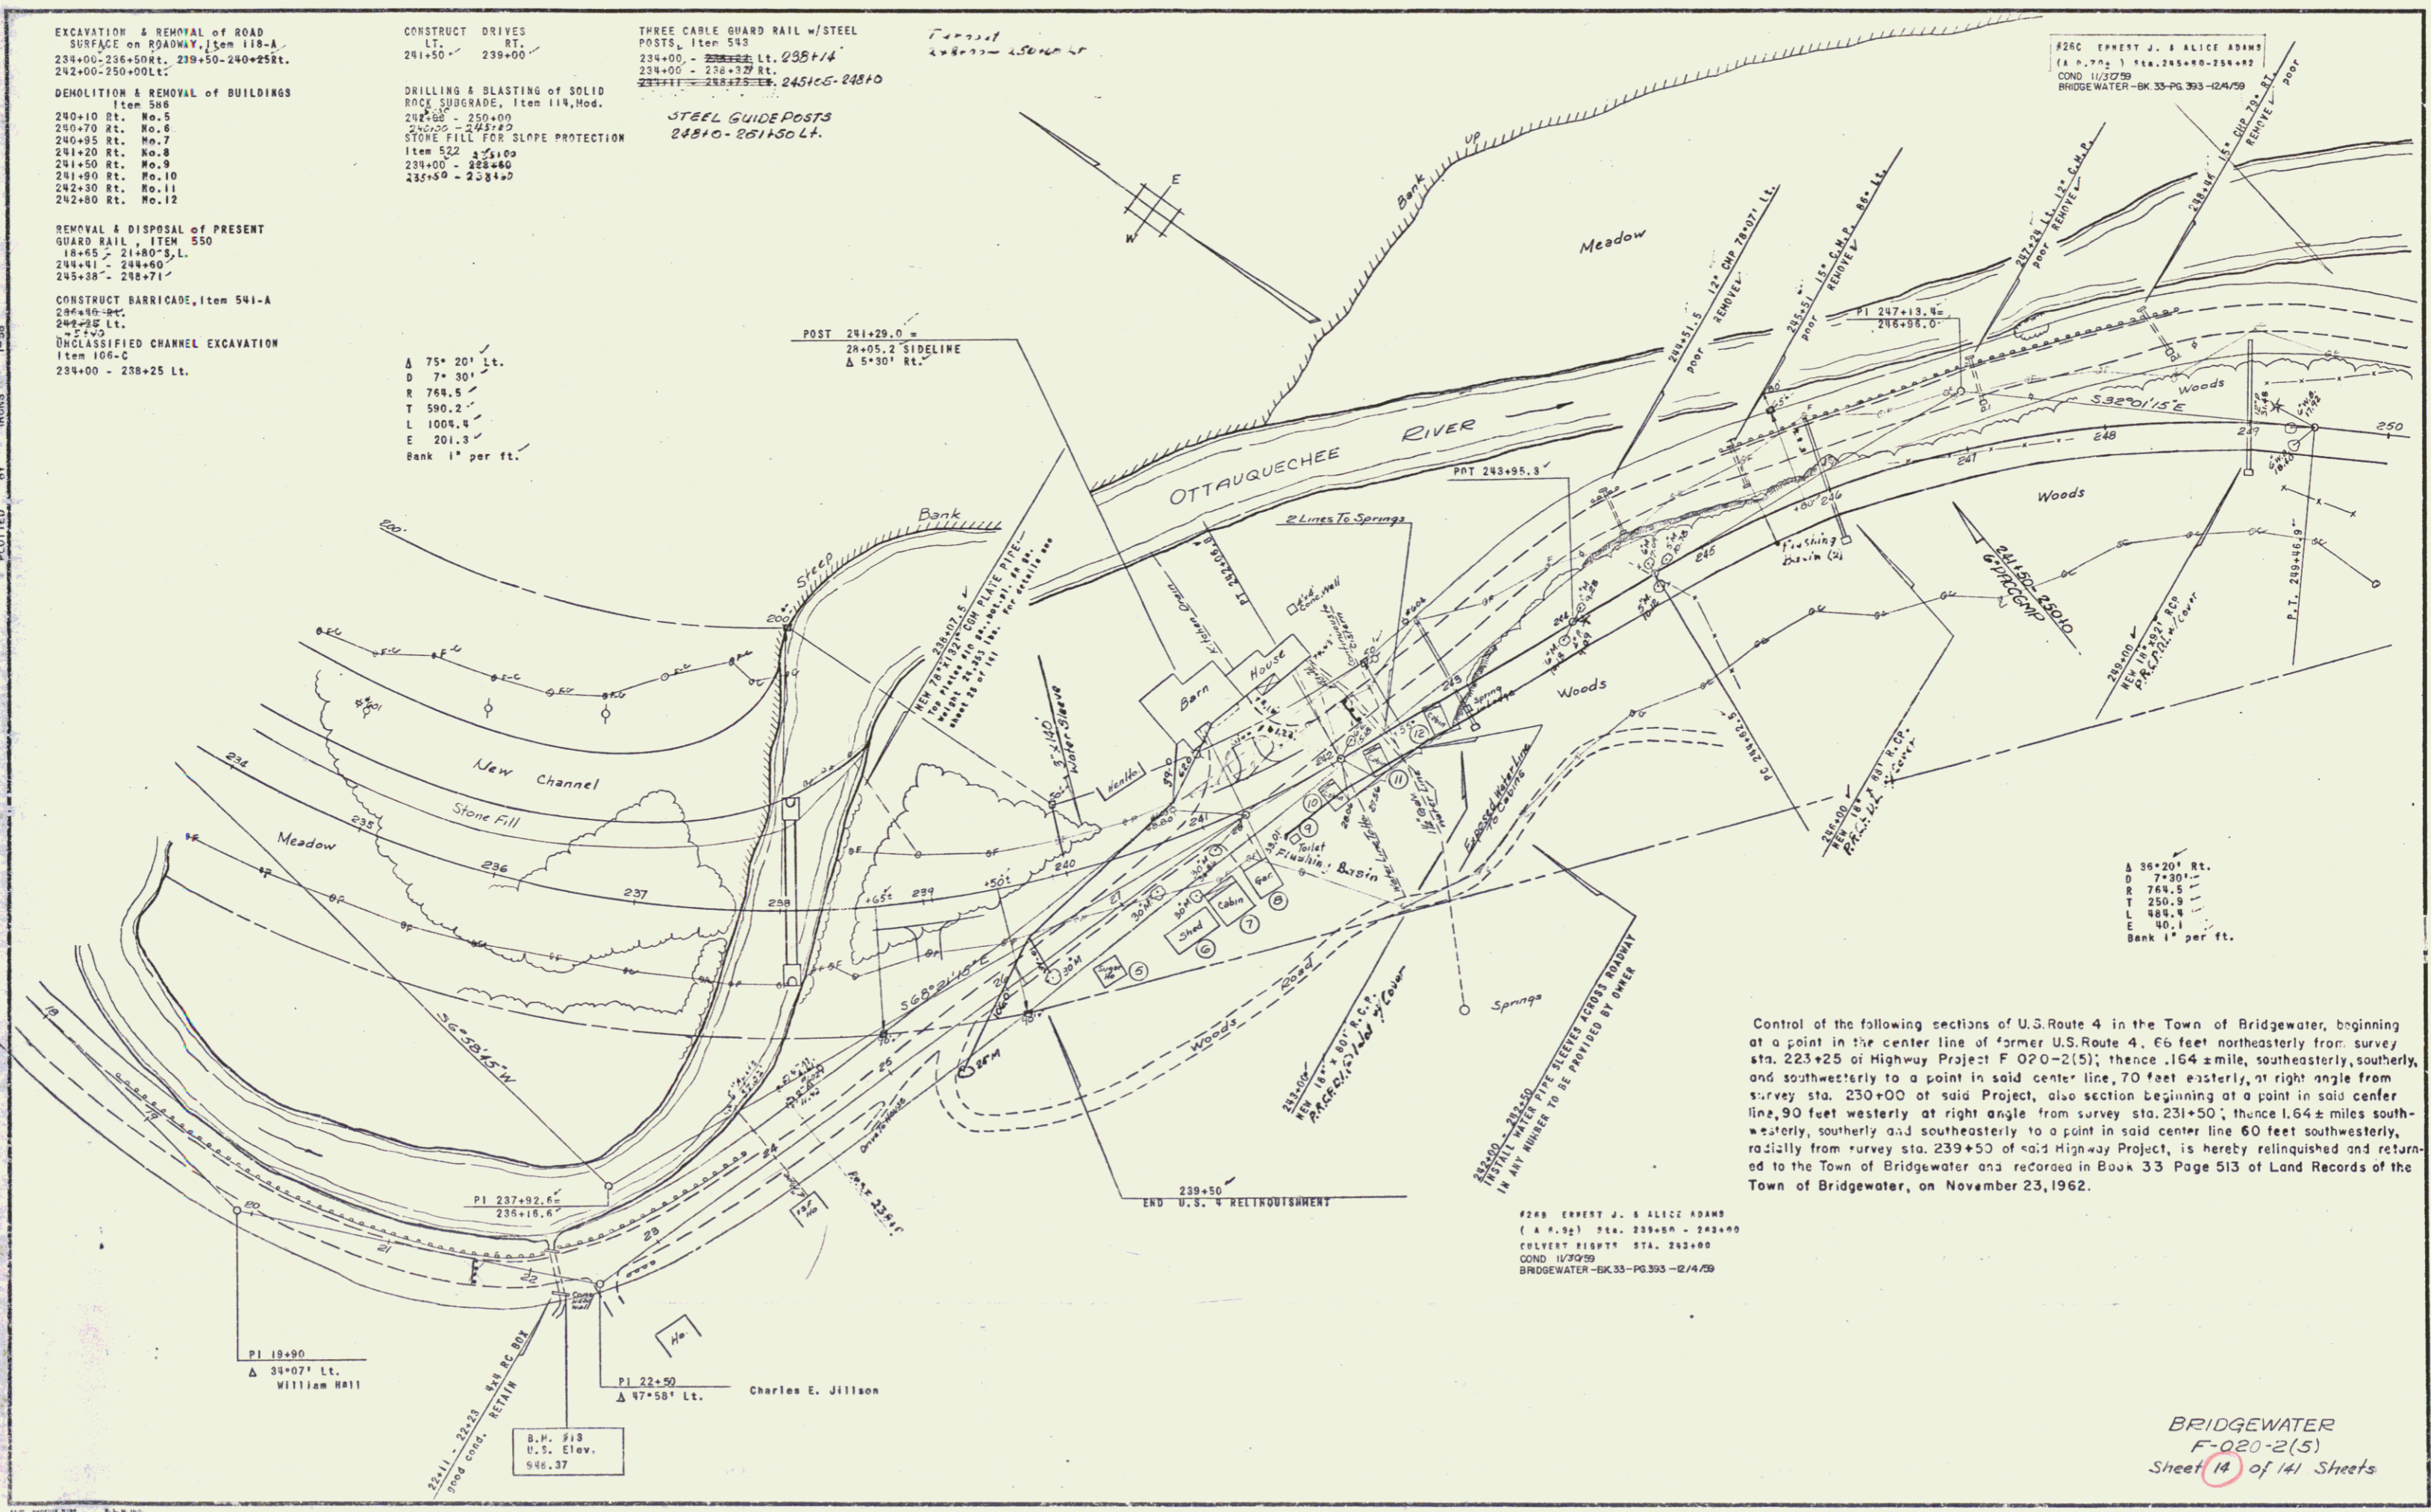

Control of the following sections of U.S. Route 4 in the Town of Bridgewater, beginning at a point in the center line of former U.S. Route 4, 66 feet northeasterly from survey sta. 223+25 of Highway Project F-020-2(5); thence 164 ± miles, southeasterly, southerly, and southwesterly to a point in said center line, 70 feet easterly, at right angle from survey sta. 230+00 of said Project, also section beginning at a point in said center line, 90 feet westerly at right angle from survey sta. 231+50; thence 1.64 ± miles southwesterly, southerly and southeasterly to a point in said center line 60 feet southwesterly, radially from survey sta. 239+50 of said Highway Project, is hereby relinquished and returned to the Town of Bridgewater and recorded in Book 33 Page 513 of Land Records of the Town of Bridgewater, on November 23, 1962.

#260 ERBERT J. & ALICE ADAMS
(A.P. 92) PTA. 239+50 - 242+00
COLVERT RIGHTWAY STA. 242+00
COND. 11/27/59
BRIDGEWATER-BK 33-PG 513-2/4/59

BRIDGEWATER
F-020-2(5)
Sheet 14 of 141 Sheets