
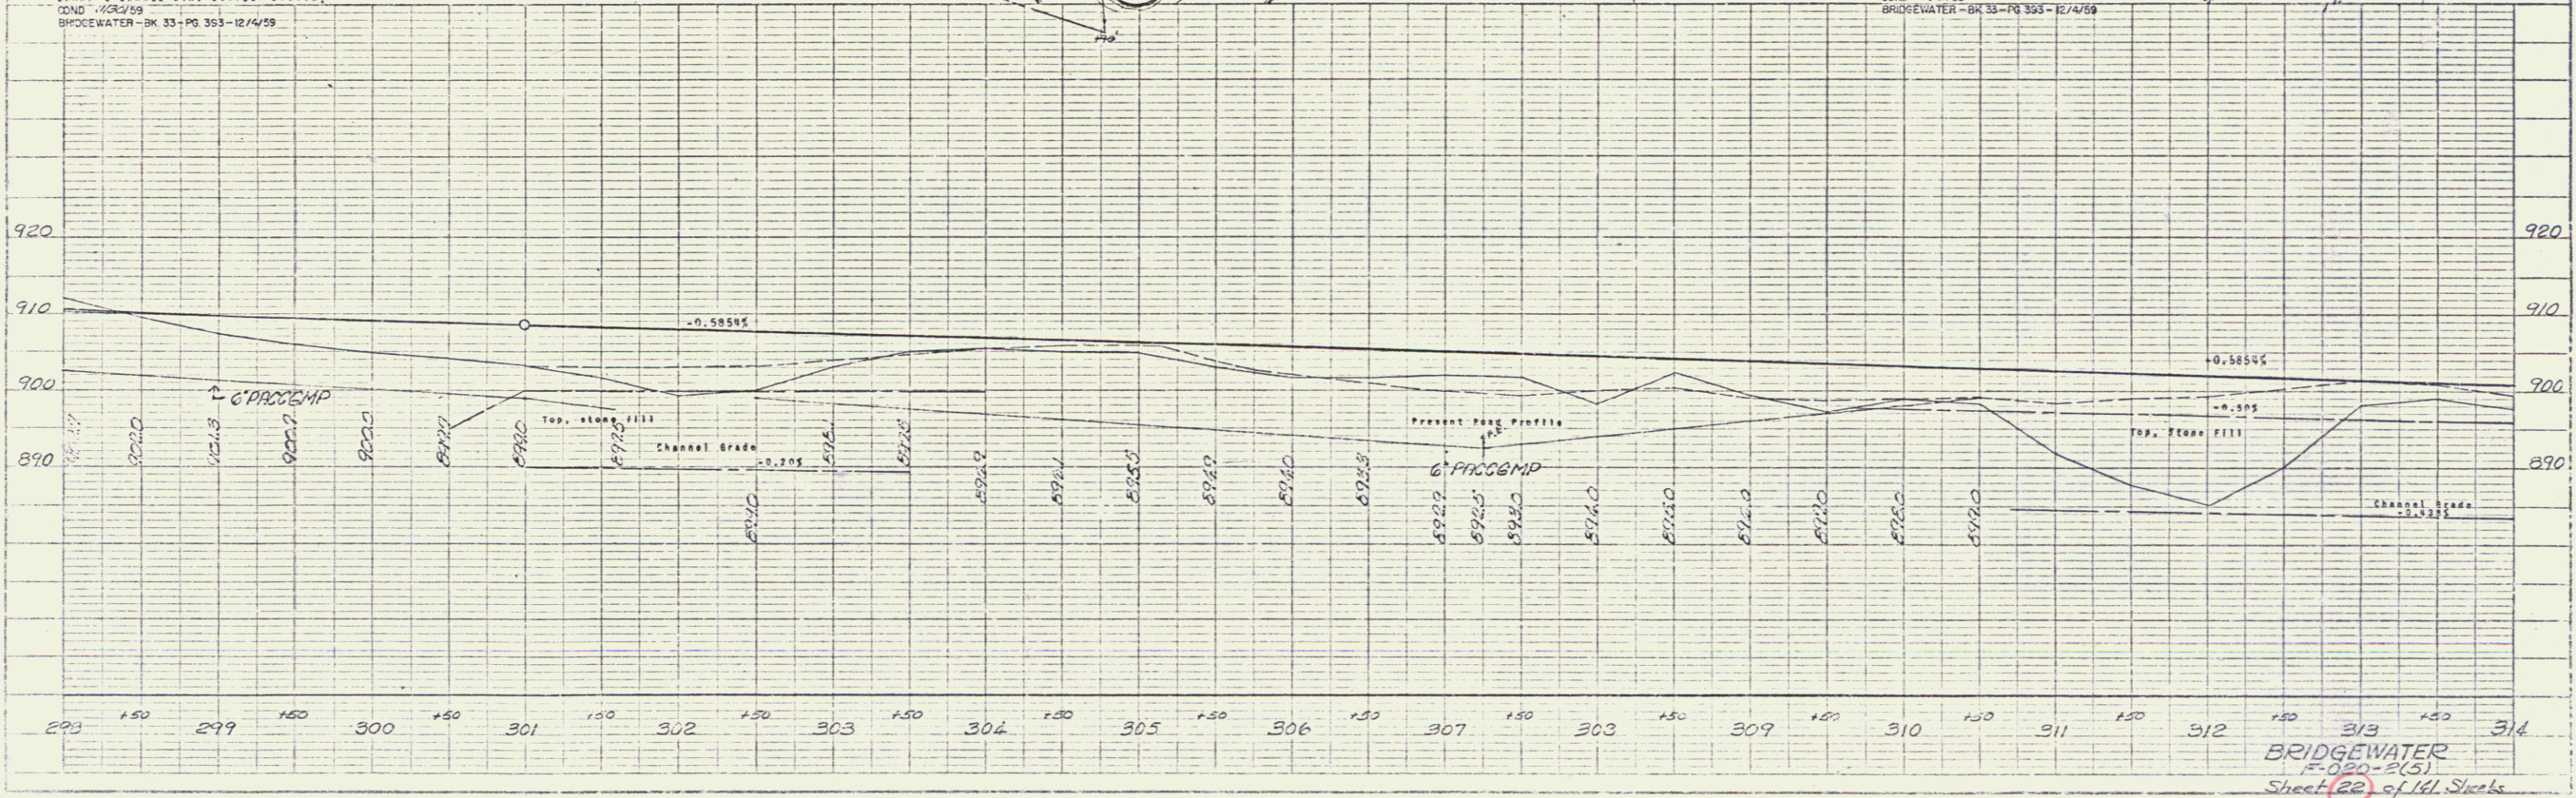


PLAN
 PANELLO-KO
 ENELL
 11-57
 11-58
 NOTE: REVISIONS TO BE MADE BY THE CONTRACTOR

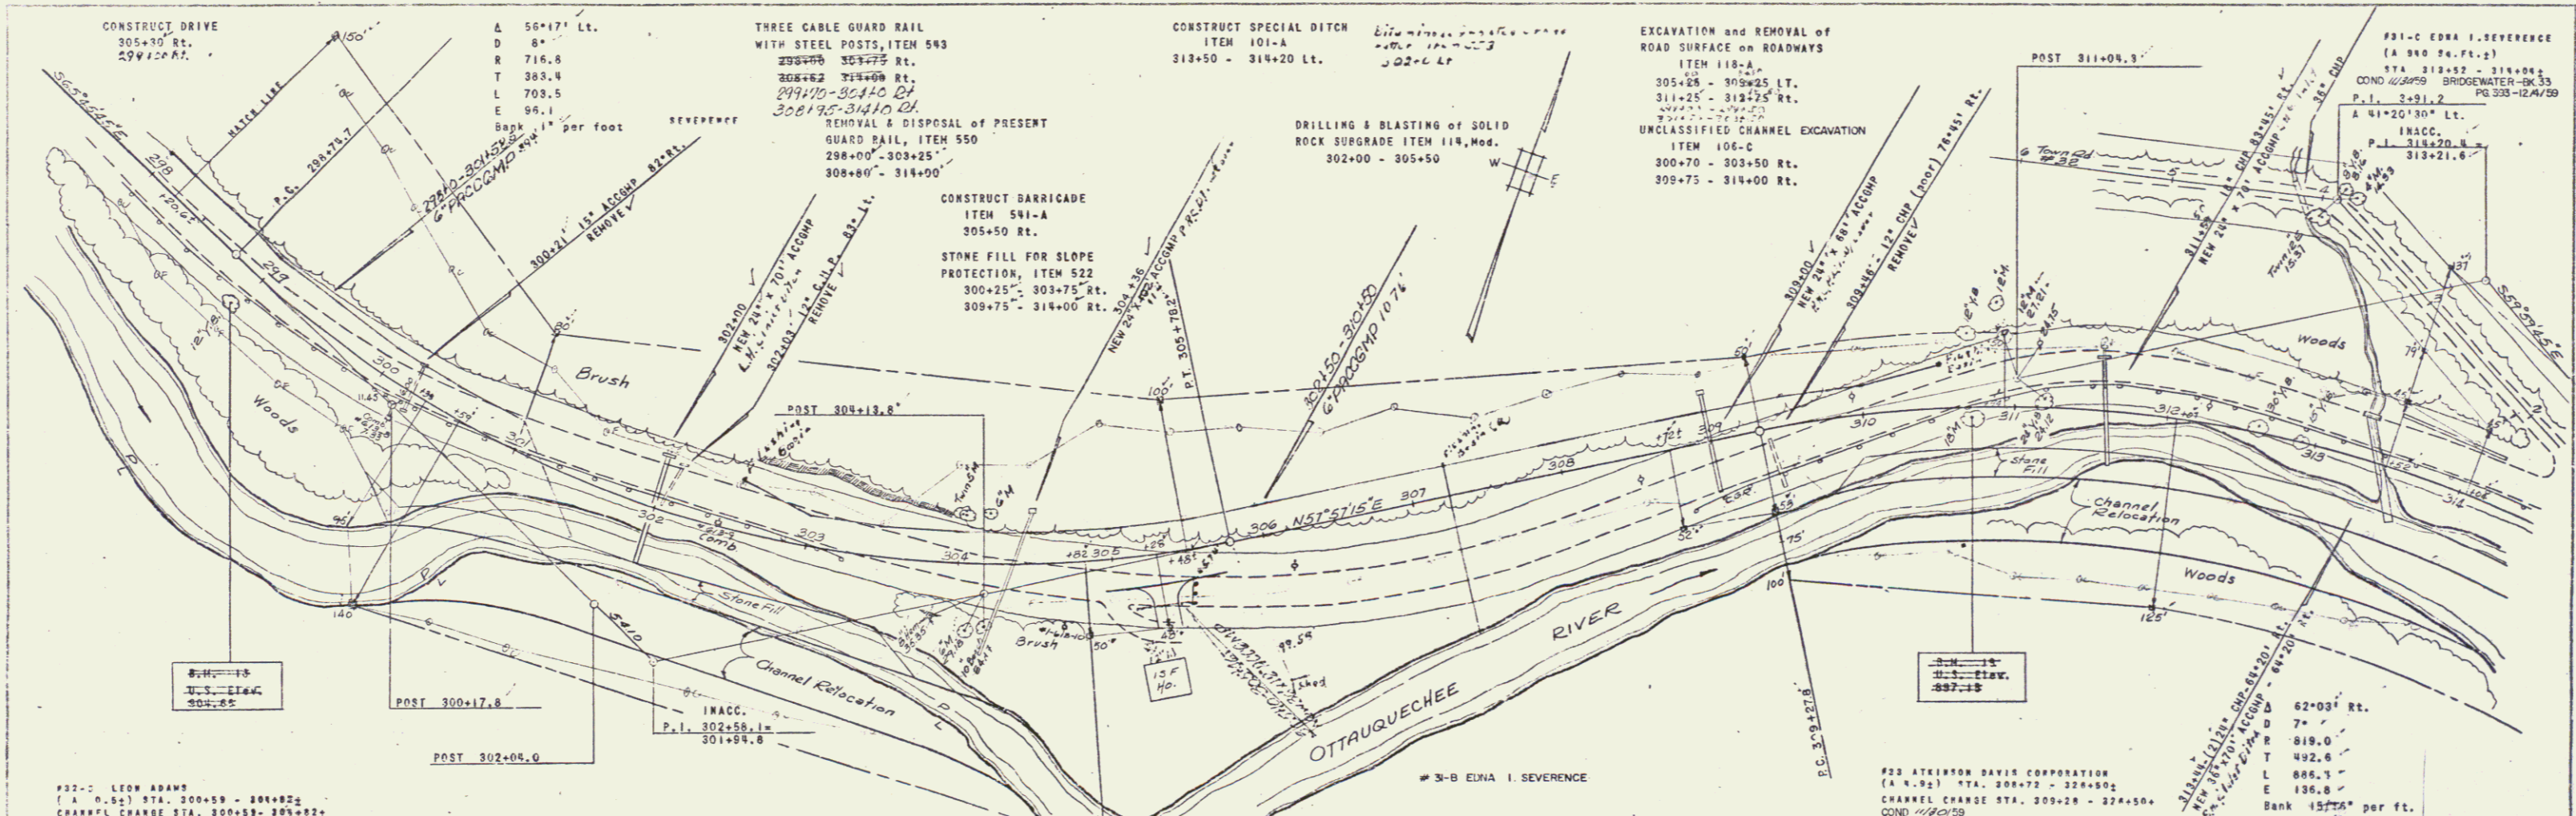

#32-C LEON ADAMS
 (A 0-52) STA. 300+50 - 304+00
 CHANNEL CHANGE STA. 300+50 - 304+00
 COND. 11/2/59
 BRIDGEWATER - BK 33 - PG 353 - 12/14/59

#33 ATHERTON DAVIS CORPORATION
 (A 4-92) STA. 300+70 - 324+00
 CHANNEL CHANGE STA. 309+20 - 324+50
 COND. 11/2/59
 BRIDGEWATER - BK 33 - PG 305 - 12/14/59

BRIDGEWATER
 F-020-2(5)
 Sheet (22) of 141 Sheets

10