

Seeding, Topsoil & Commercial Fertilizer, Item 561
 401+50 - 14 10 hp RT
 1 1/2" - 2 1/4" pp RT
 2 1/2" - 1 1/2" pp LT
 0+90 - 403+00 RT
 403+05 - 404+17 LT
 404+33 - 405+52 RT
 405+68 - 406+52 LT
 406+68 - 407+00 RT

Construct Drives
 LT RA
 398+70
 400+35
 405+60
 407+25
 407+40
 399+55
 400+65
 406+59
 407+40

THREE CABLE GUARD RAIL WITH STEEL POSTS, ITEM 543
 SEE BELOW
 Plank Guard Rail Item 541-A
 399+55 - 400+35
 400+35 - 405+60
 405+60 - 407+25
 PEARL E. & MAE E. BAKER 407+25 L

Demolition and Removal of Buildings Item 586
 403+10 Lt No 7
 403+15 Lt No 8
 406+00 Lt No 9
 407-75 Lt No 10
 Drilling & Blasting of 5 1/2" Cast
 401+25 - 401+50
 401+50 - 401+50
 401+50 - 401+50
 401+50 - 401+50

#538 HAROLD W. & ANNIE B. MINER
 (ASUR) STA 408+06 - 408+58
 (REC. SEE PARCEL A)
 Present Guard Rail Item 550
 398+68 - 399+15 Lt 19
 400+68 - 401+00 Lt 19


#440 EAR. H. B. DORIS MARTIN
 (ASUR) STA 392+05 - 400+16
 (REC. SEE PARCEL A)
 Construct Drives
 Side Road 402+73 ML: 0100
 LT RA
 1+14
 2+17
 2+17

THREE CABLE GUARD RAIL WITH STEEL POSTS, ITEM 543
 408+08 - 408+140 L
 408+157 - 410+00 R
 TITLE TAKEN: COND. 11/13/72
 RECORDED: BRIDGEWATER BK 36 PG 333
 11/17/72

PARCEL 60
 MAE E. BAKER ESTATE
 398+80 LT - 400+82 LT (O.H.A.L.)
 TITLE: ADMIN. DEED 11/13/72
 RECORDED - BRIDGEWATER - BK 36 PG 333
 11/17/72

#518 EDWIN R. & JULIA H. VAUGHAN
 (ASUR) STA 402+89 - 404+52
 (REC. SEE PARCEL A)
 TITLE TAKEN: COND. 12/4/59
 RECORDED: BRIDGEWATER BK 33 PG 393-422
 12/4/59

#518 HAROLD W. & ANNIE B. MINER
 (ASUR) STA 406+10 - 423+45
 (REC. SEE PARCEL A)
 Present Guard Rail Item 550
 398+68 - 399+15 Lt 19
 400+68 - 401+00 Lt 19

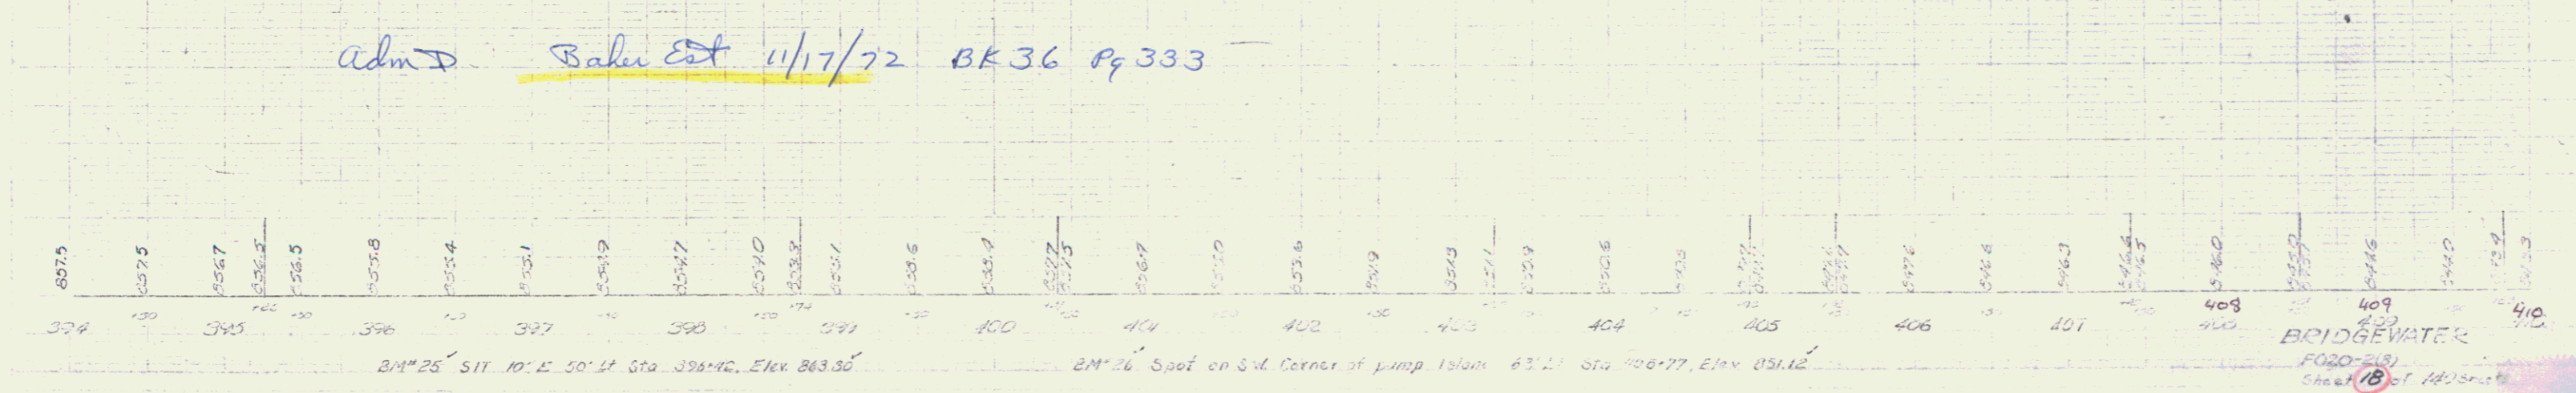

BM#25 SIT. 10' E. 50' Lt Sta. 398+16, Elev. 863.30
 BM#26 Spot on S.W. Corner of pump island 63' Lt Sta. 406+77, Elev. 851.12
 BRIDGEWATER
 F020-281
 Sheet 18 of 143 sheets
 10