


For Plan

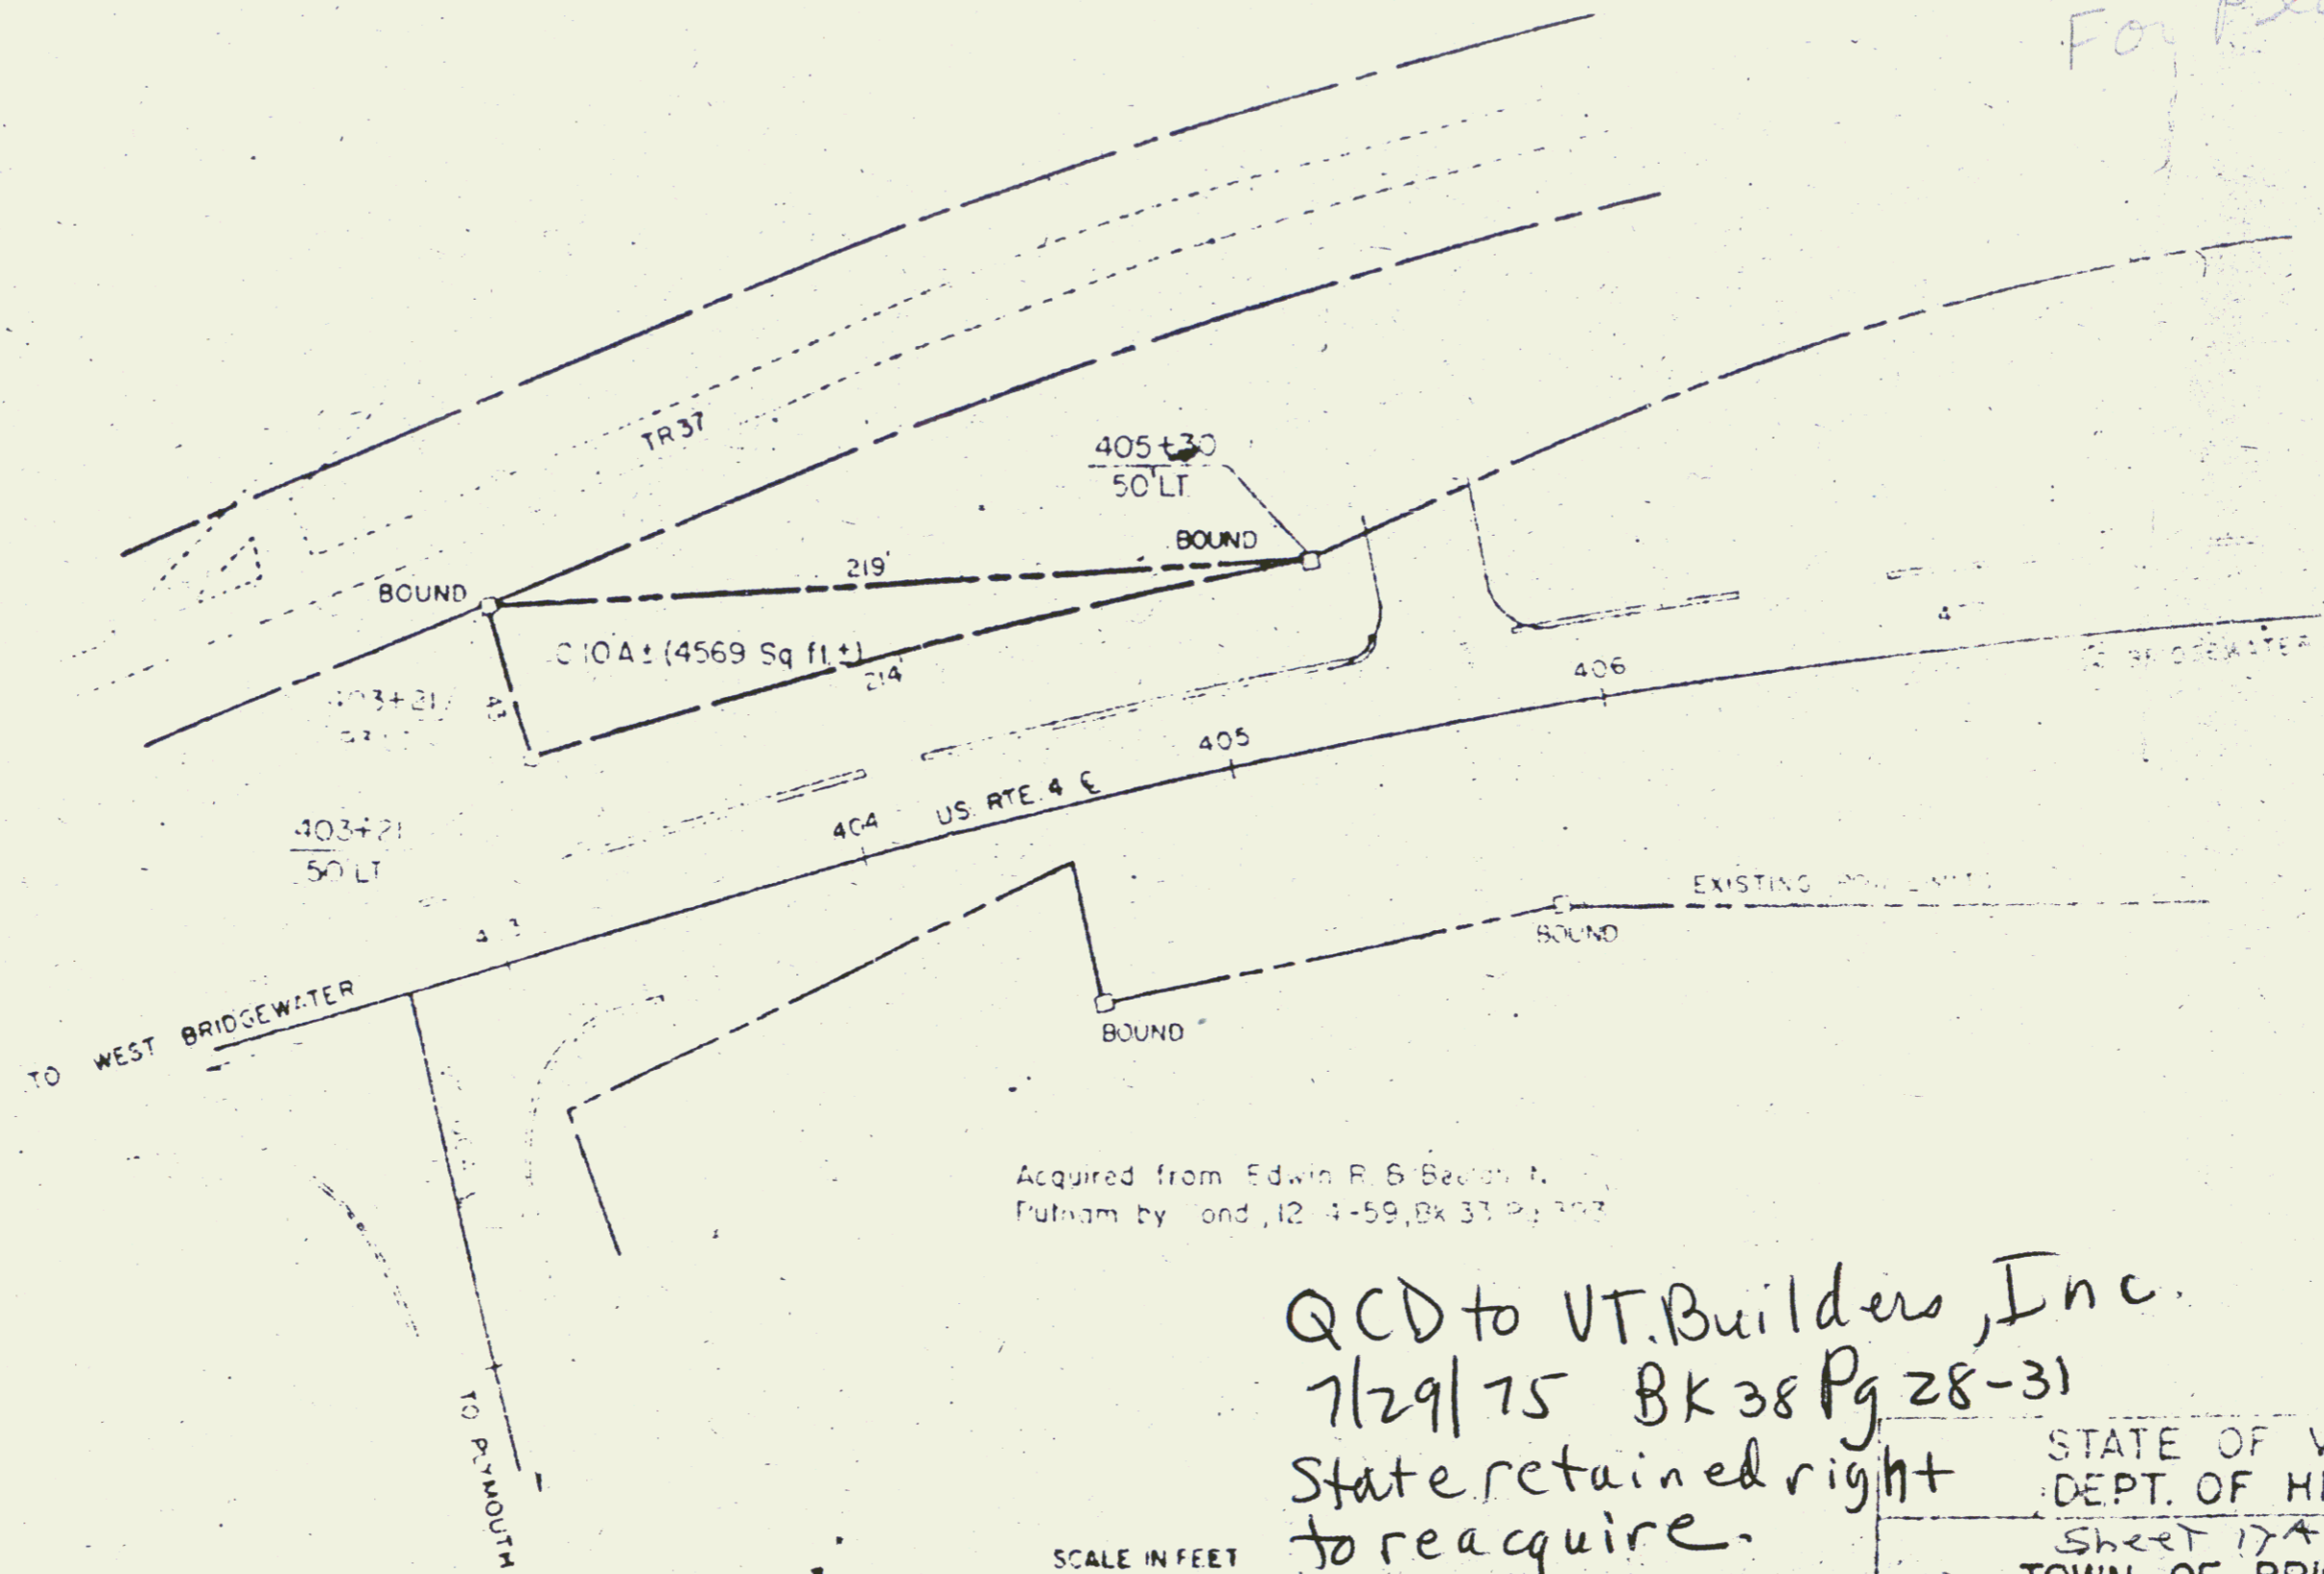

Acquired from Edwin R. S. Bacon, Jr.
Fulham by bond, 12-4-59, Bk 37 Pg 307

QCD to VT. Builders, Inc.
7/29/75 Bk 38 Pg 28-31
State retained right
to reacquire.

1154
F 022-268



(198)
STATE OF VERMONT
DEPT. OF HIGHWAYS
Sheet 17A
TOWN OF BRIDGEWATER
PROJECT BRIDGEWATER RD 20