


Acquired from Edwin R. & Beulah N. Putnam by Cond., 12-4-59, Bk. 33, Pg. 393

**STATE OF VERMONT  
TO  
INTERNATIONAL PAPER COMPANY  
(0.07A±)**

QCD 3/13/90 Conveyed the State's right to require 0.07A±  
Bk 47 Pg 196-198

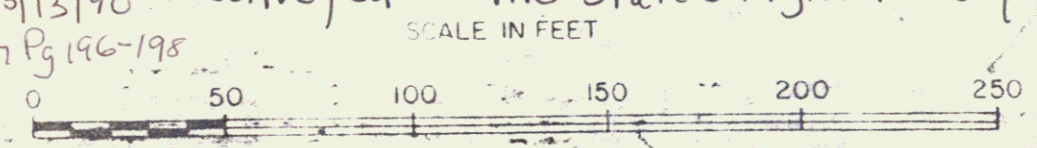

RIGHT-OF-WAY DIVISION  
TOWN FILE  
PERPETUAL  
Town of Bridgewater US 4 MM 5.678  
(To Be Returned To R.O.W. Division)

STATE OF VERMONT AGENCY OF TRANSPORTATION		
TOWN OF BRIDGEWATER (19C)		
PROJECT BRIDGEWATER = F020-2(8)		
APPROX. SCALE 1"=50'	DATE 12-20-89	DRAWN BY A.S.J.