
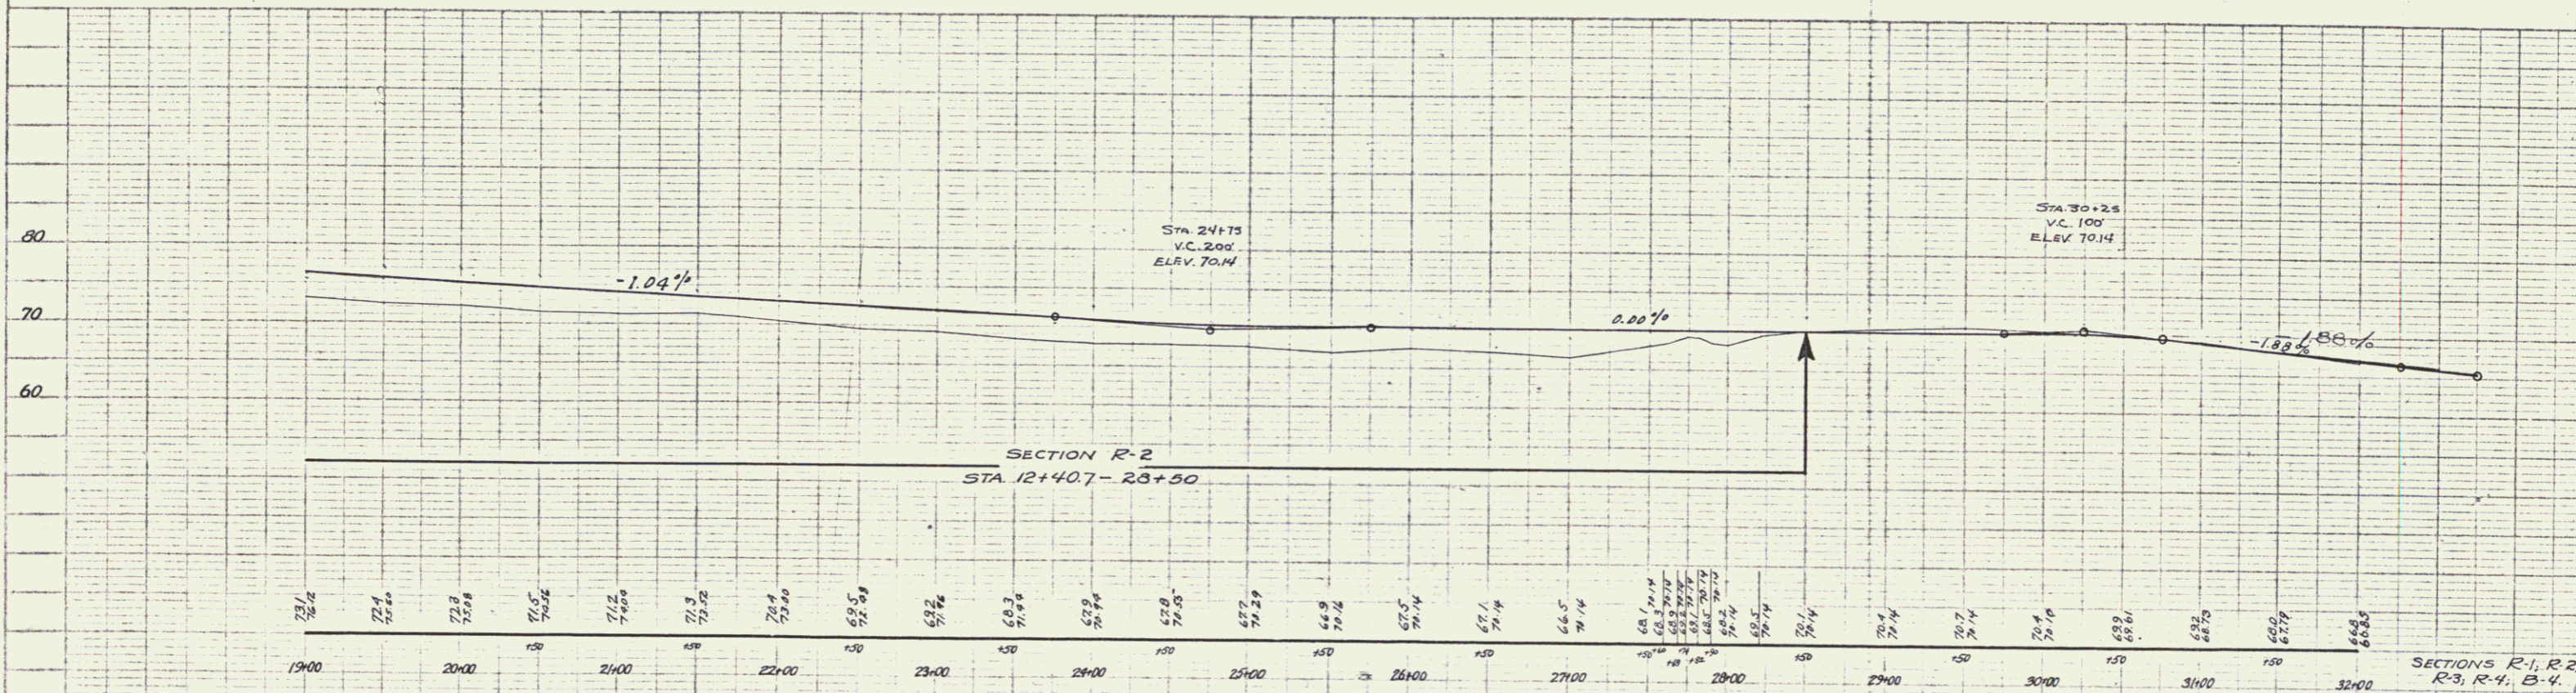


WOOD... GUARD RAIL REQUIRED  
 ON LEFT  
 STA 27+45 TO STA. 27+68 LENGTH 24'  
 STA 27+82 TO STA. 28+06 LENGTH 24'  
 ON RIGHT  
 STA 27+45 TO STA. 27+68 LENGTH 24'  
 STA 27+82 TO STA. 28+178 LENGTH 36'

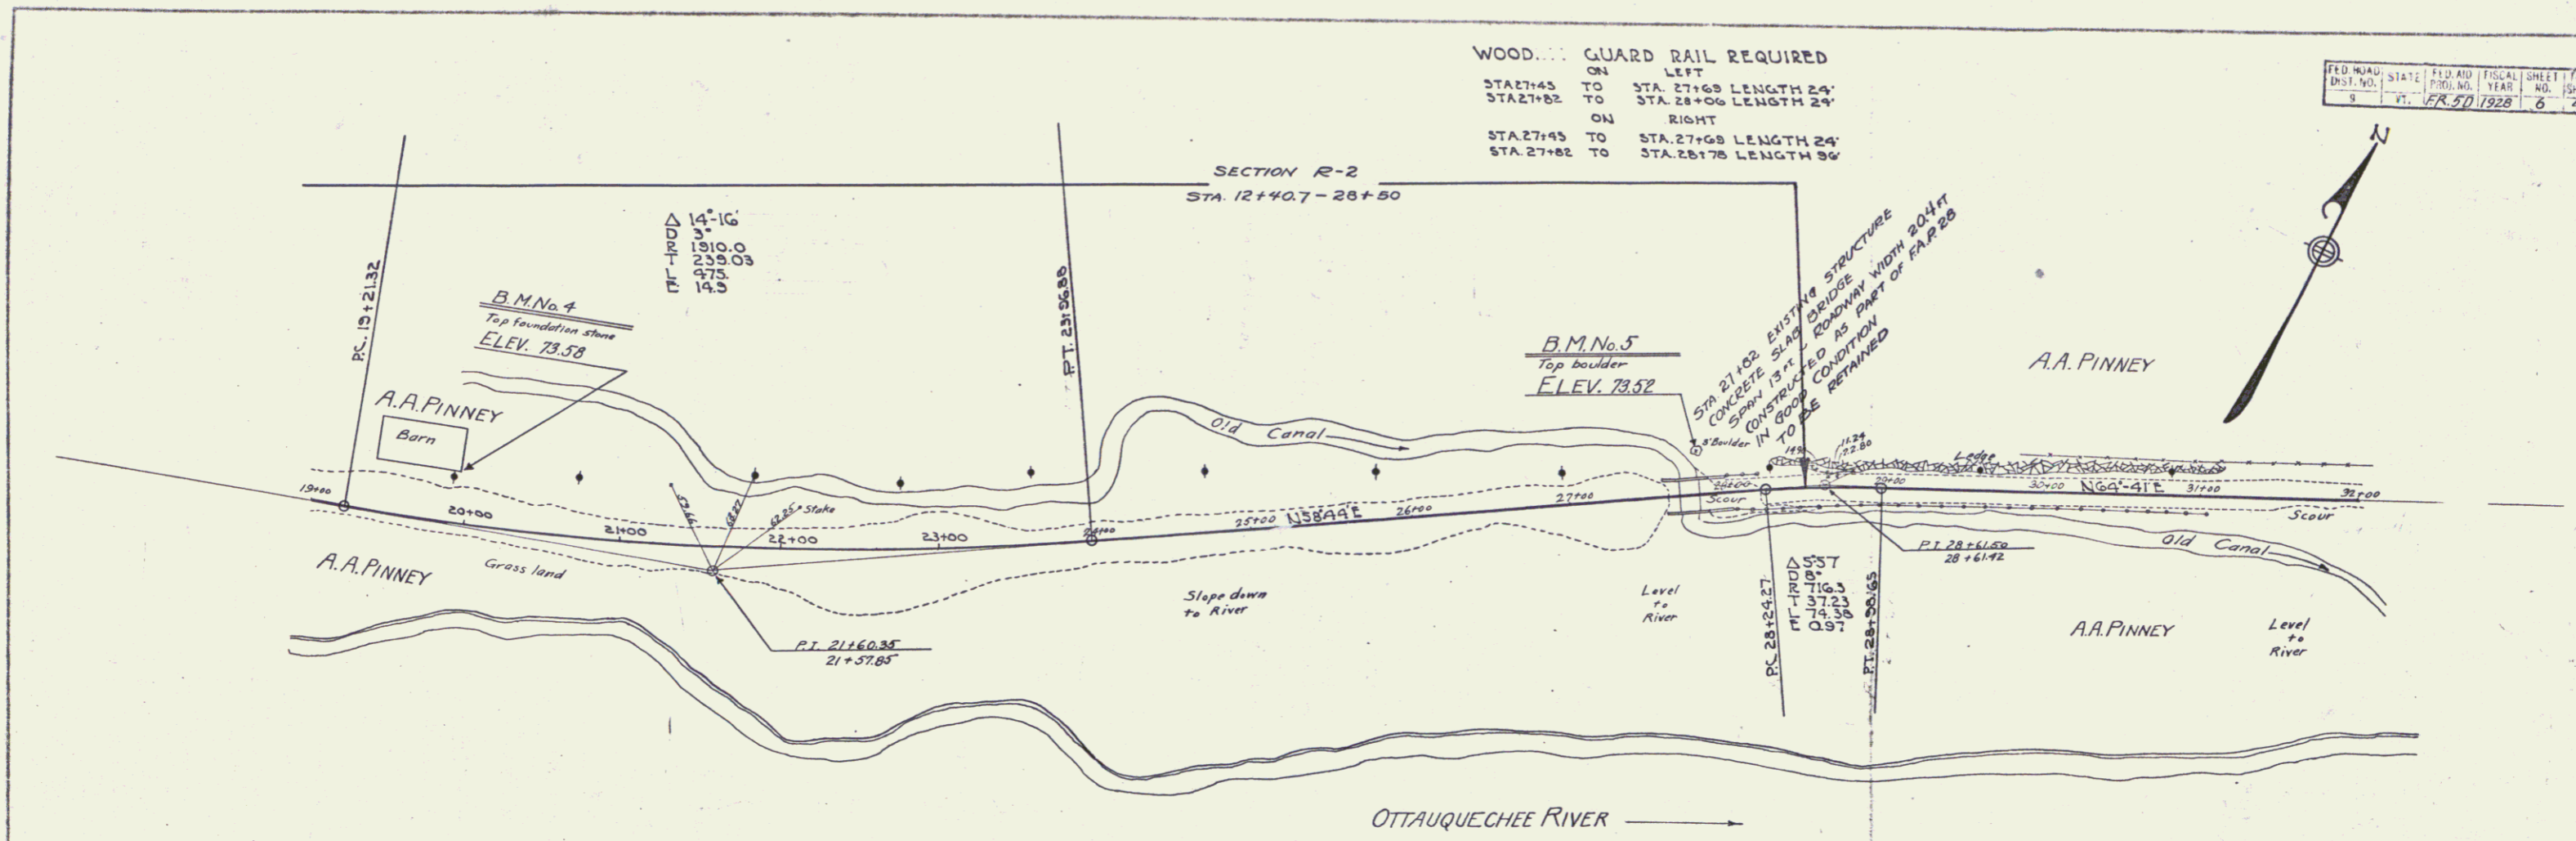

B.M. No. 4 ~ Top foundation stone S.E. cor. old barn ~ ELEV. 73.53  
 B.M. No. 5 ~ Top 3 ft. boulder in side hill North of concrete bridge ~ ELEV. 73.52

SECTIONS R-1, R-2, R-3, R-4, B-4  
 SERIES NO. FR 50  
 SHEET 6 OF 48

PLAN  
 SCALE 1" = 40'  
 DATE 1928

PROFILE  
 SCALE 1" = 10'  
 DATE 1928