


$\Delta = 13^\circ 24' 14''$
 $D = 57'$
 $R = 1146.3$
 $T = 134.7$
 $L = 268.0$
 $E = 7.9$
 $2T-L = 1.4$

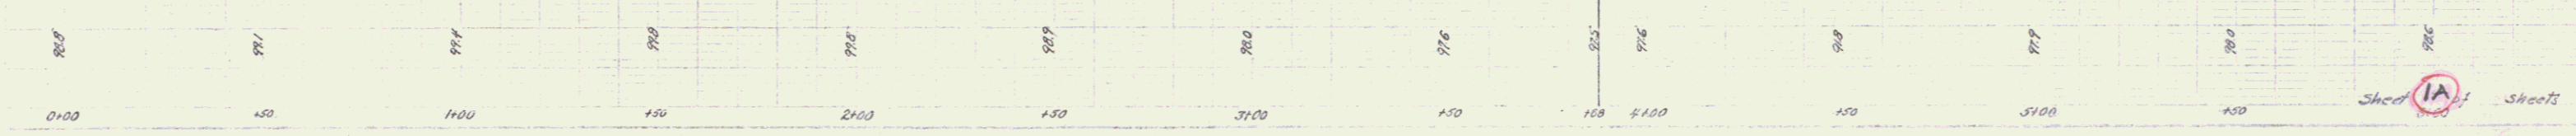

WOODSTOCK BRIDGE
 U.S. ROUTE #4
 F.A.P. #100N