



- TYPICAL SECTIONS -

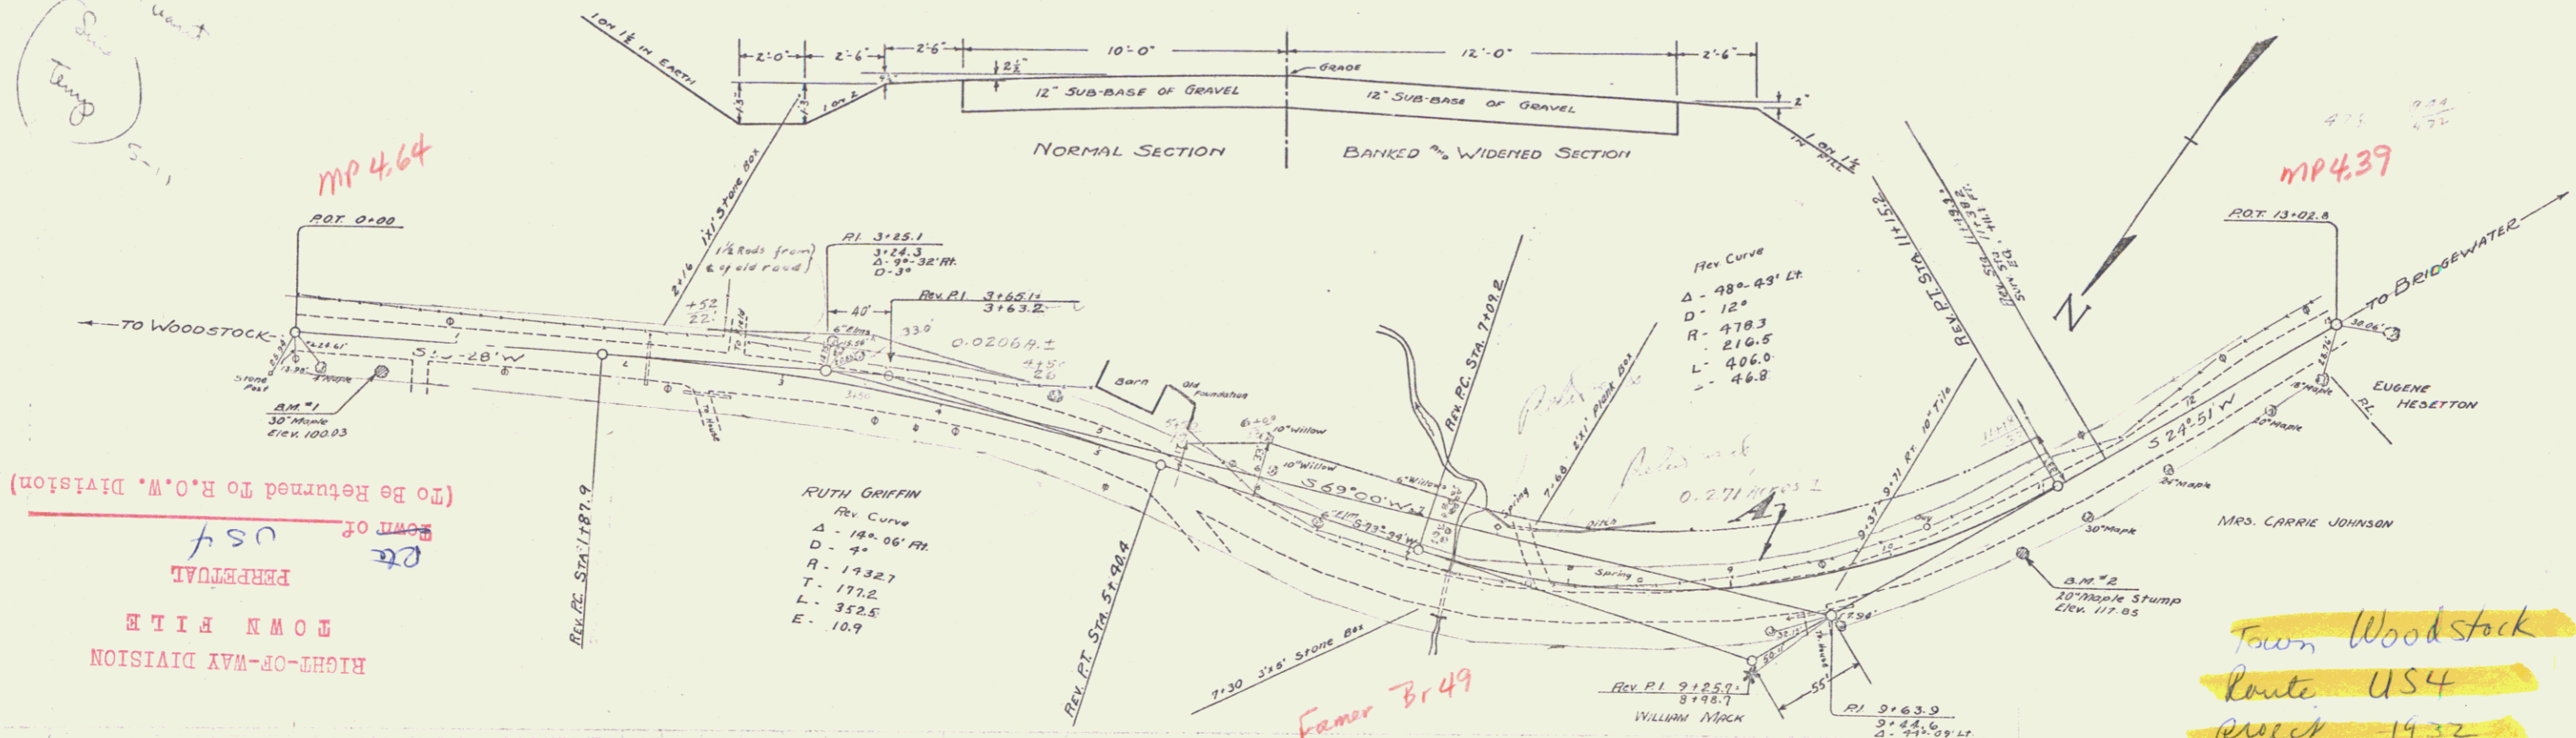

(To Be Returned to R.O.W. Division)  
 PERPETUAL  
 ROUTE US4  
 TOWN FILE  
 RIGHT-OF-WAY DIVISION

Town Woodstock  
 Route US4  
 Paper 1932  
 371 571

PARCEL	INSTRUMENT	DATE	GRANTOR	GRANTEE	RECORDED	REMARKS
A	Q.C.O.	2-23-33	E.E. R.H.E. HASELTON	STONY	45	2-25-33

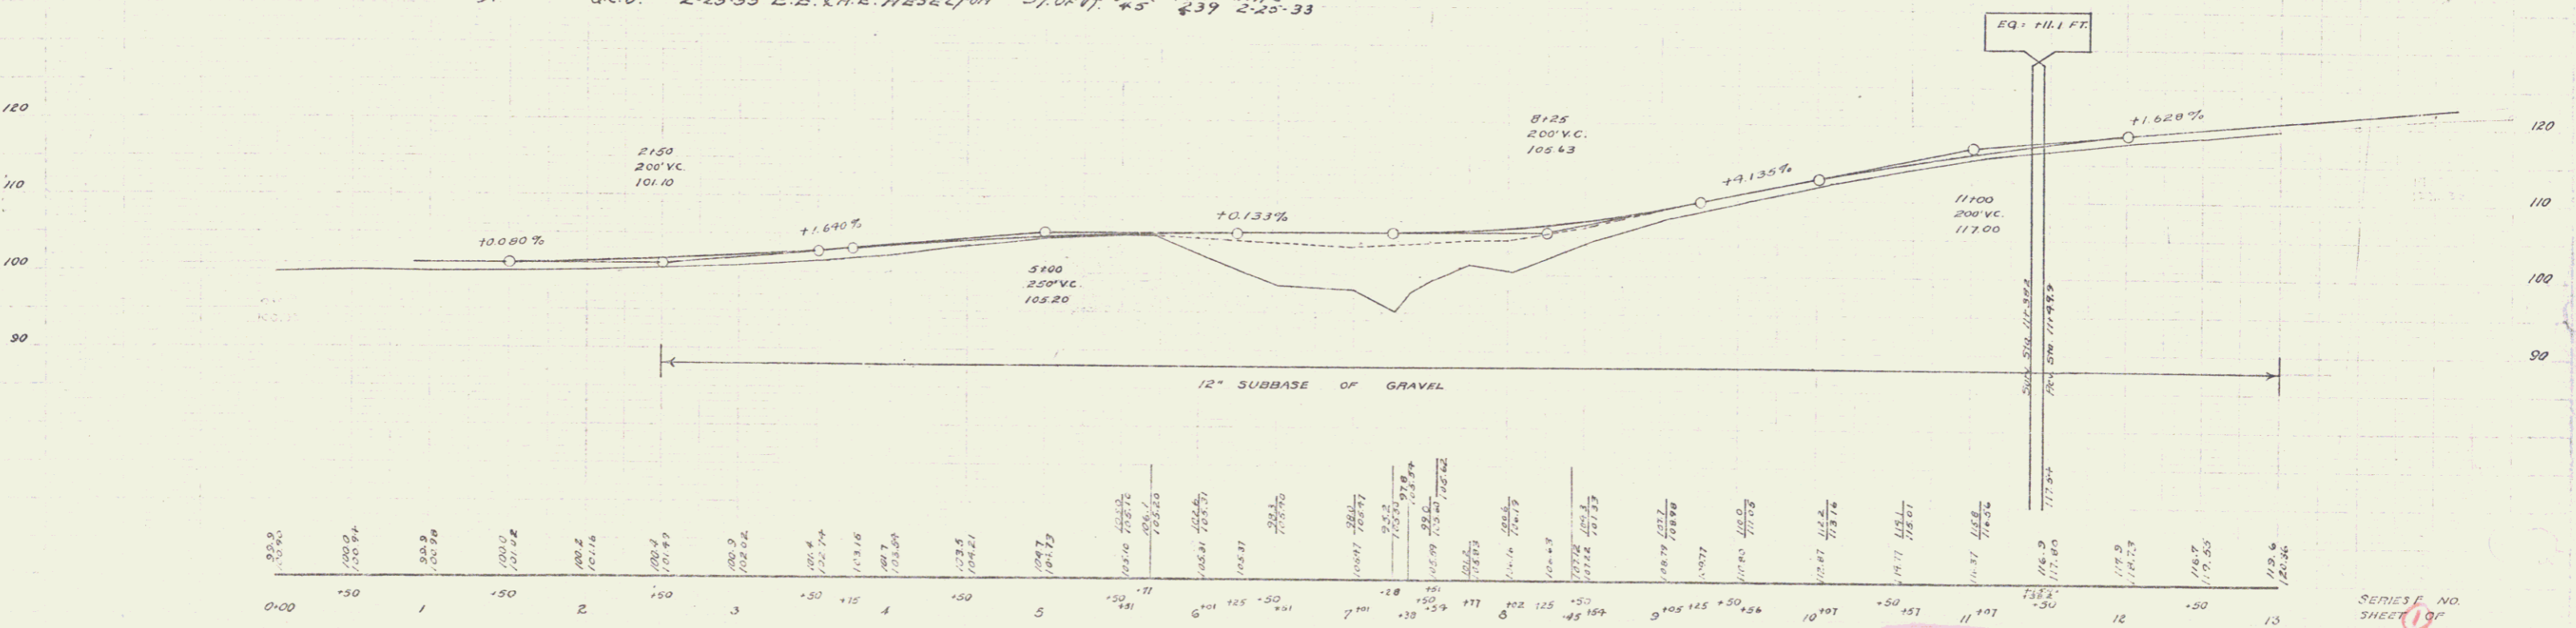

01/01/32

Pin# 99R186