

INDEX OF SHEETS

SHEET NO. 1	TITLE PAGE	
2	TYPICAL CROSS-SECTION OF IMPROVEMENT	GRAVEL MIXED IN PLACE SURFACE COURSE
3-23	PLAN AND PROFILE	
29	STANDARD STRUCTURE SHEET	5-28 PIPE CULVERTS
30	"	5-29 BOX "
31	"	5-30 UNDERDRAIN, RET. WALLS, ETC.
31A	"	5-31 BOUNDARY MARKERS
32	BARRICADES, SIGNS AND LIGHTS	5-B-11
33	S&B FOR NO. C. E. SQUARE (SPAN 60') - BRIDGE STANDARD	
34	SLAG - ABUTMENTS	
35	S&B - DETAILS	5-24, 5-25, 5-26, 5-27
36	S&B - 2A	5-22, 5-23, 5-24
37	S&B - 2B	5-27
38-140	CROSS SECTIONS	


STATE OF VERMONT  
STATE HIGHWAY DEPARTMENT

PLAN AND PROFILE OF PROPOSED  
STATE HIGHWAY

**WOODSTOCK-BRIDGEMOUNT**


WOODSTOCK-BRIDGEMOUNT ROAD

BEGINNING WITH THE BEGINNING OF THE STATE HIGHWAY SYSTEM IN THE WEST END OF WOODSTOCK VILLAGE, WEST-ERLY 7.476 MILES TO THE EAST MARKER OF F&P 28 IN BRIDGEMOUNT CORNERS.

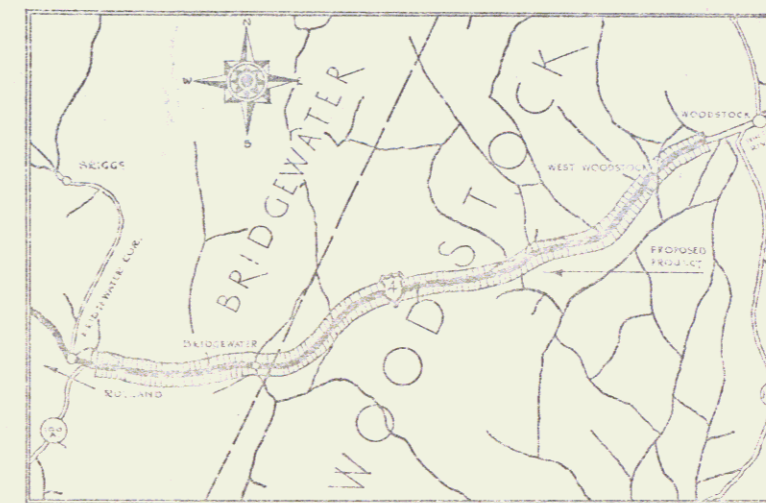

(To Be Returned To R.O.W. Division)  
Town of US4  
PERPETUAL  
RIGHT-OF-WAY DIVISION

Pin# 99R189

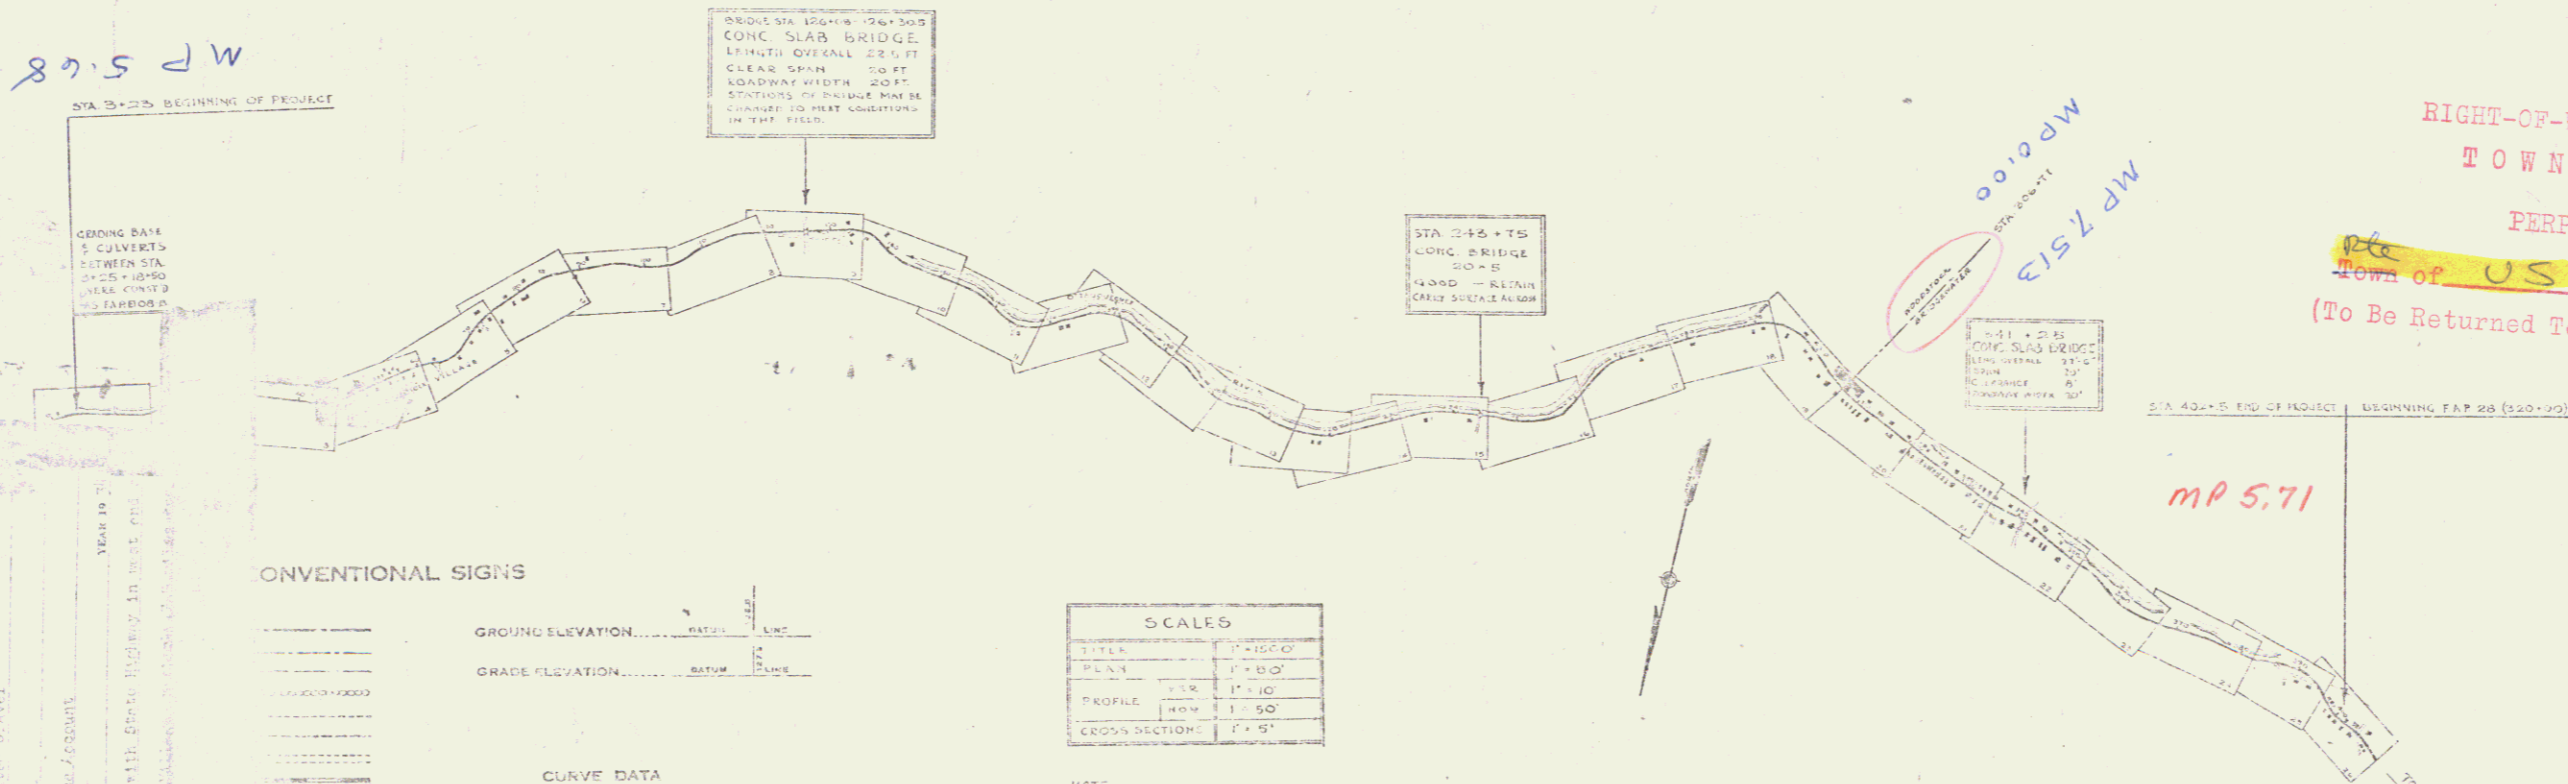

RIGHT-OF-WAY DIVISION  
TOWN FILE  
PERPETUAL  
Town of US4  
(To Be Returned To R.O.W. Division)

CONVENTIONAL SIGNS

GROUND ELEVATION	.....	.....	.....
GRADE ELEVATION	.....	.....	.....

CURVE DATA	
DEFLECTION ANGLE	.....
DEGREE OF CURVE	.....
TANGENT DISTANCE	.....
LENGTH OF CURVE	.....
EXTERNAL DISTANCE	.....
POINT OF INTERSECTION	.....
POINT OF CURVE	.....
POINT OF TANGENT	.....
POINT ON TANGENT	.....

SCALES

TITLE	1" = 1000'
PLAN	1" = 100'
PROFILE	1" = 50'
CROSS SECTION	1" = 5'

NOTES:  
1. All work shown to date is to be done by the contractor in the form of a public road or the construction of the highway.  
2. The plan is to be used as a guide only and does not show the location and grade of all structures including all structures and all other structures the National Recovery Act Special Provisions and such other special provisions and special provisions as are shown on the plans.

01/01/34

Project No. N.R.H. 108-D

STEARNS R. JENKINS

FED. ROAD DIST. NO.	STATE	PROJECT NO.	SHEET NO.	TOTAL SHEETS
3	VT.	108-D	1	140

APPROVED

RECOMMENDED FOR APPROVAL

RECOMMENDED FOR APPROVAL

APPROVED

SERIES NO. 108-D FILED

SHEET 1 OF 140