
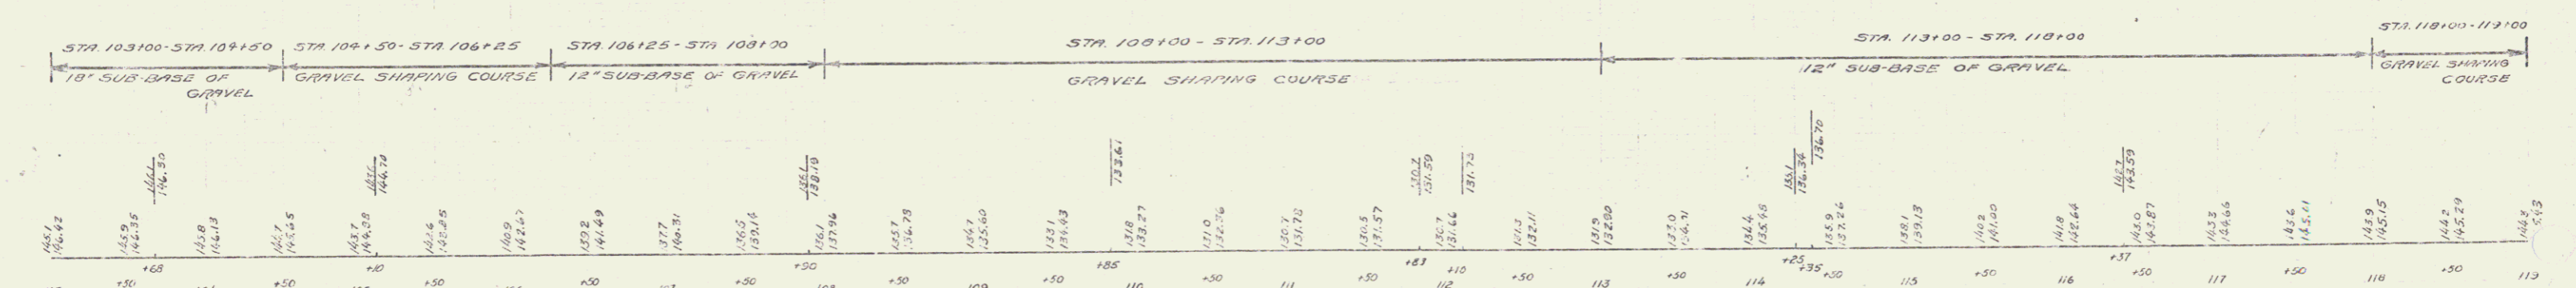


Parcel	Kind of Instrument	Date of Instrument	Grantor	Grantee	Recorded	Remarks
B"	G.C.D.	8-18-34	Charlotte Noyes Stratton	L.J. Peoples et al	45 357-8	9-30-34 #6
A/Cub #1, #2	"	5-10-34	"	"	45 358	7-10-34 City Plat 113+85 & 118+50 #7

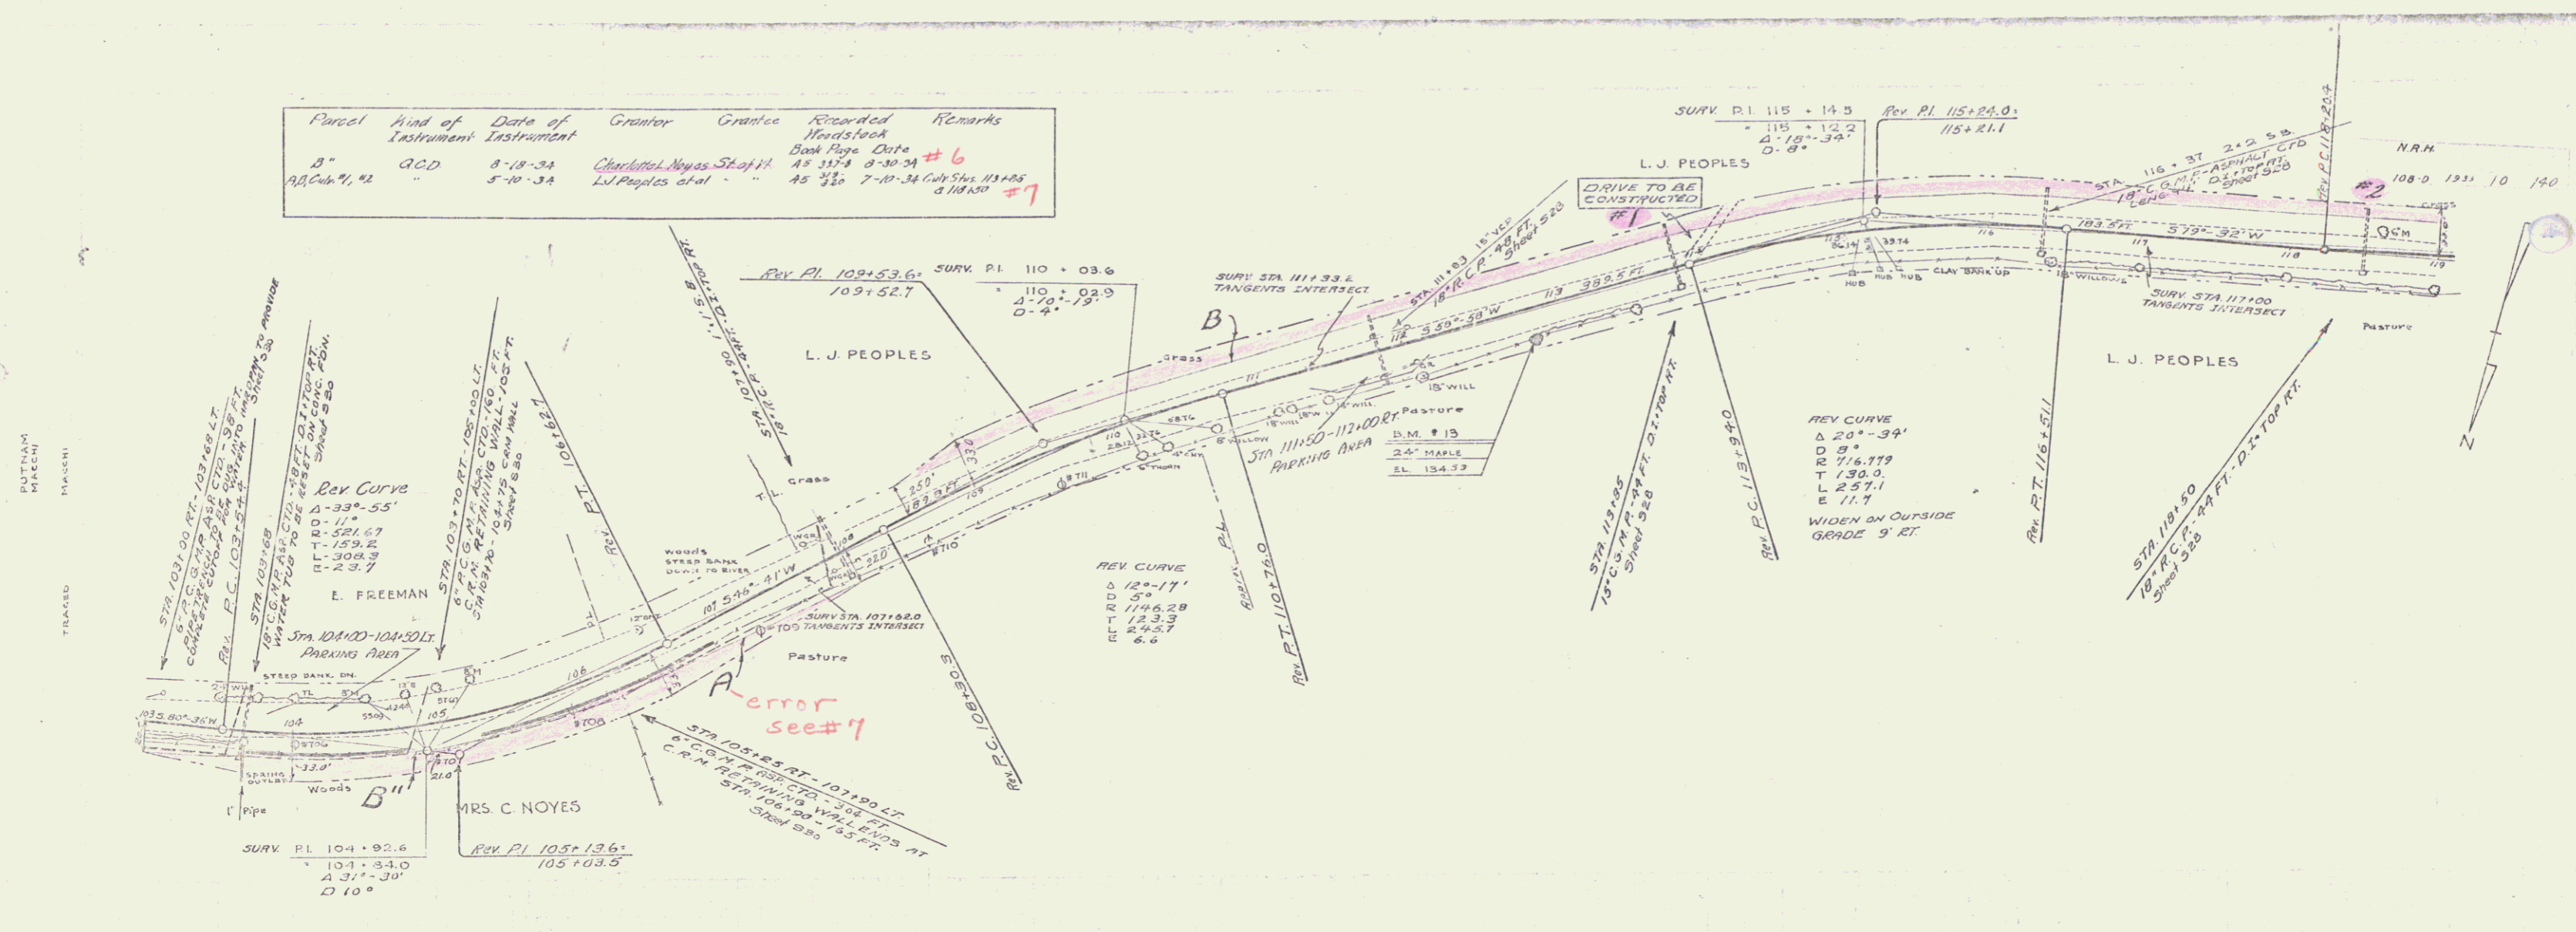

BN "13 Spike in Root 24" Maple 19' RT Sta. 112+84 Elev 134.50'

Series N.R.H. No. 108-D  
Sheet 10 of 120