


Parcel	Kind of Instrument	Date of Grantor	Grantor	Grantee	Recorded	Remarks
B	O.C.D.	5-10-34	L.J. Peoples et al	Stet. H.	45 132	7-10-34 #7
A	"	6-28-34	E.H. Williams Jr. et al	"	46 311-2	7-19-34 #8

16 Williams wd 10/30/68 BK 59 Pg 533  
 17 Williams wd 9/5/68 59 472  
 18 Kinne wd 9/4/68 59 470

Rev. Curve  
 Δ 3°53'  
 D 1°  
 R 572.965  
 T 194.3  
 L 388.3  
 E 3.3

PUTNAM  
MACCHI  
TRACKS

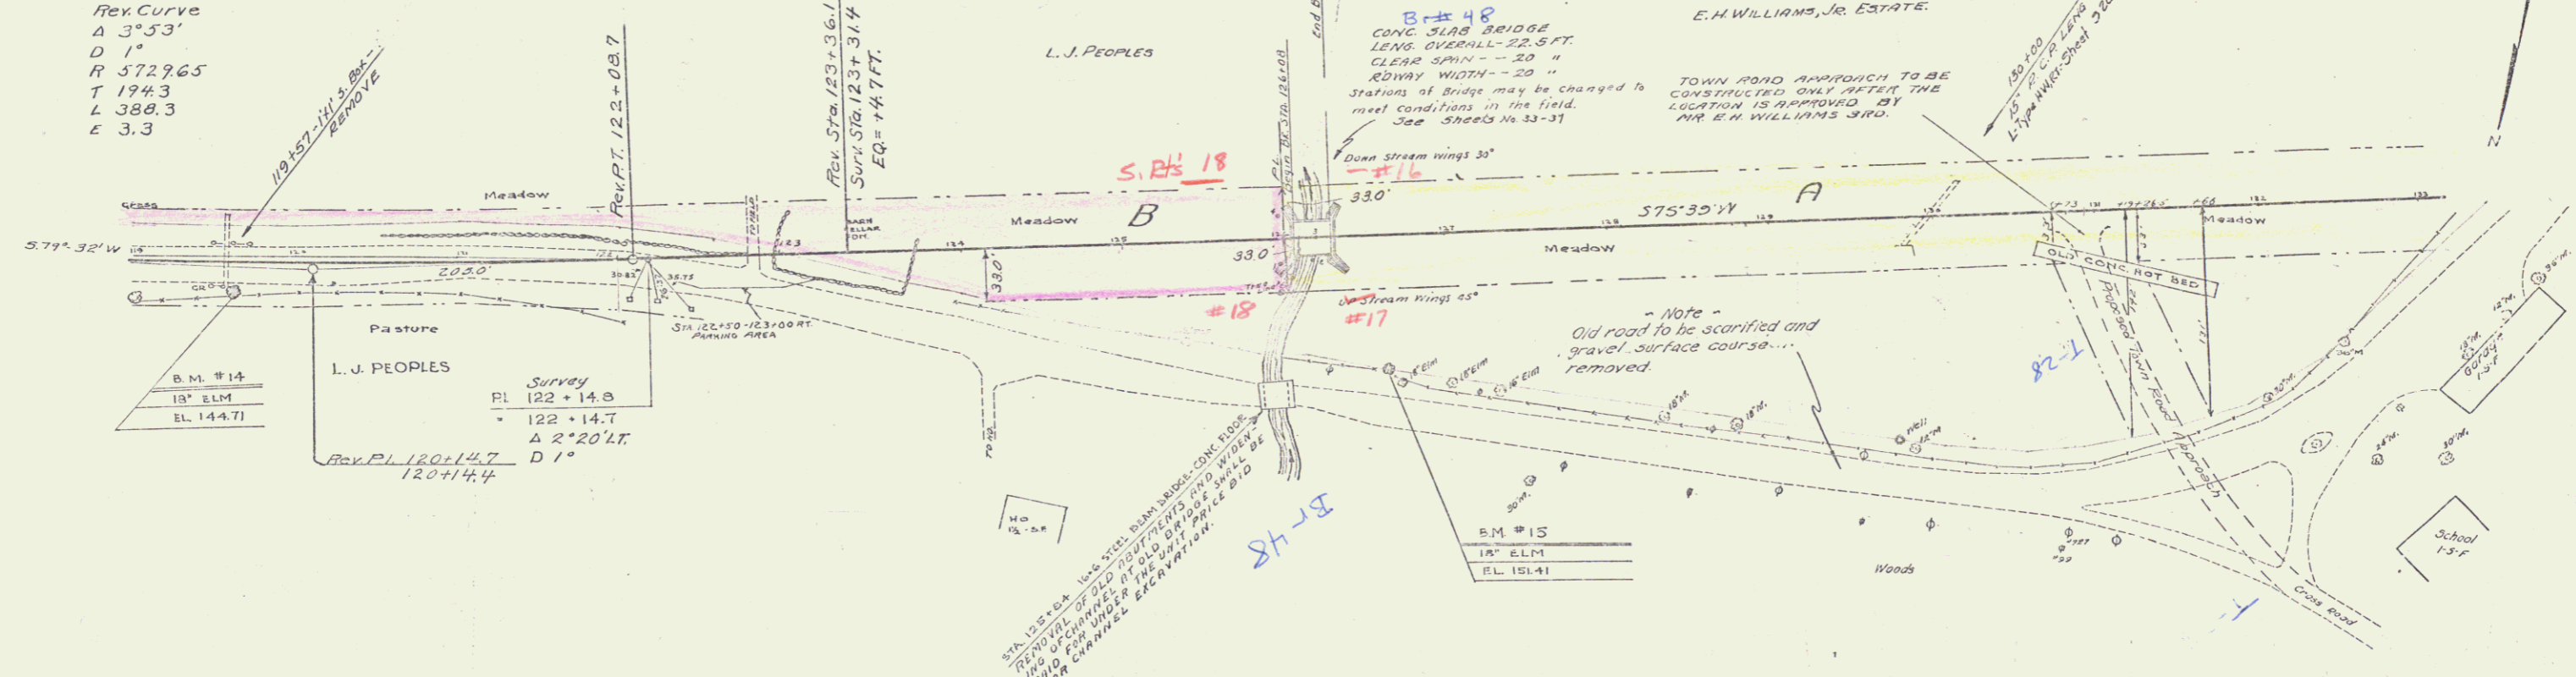

**BORING NOTES**

NO.	DEPTH	DESCRIPTION
1	0'-6"	Gravel
2	6'-6"	Sand
3	12'-6"	Clay
4	18'-6"	Clay
5	24'-6"	Clay
328	1962'-6"	Clay