


| Found | Kind of Instrument | Date of Instrument | Grantor | Grantee | Recorded | Remarks |
|-------|--------------------|--------------------|---------------------|------------|----------------|---------|
| A | G.C.D. | 6-28-34 | E.H. Williams, Est. | St. of Yl. | 45 331 7-10-34 | #8 |
| A | " | 6-27-34 | Mrs. J. B. Williams | " | 45 330 7-10-34 | #9 |

NRH
108-D 1933 12 140

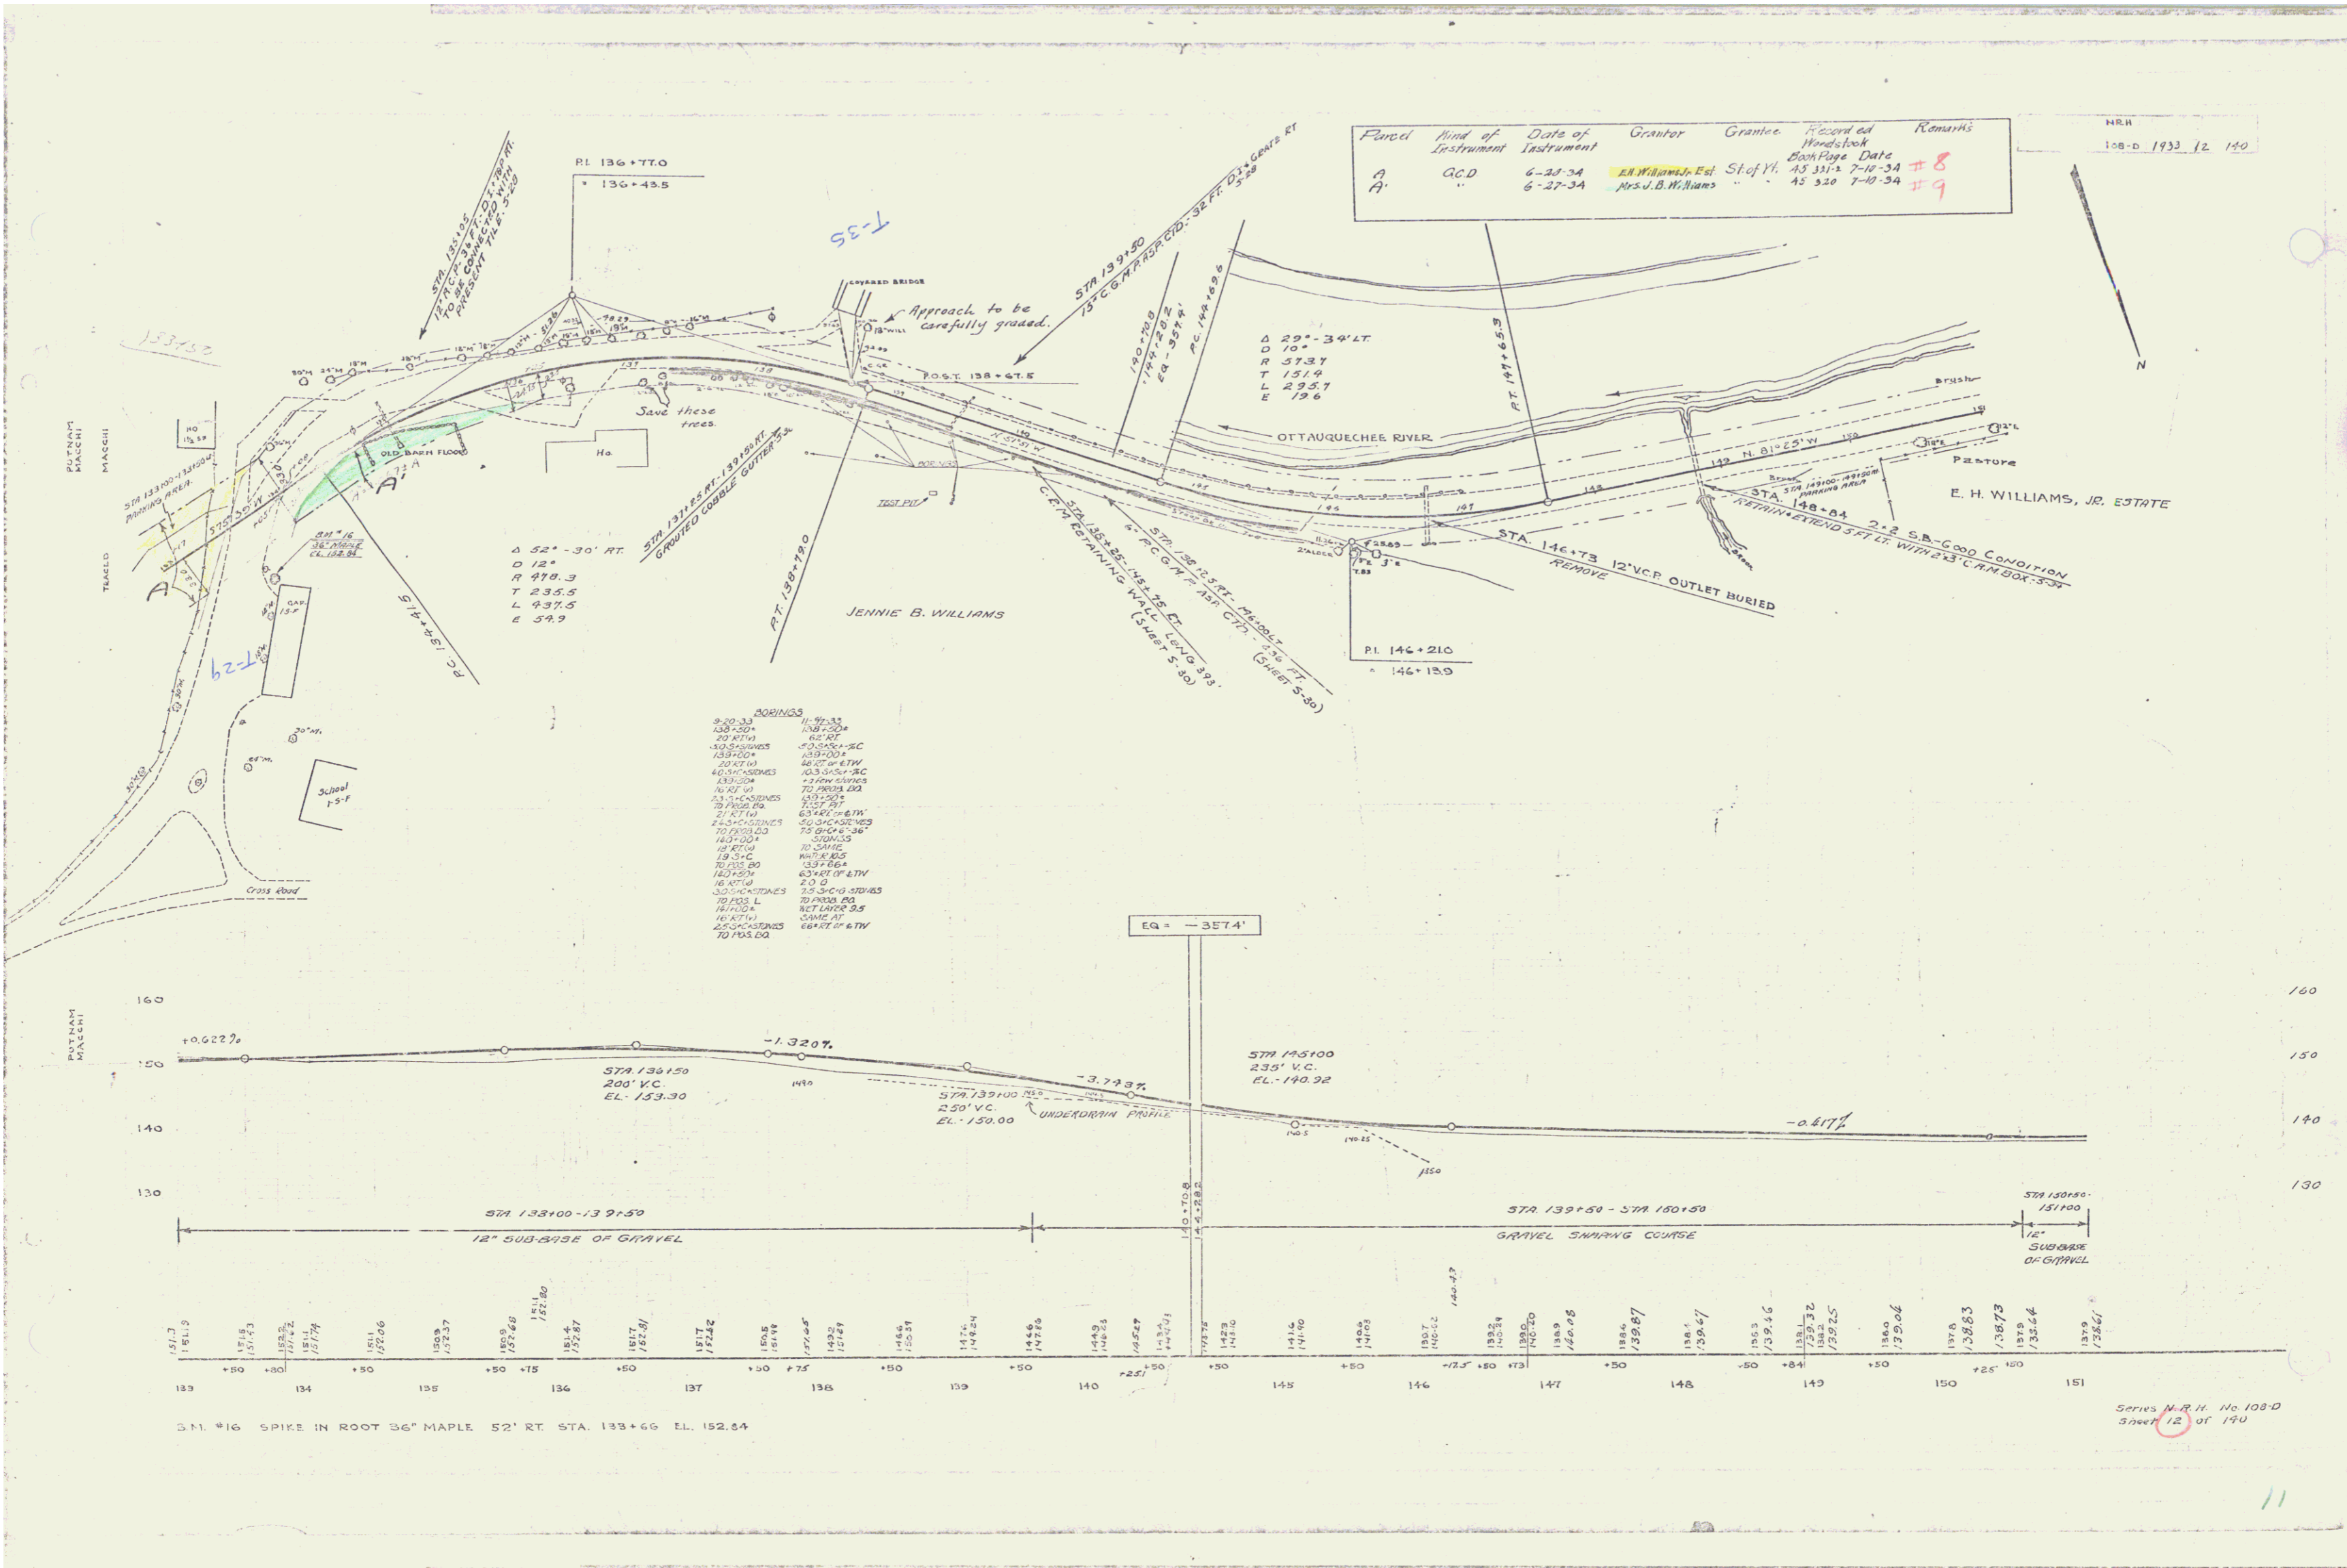

5.11. *16 SPIKE IN ROOT 36" MAPLE 52' RT. STA. 133+66 EL. 152.84

Series N.R.H. No. 108-D
Sheet 12 of 140