
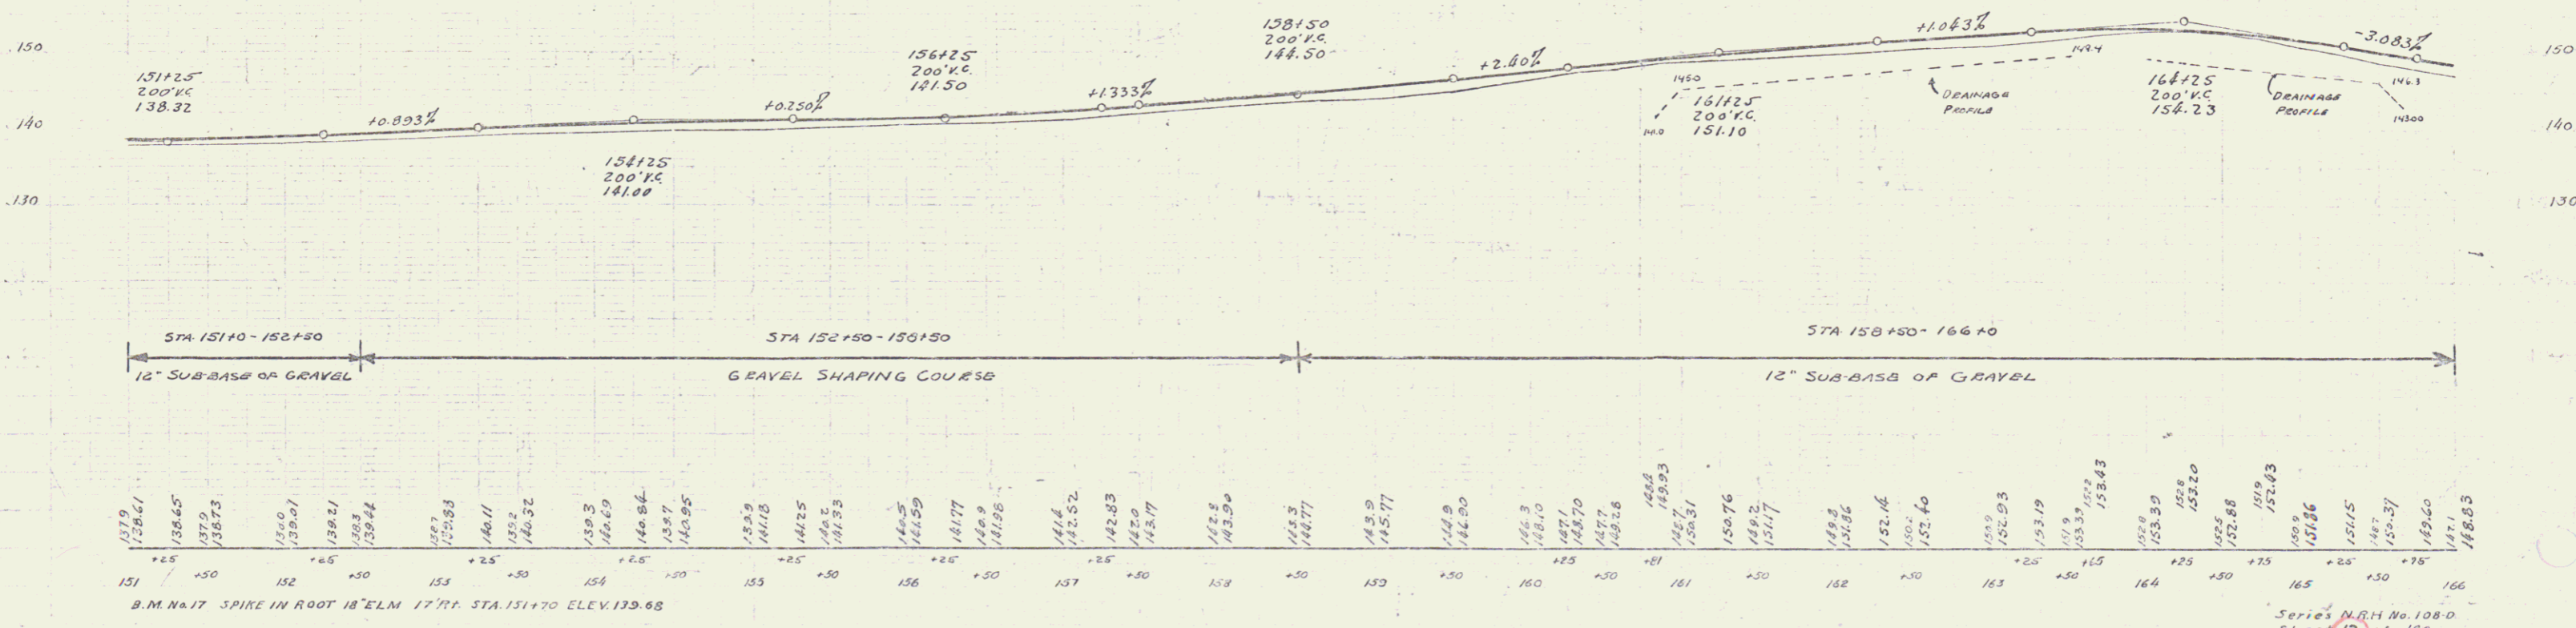


Parcel	Kind of Instrument	Date of Instrument	Grantor	Grantee	Recorded Book Page Date	Remarks
A'40'	G.C.D.	5-3-34	Mary Liberty	St of Yt	15 302 5-14-34	#10
B	"	6-28-34	E.H. Williams Jr Est.	"	15 312 7-19-34	#8

PUTNAM  
MASON  
TRACED

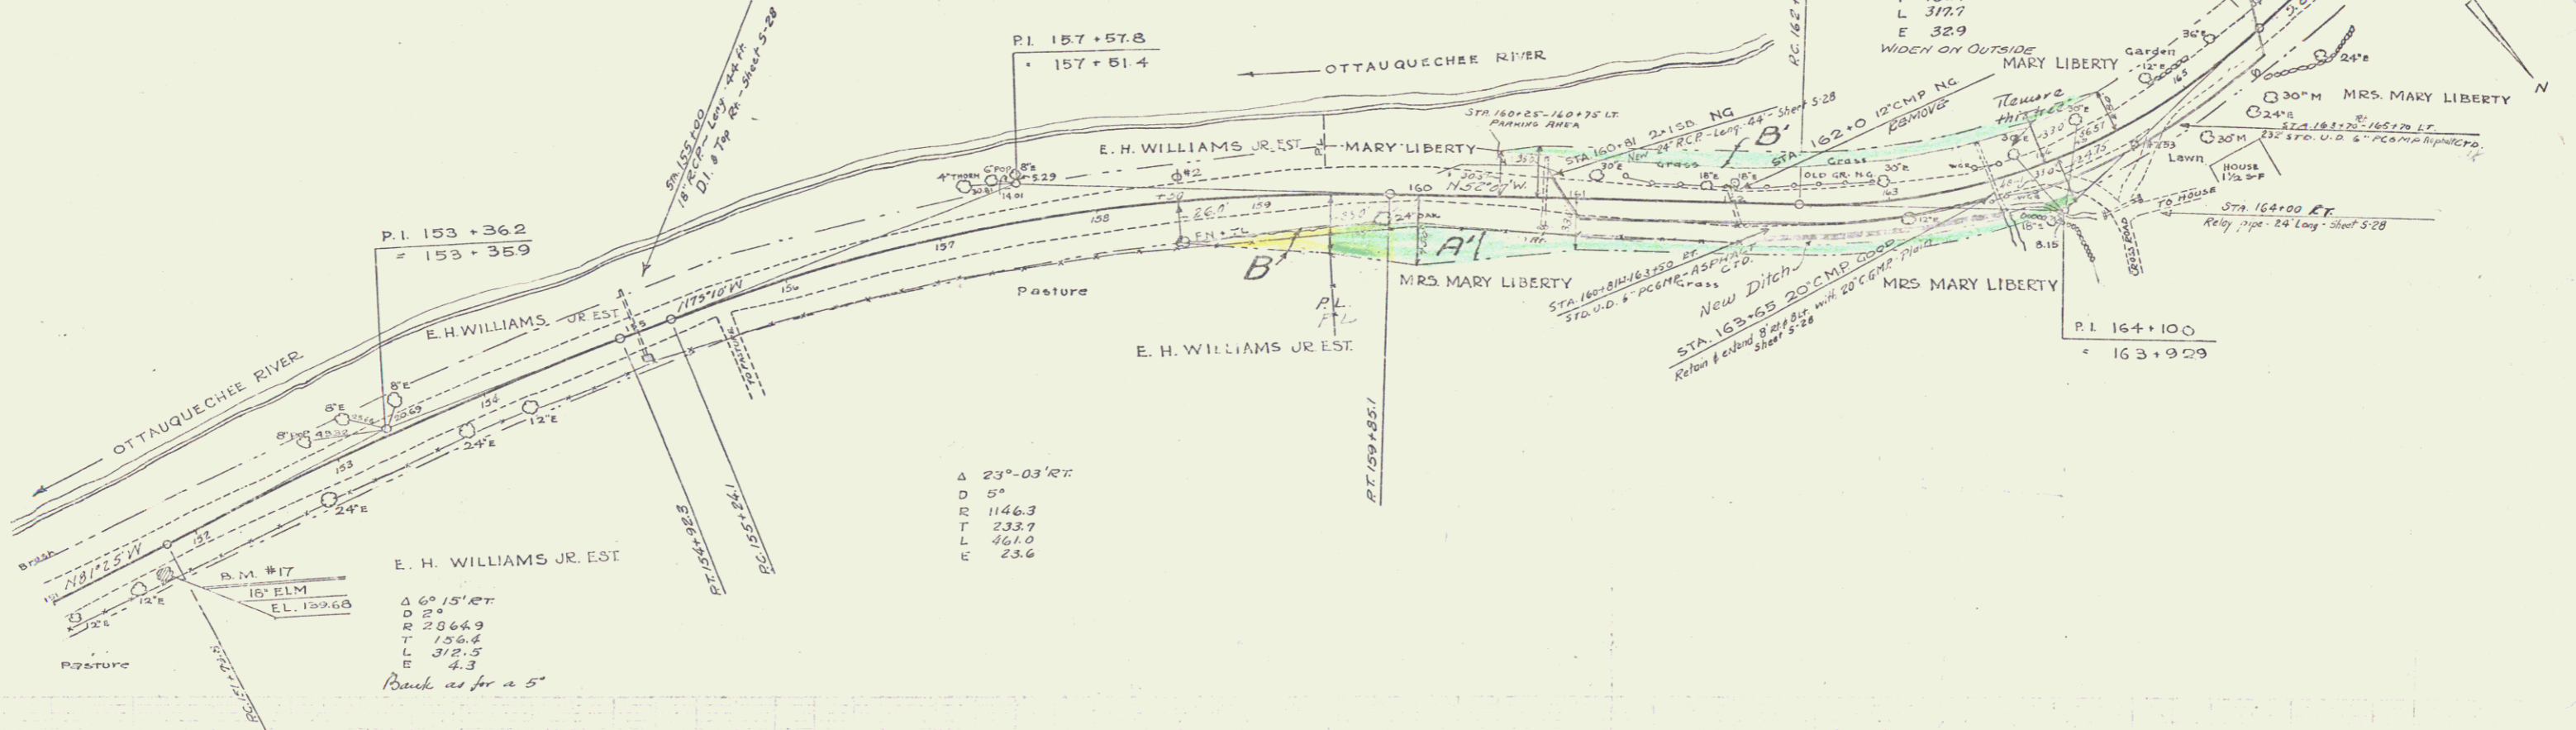

Station	Elevation	Station	Elevation	Station	Elevation
151	137.9	156	146.5	161	150.76
152	136.65	157	145.25	162	149.8
153	137.9	158	144.50	163	148.6
154	139.0	159	143.33	164	147.4
155	139.2	160	142.8	165	146.25
156	139.4	161	142.5	166	145.23
157	139.8	162	142.0		
158	140.1	163	141.7		
159	140.32	164	141.28		
160	140.9				
161	141.5				
162	142.0				
163	142.5				
164	143.0				
165	143.5				
166	144.0				

B.M. #17 SPIKE IN ROOT 18' ELM 17 7/11 STA. 151+70 ELEV. 139.68

Series N.R.H. No. 108-D  
Sheet 13 of 140