


Parcel	Kind of Instrument	Date of Instrument	Grantor	Grantee	Recorded	Remarks
A	C.D.	6-4-34	C.E. Colby	Sheff W.	Bath, Pa. De. AS 3730 6-13-34	#11

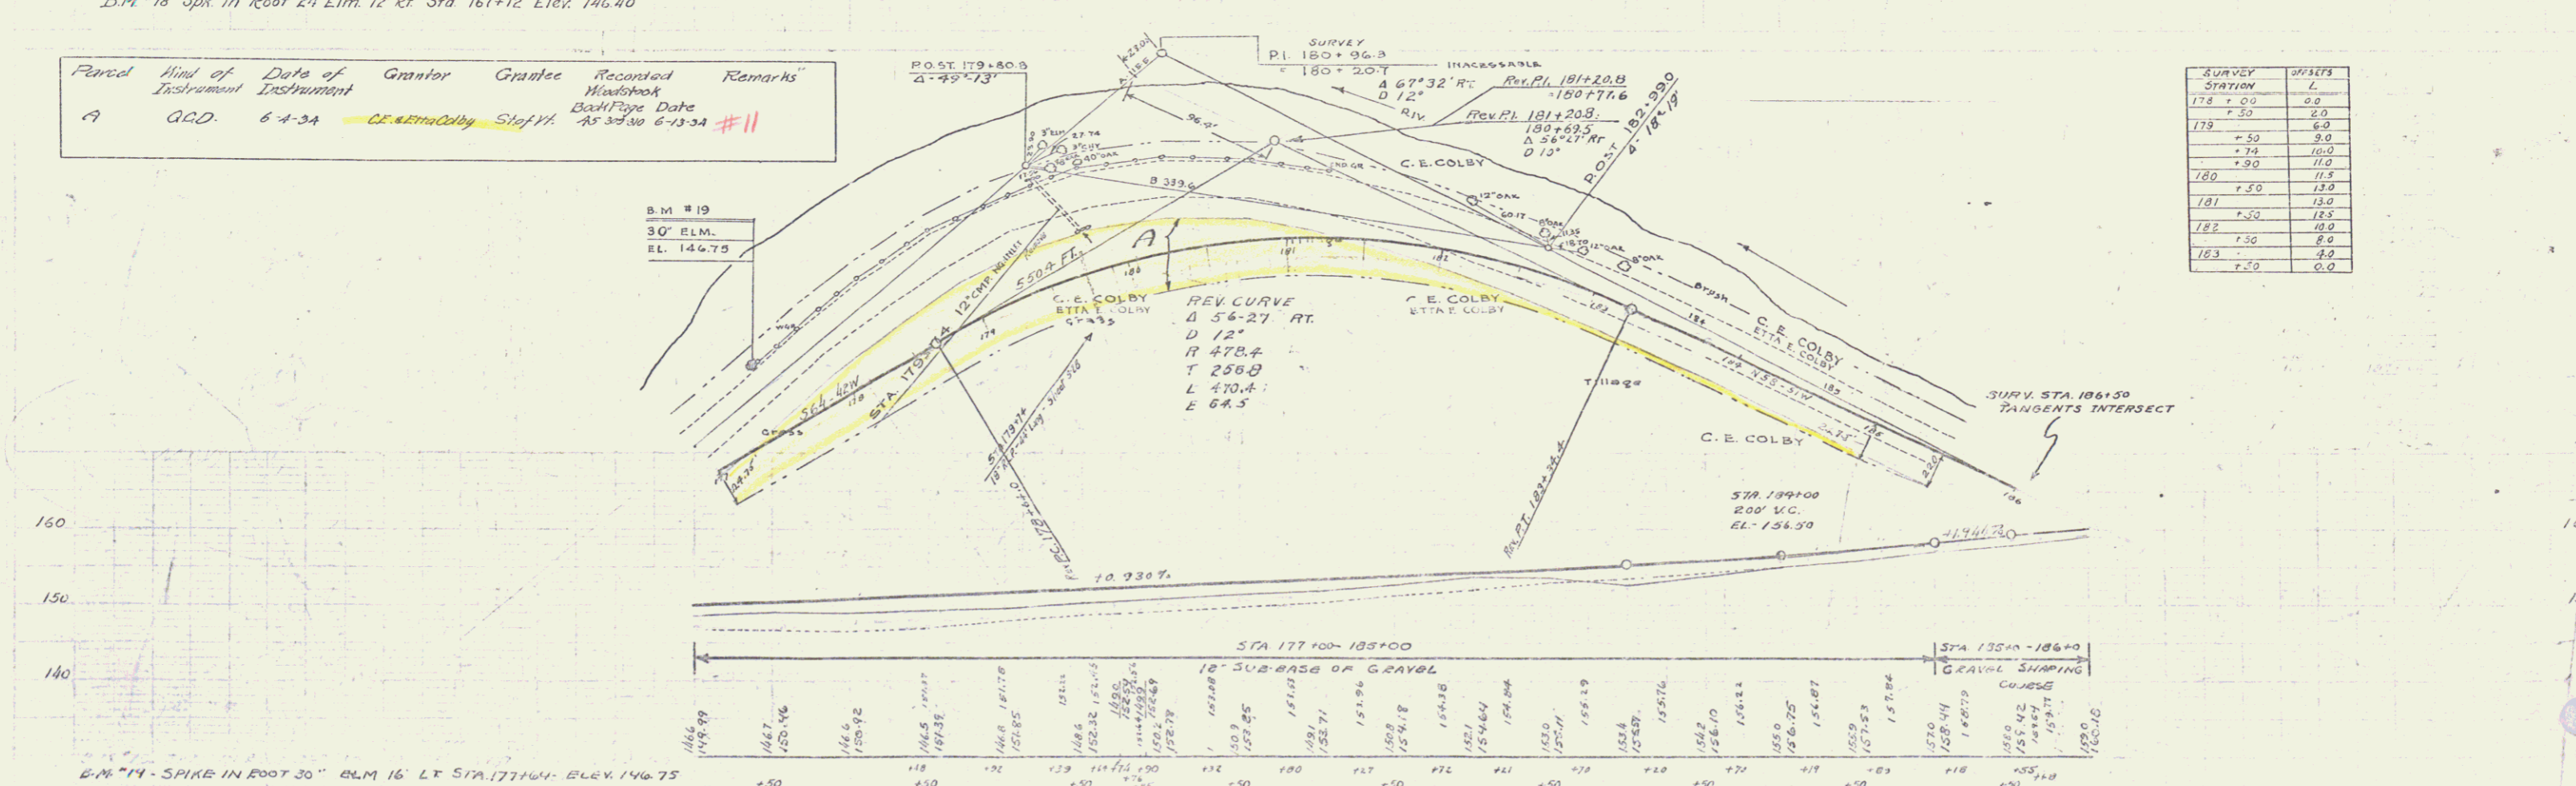

SURVEY STATION	GRAVEL L
178 + 00	0.0
+ 30	2.0
179	6.0
+ 30	9.0
+ 30	12.0
180	15.0
+ 30	18.0
181	21.0
+ 30	24.0
182	27.0
+ 30	30.0
183	33.0
+ 30	36.0

SERIES NRH NO 100-D  
SHEET 14 OF 190