
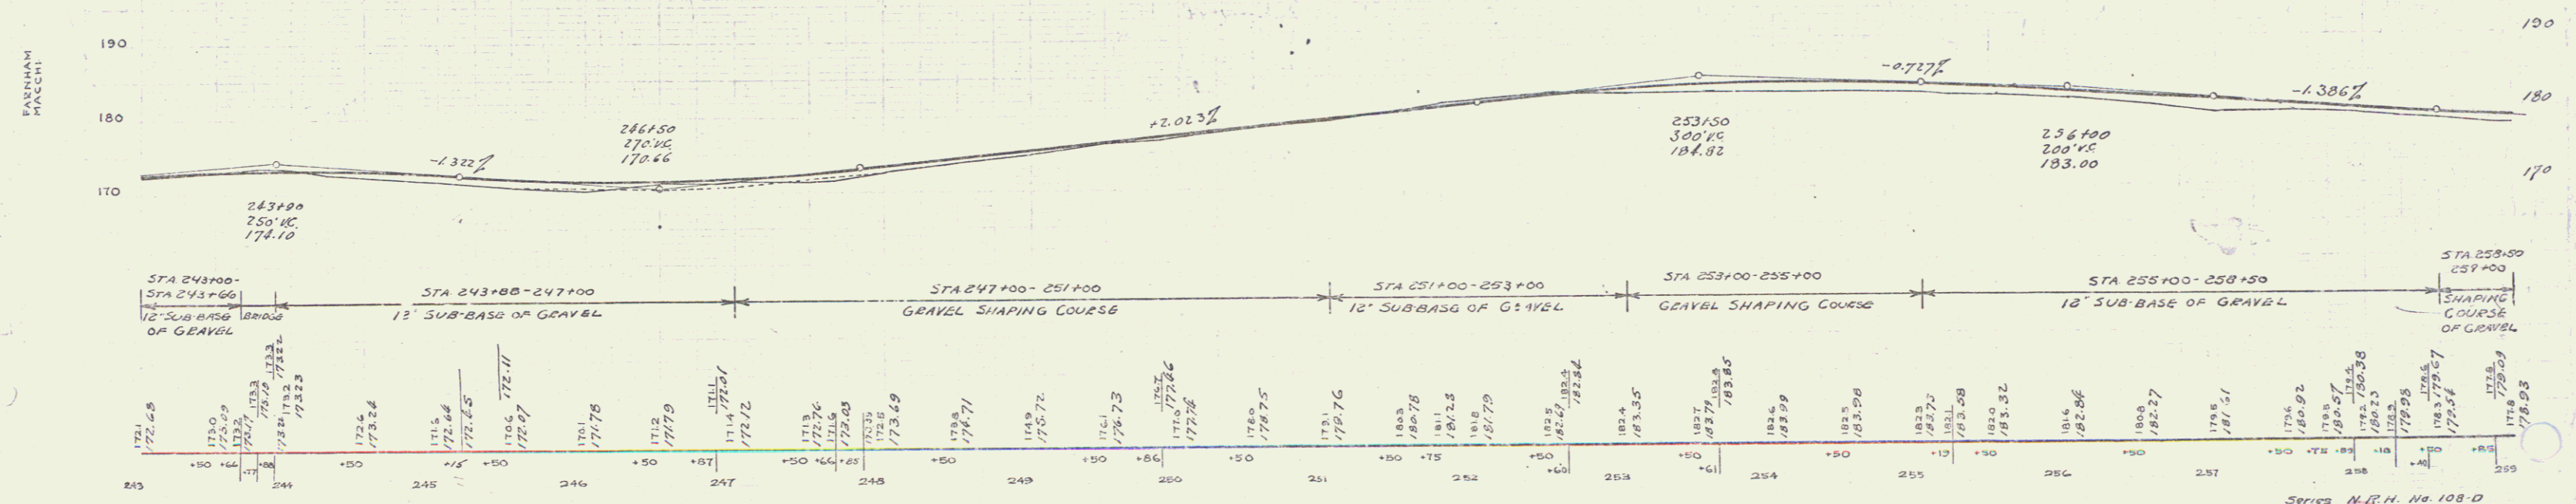


Parcel	Kind of Instrument	Date of Instrument	Grantor	Grantee	Recorded Headsheet	Remarks
A	G.C.D.	5-3-34	Jennie C. Stevens	Stef. H. 45 381	5-14-34	#13

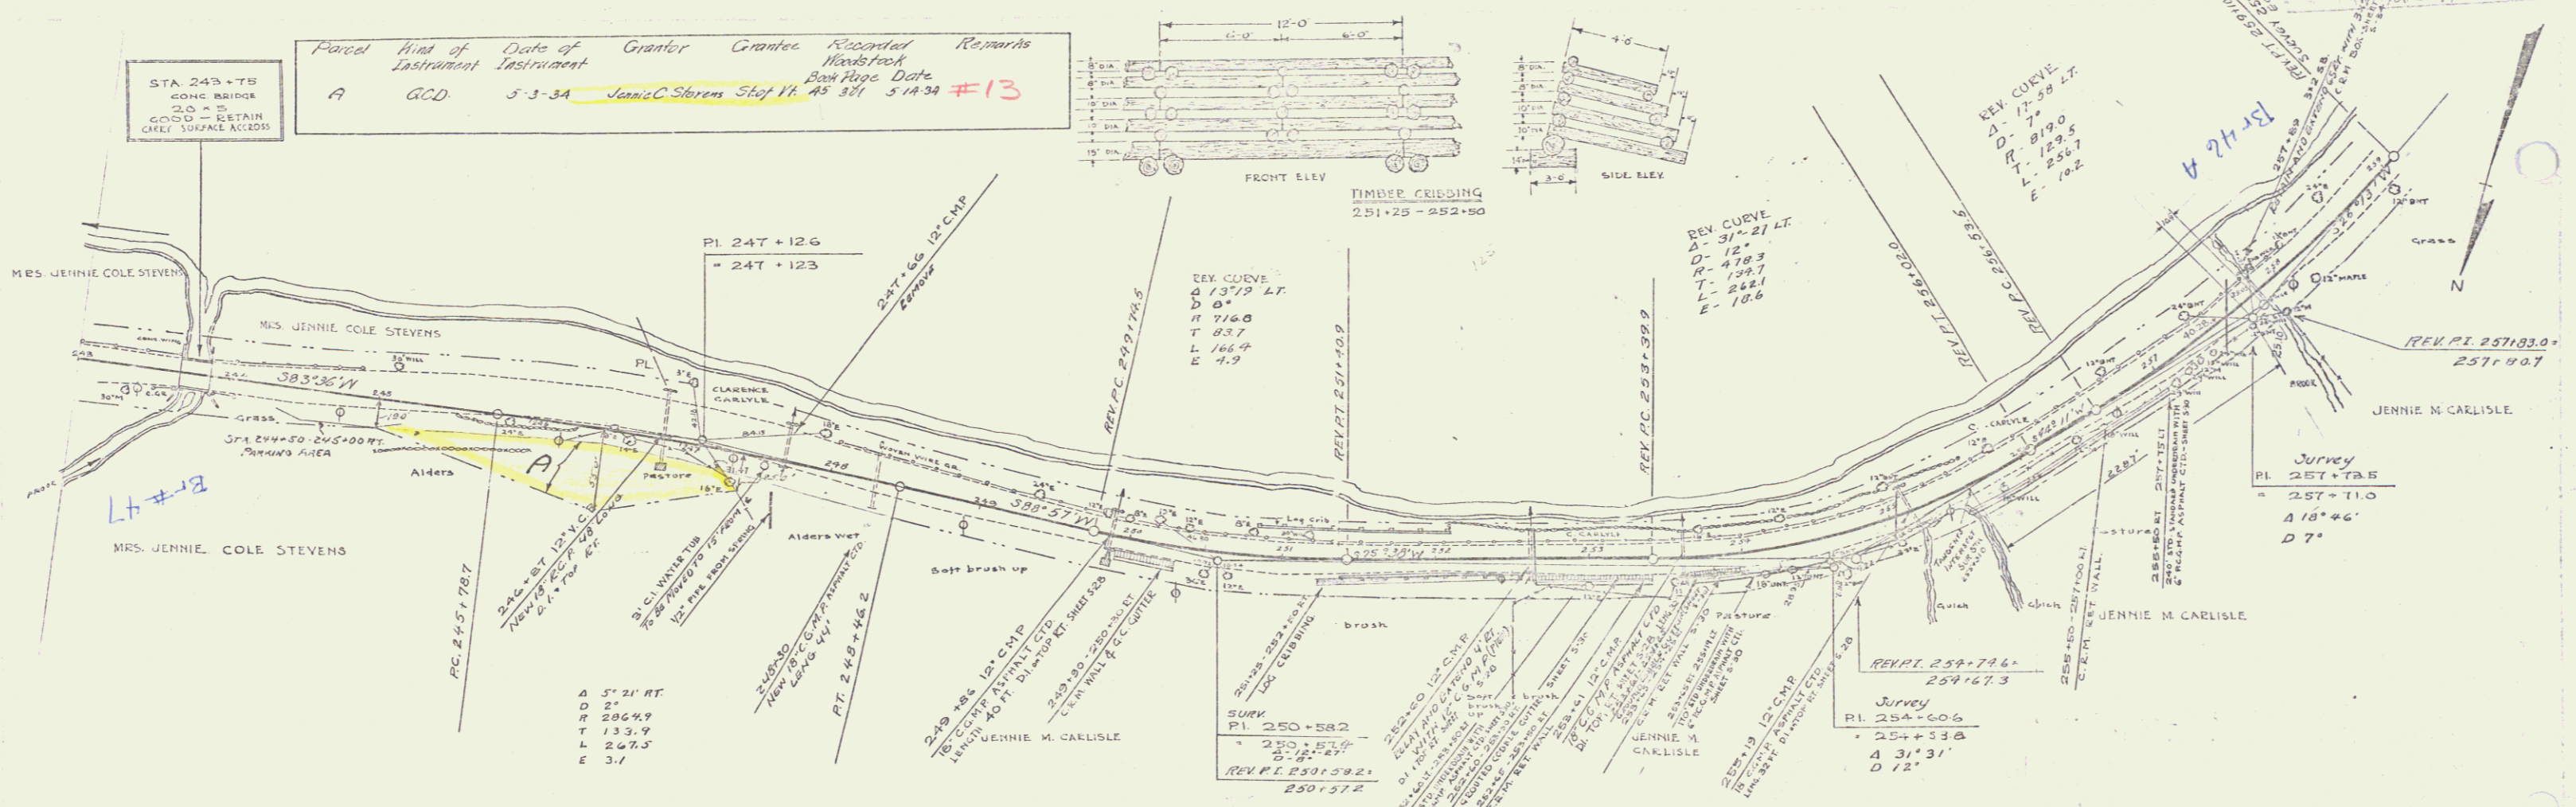

Series N.R.H. No. 108-D
Sheet 10 of 140