



PUTNAM  
MAGNET  
TRACED

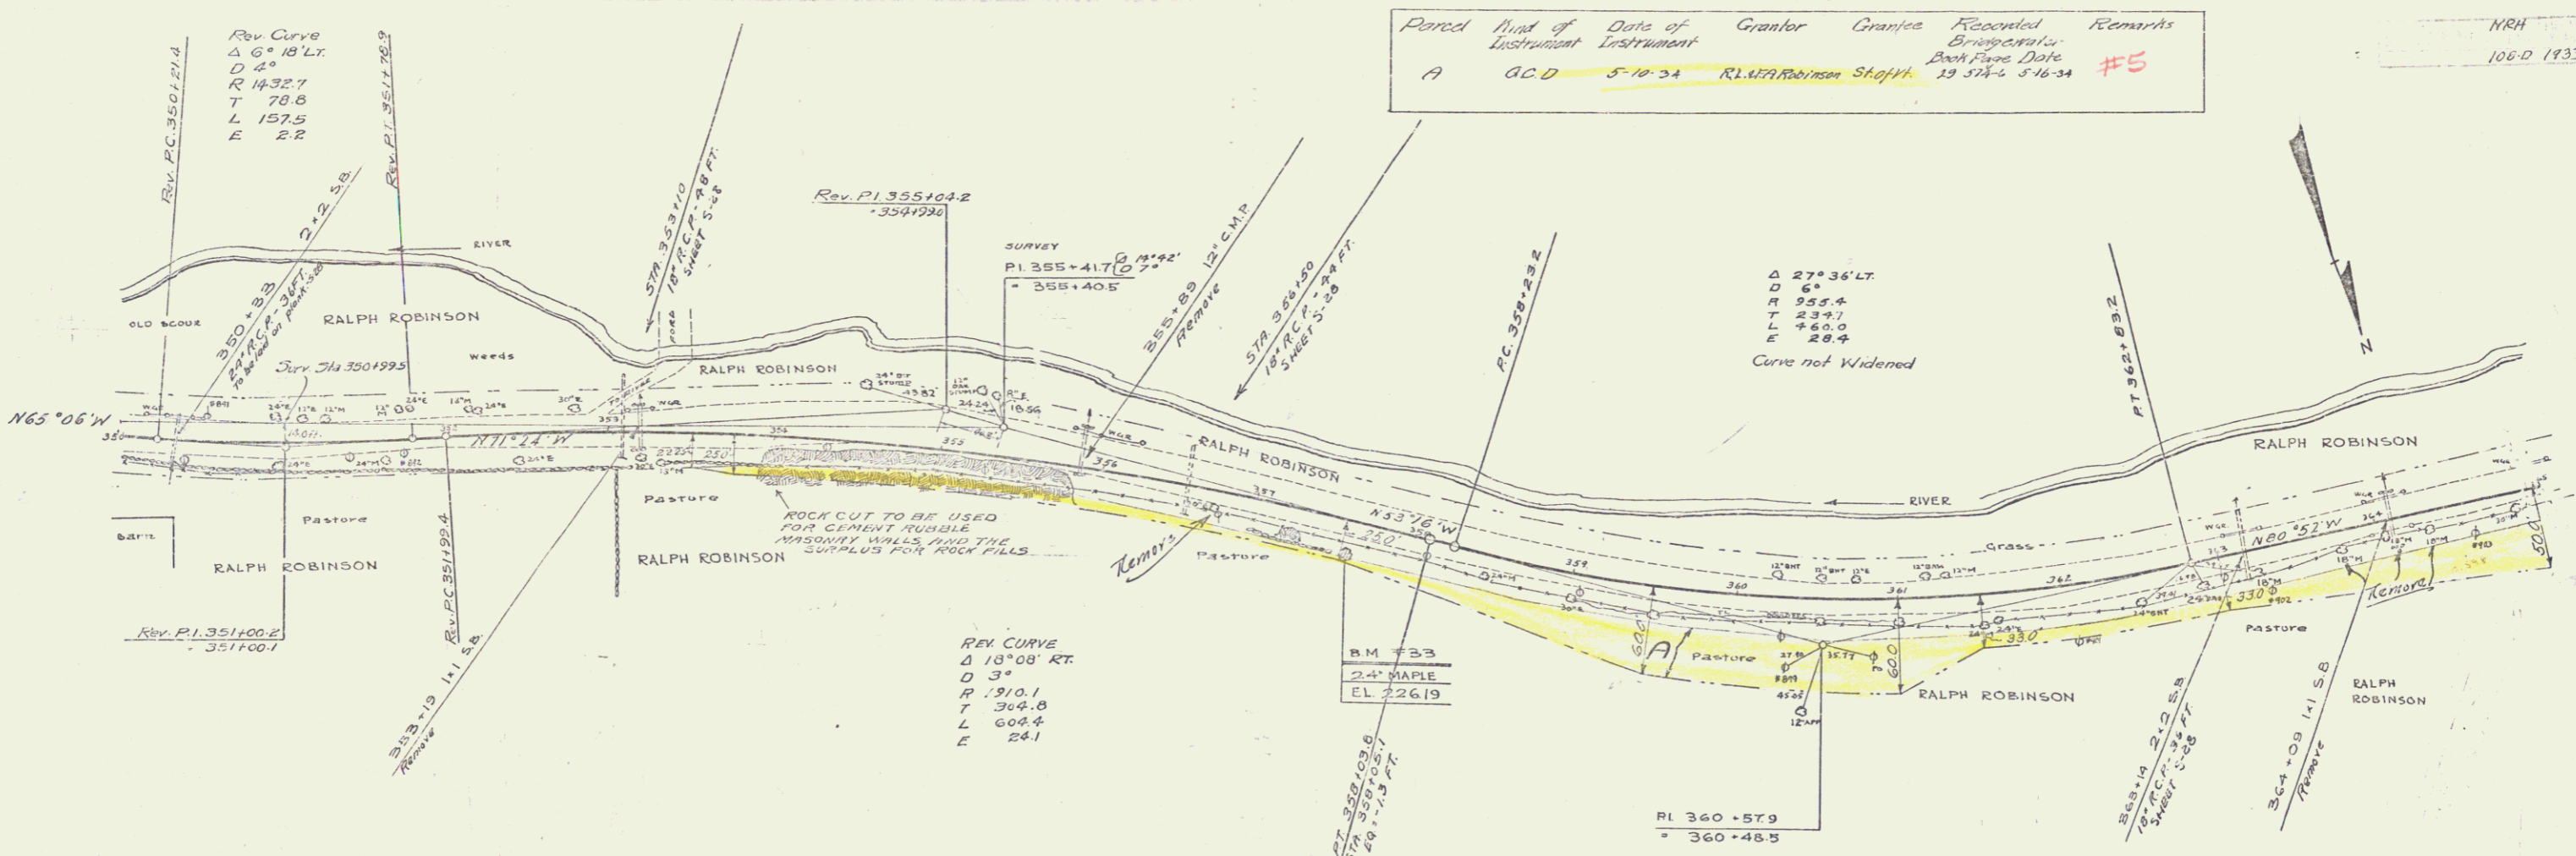

Parcel	Kind of Data of Instrument	Grantor	Grantee	Recorded	Remarks
A	G.C.D.	5-10-34	R.L. Robinson	Sheffh.	19 374-5 546-34 #5

MRH  
 106-D 1933 25 140

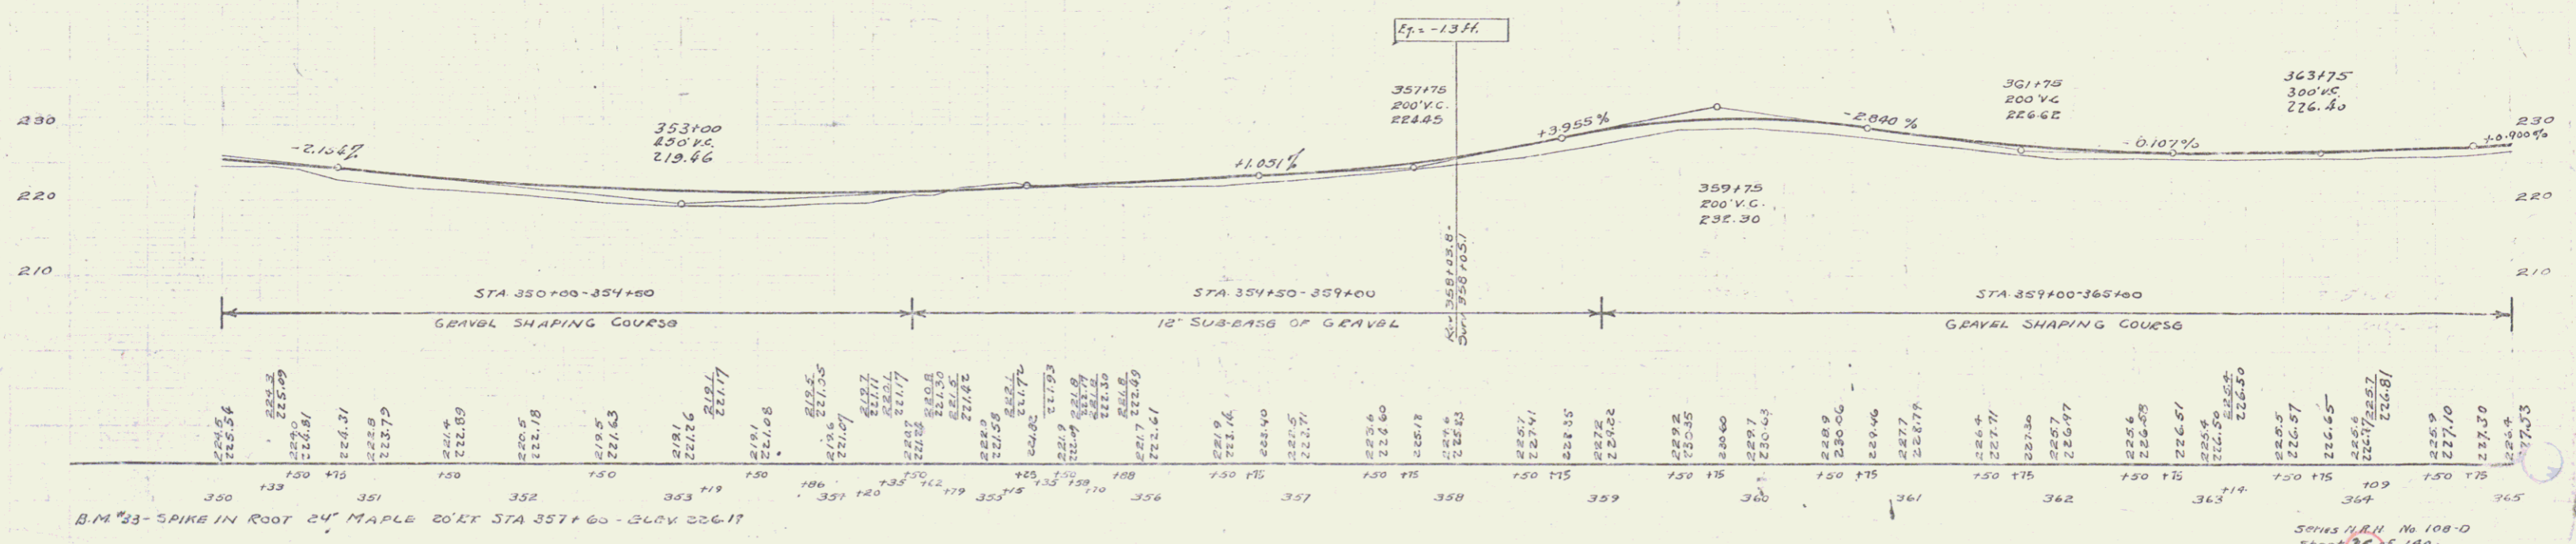

50th S.D.R.H. No 108-D  
 Sheet 25 of 140