



Parcel	Kind of Instrument	Date of Instrument	Grantor	Grantee	Recorded	Remarks
A	WD	5-10-31	Es. Eva Stevens	Stef. W.	25 378-3	5-16-34 #3
A & B	GCD	5-10-31	H.C.L. Shattuck		25 377-8	5-16-34 #4

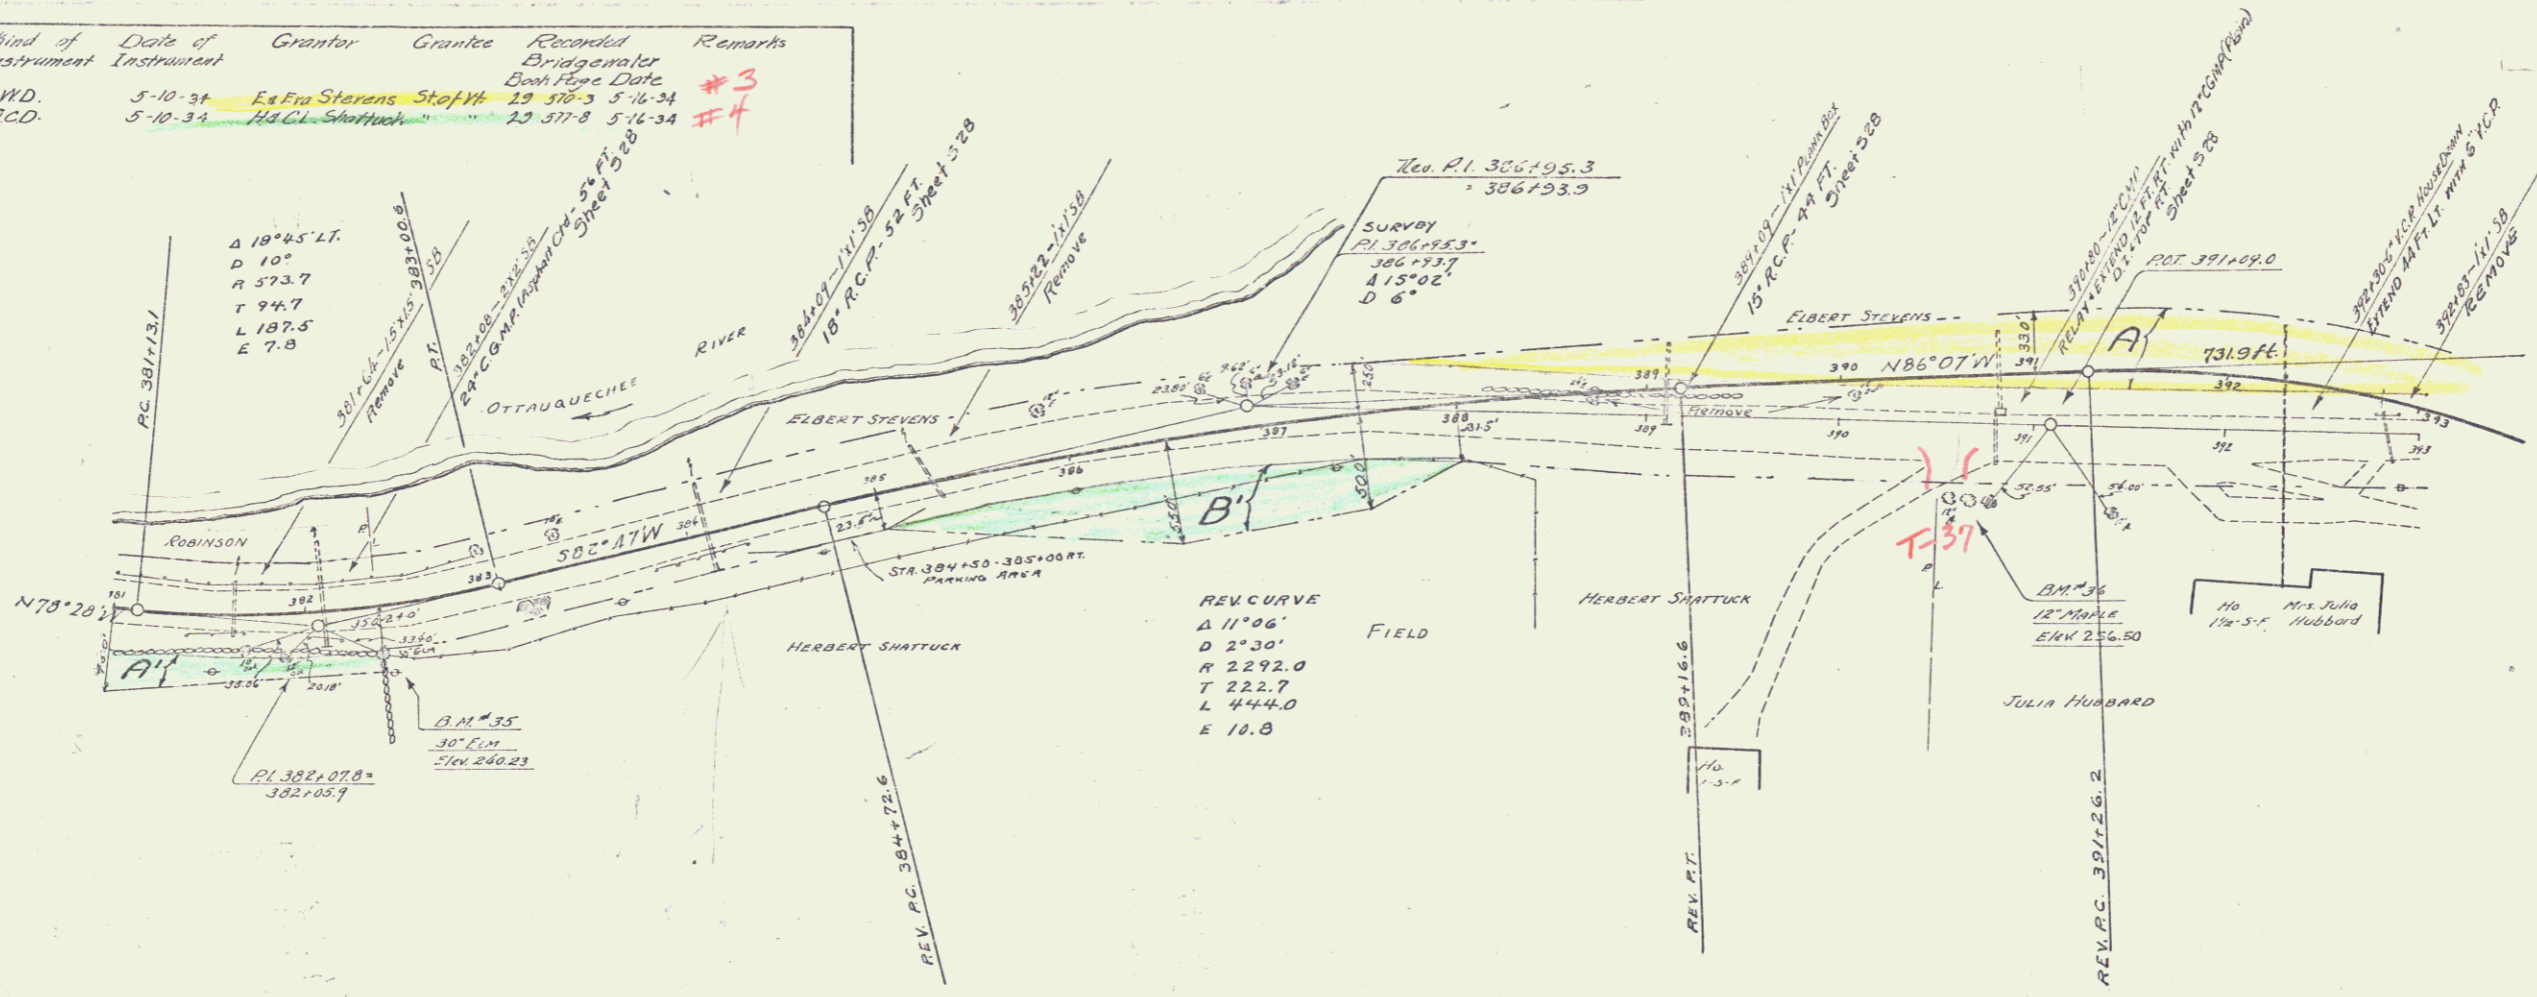

N.R.N.  
100-D 1934 27 140

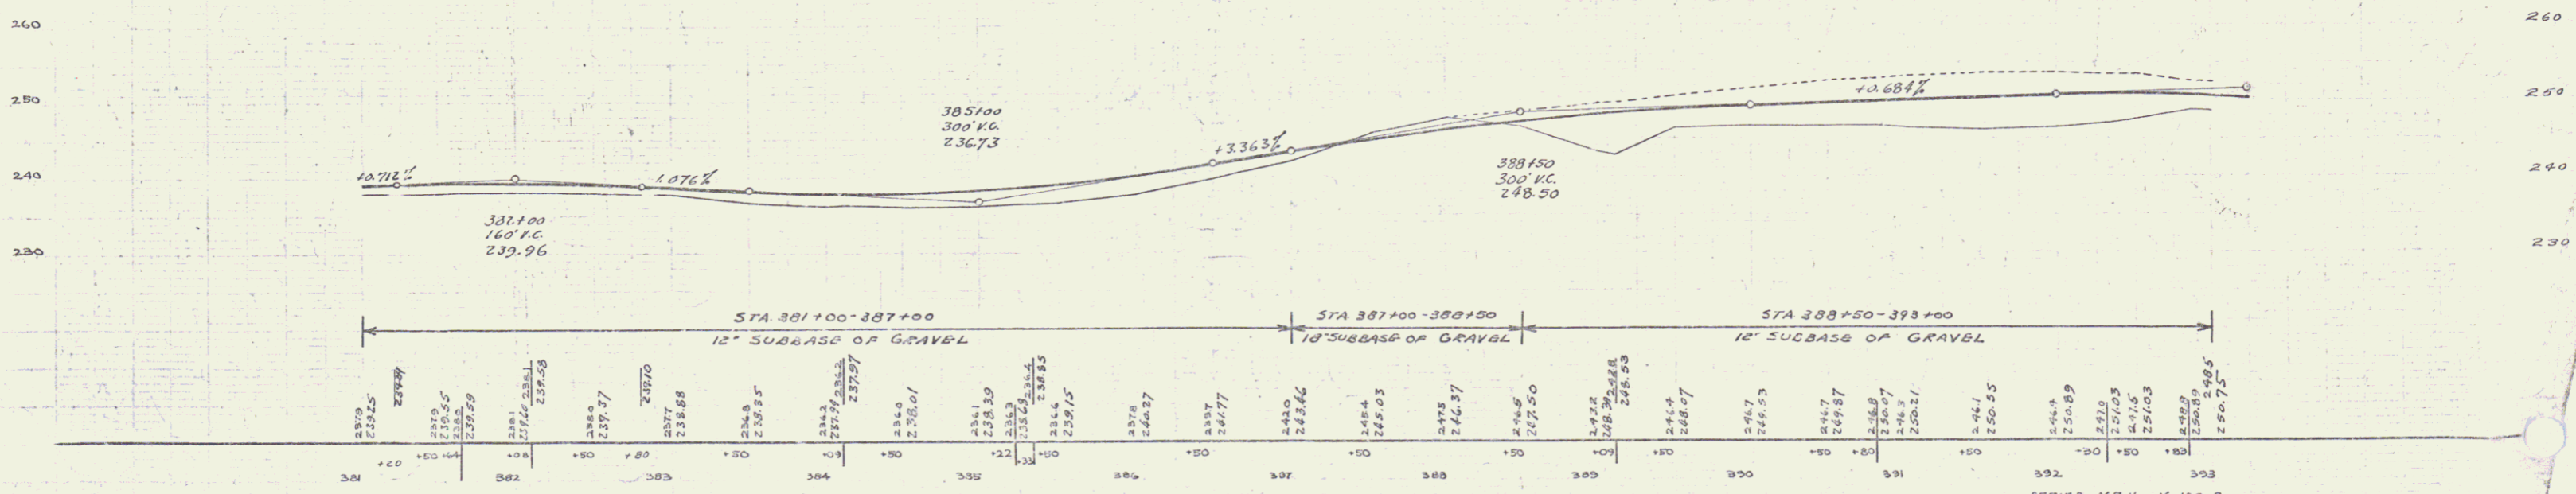

D.M. # 35 SPIKE IN ROOT 90' ELM STA. 382+37 RT. 23' EL. 240.23  
 D.M. # 36 " " " 12' MAPLE " 390+65 RT. 33' EL. 256.50

SERIES N.R.N. No. 100-D  
 SHEET 27 OF 140