
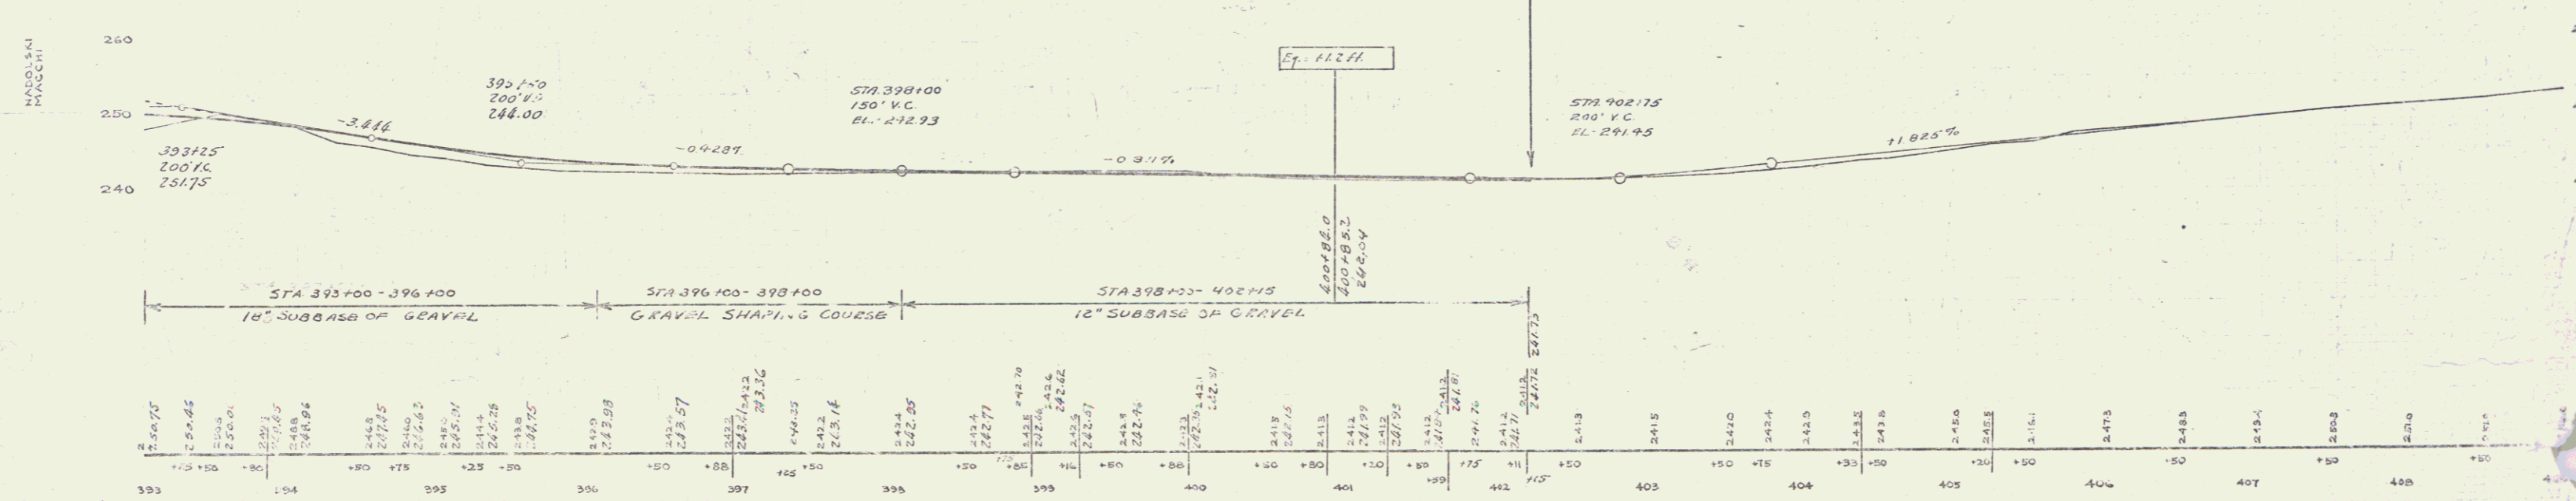


Parcel	Kind of Instrument	Date of Instrument	Surveyor	Grantee	Recorded Bridge Number	Remarks
A, B, C	W.D.	5-10-34	Ed. E. Stevens	St. W. 20 38-5	5' 16-34	Cul. Sh. 394HS

#3

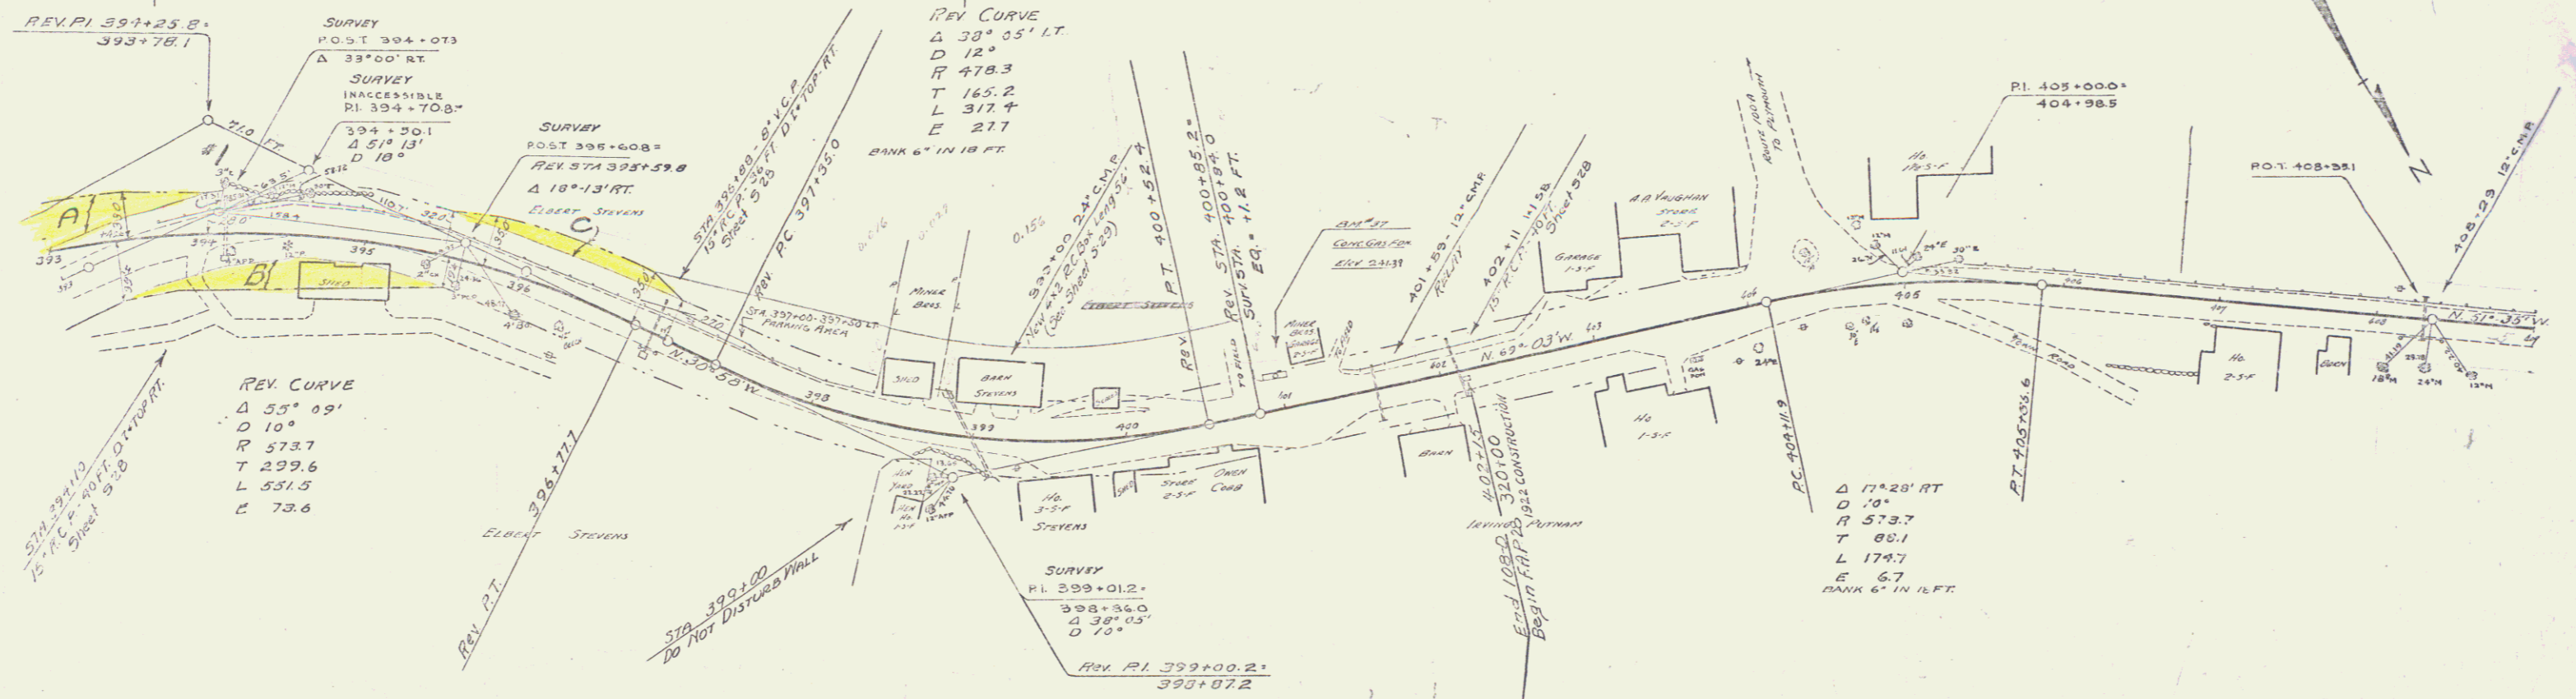

18" SUBBASE OF GRAVEL  
GRAVEL SHOULDER COURSE  
12" SUBBASE OF GRAVEL