
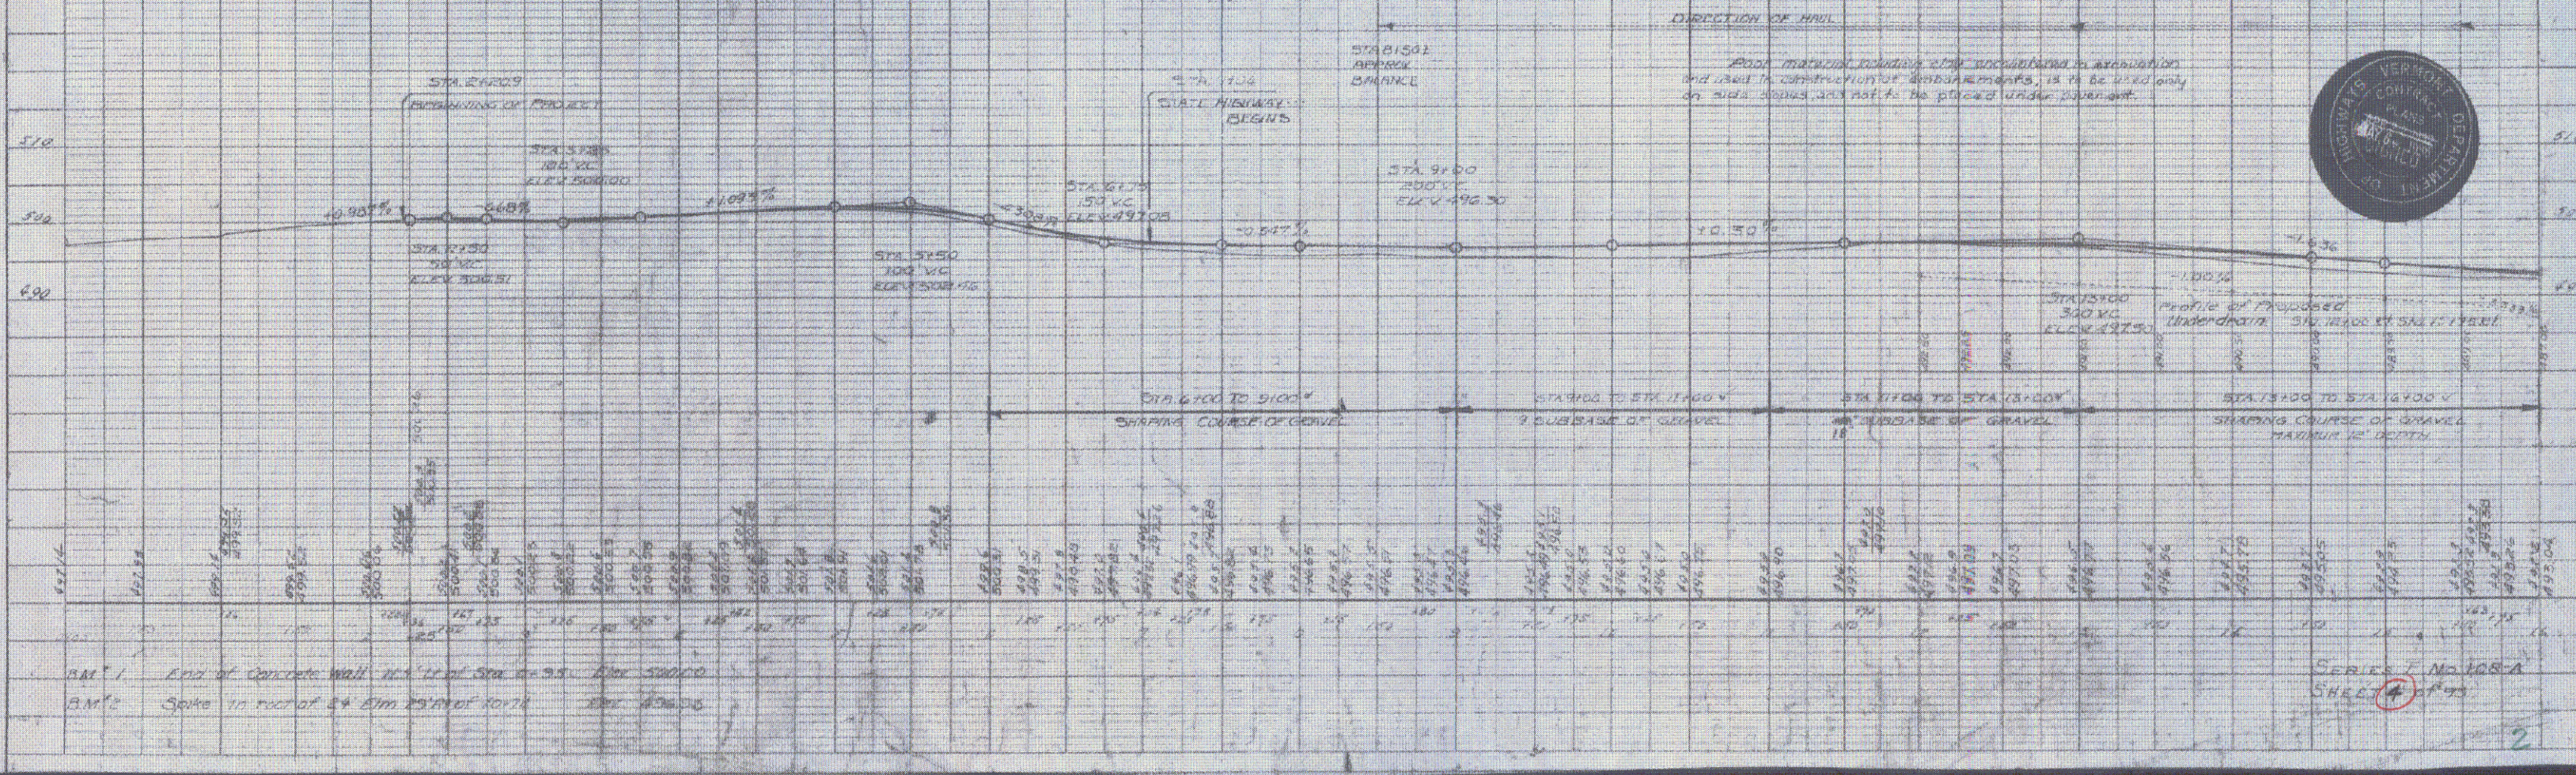


WOOD GUARD RAIL
 CULV. STA. LEFT ABUT.
 9+55.24 24
 15+68.24 24

WOOD GUARD RAILS
 STATION LEFT RIGHT
 7+87.4 64 72
 9+55.24 4 12
 15+68.24 4 1

ST. INTERSECTION WITH FERRY RD.
 STA 75+00
 13+00.00 88
 13+00.00 88

REINFORCED CONCRETE PIPE CULVERTS
 STATION SIZE LENG CONC. A CONC. GRM REINF STEEL
 9+45 40' 40' 1.80Y 1.0CY 40#
 15+75 15' 152' 2.5CY 1.4CY 157.50

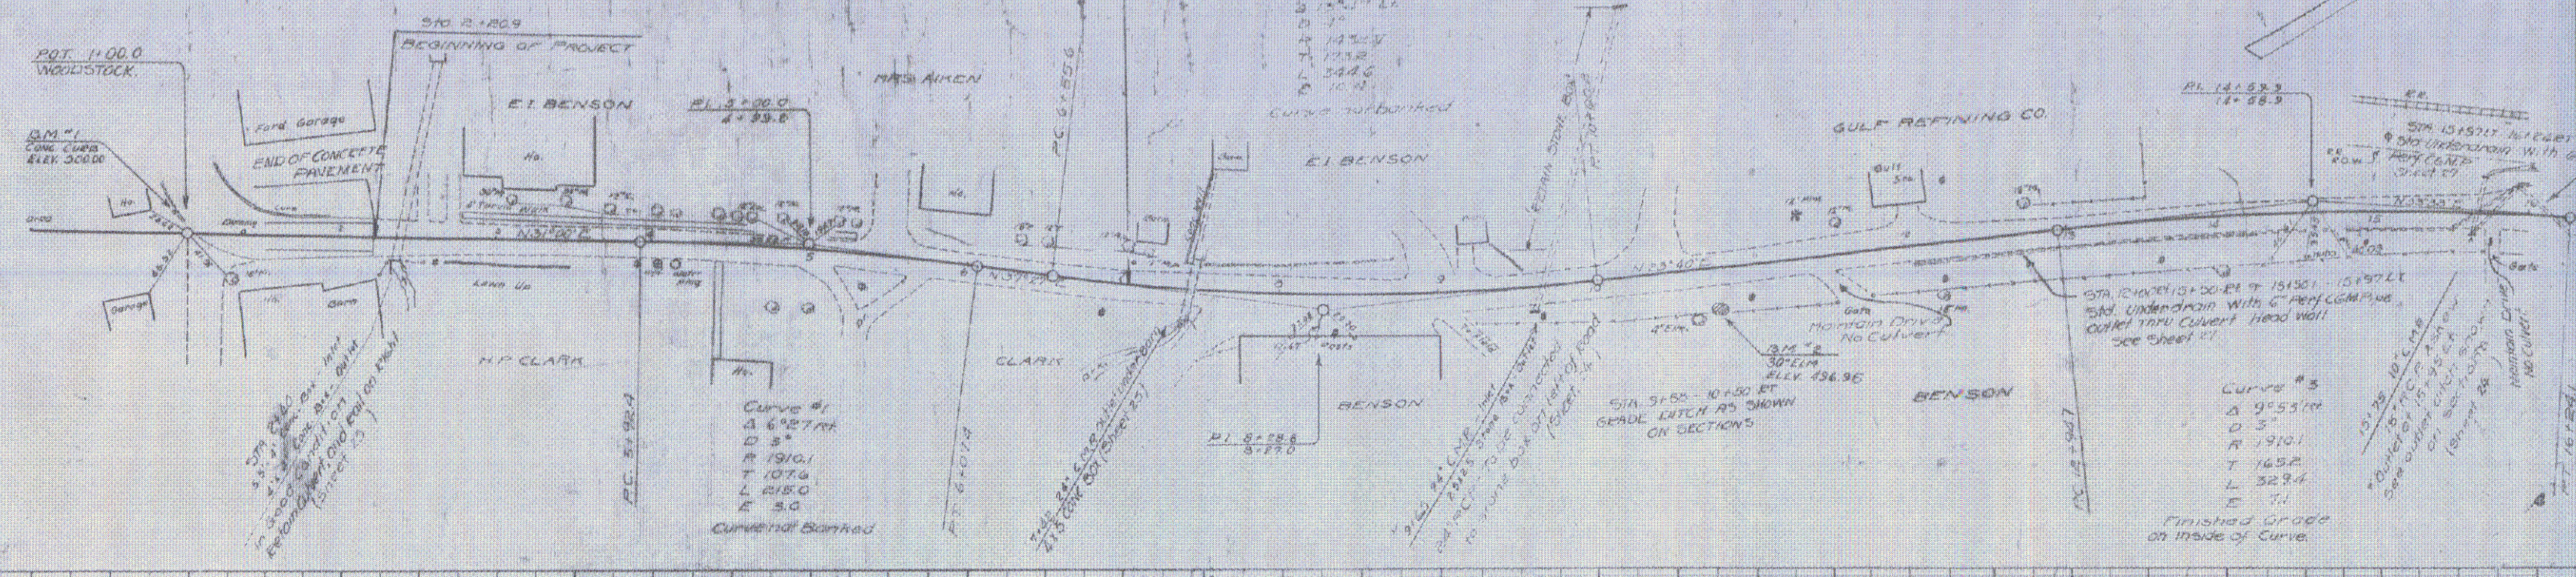

BM 1 END OF CONCRETE WALL 10' N. OF STA 1+00.00 ELEV 100.00
 BM 2 Spike in foot of 24" dia. stone pier 10' N. OF STA 1+00.00 ELEV 100.00

SERIES NO. 108-A
 SHEET 4 OF 4