

GRADE POINTS OF WOOD

STATION	ELEV.	REMARKS
191+00	44.00	
191+20	44.00	
191+40	44.00	

WIND SQUARE DATA

STATION	ELEV.	REMARKS
191+18	44.00	
191+38	44.00	
191+58	44.00	

CHECK POINT DATA

STATION	ELEV.	REMARKS
191+00	44.00	
191+20	44.00	
191+40	44.00	

LEVEL POINT DATA




STATION	ELEV.	REMARKS
191+00	44.00	
191+20	44.00	
191+40	44.00	

REMARKS ON PIPE SIZES

STATION	PIPE SIZE	REMARKS
191+15	30"	Concrete - 18' span
191+35	30"	Concrete - 18' span
191+55	30"	Concrete - 18' span

100 1912 16 35

PLUM
NOTE: SEE SHEET 15 FOR
REMARKS ON PIPE SIZES

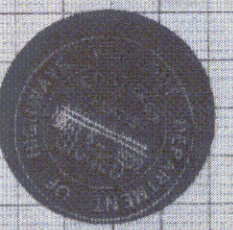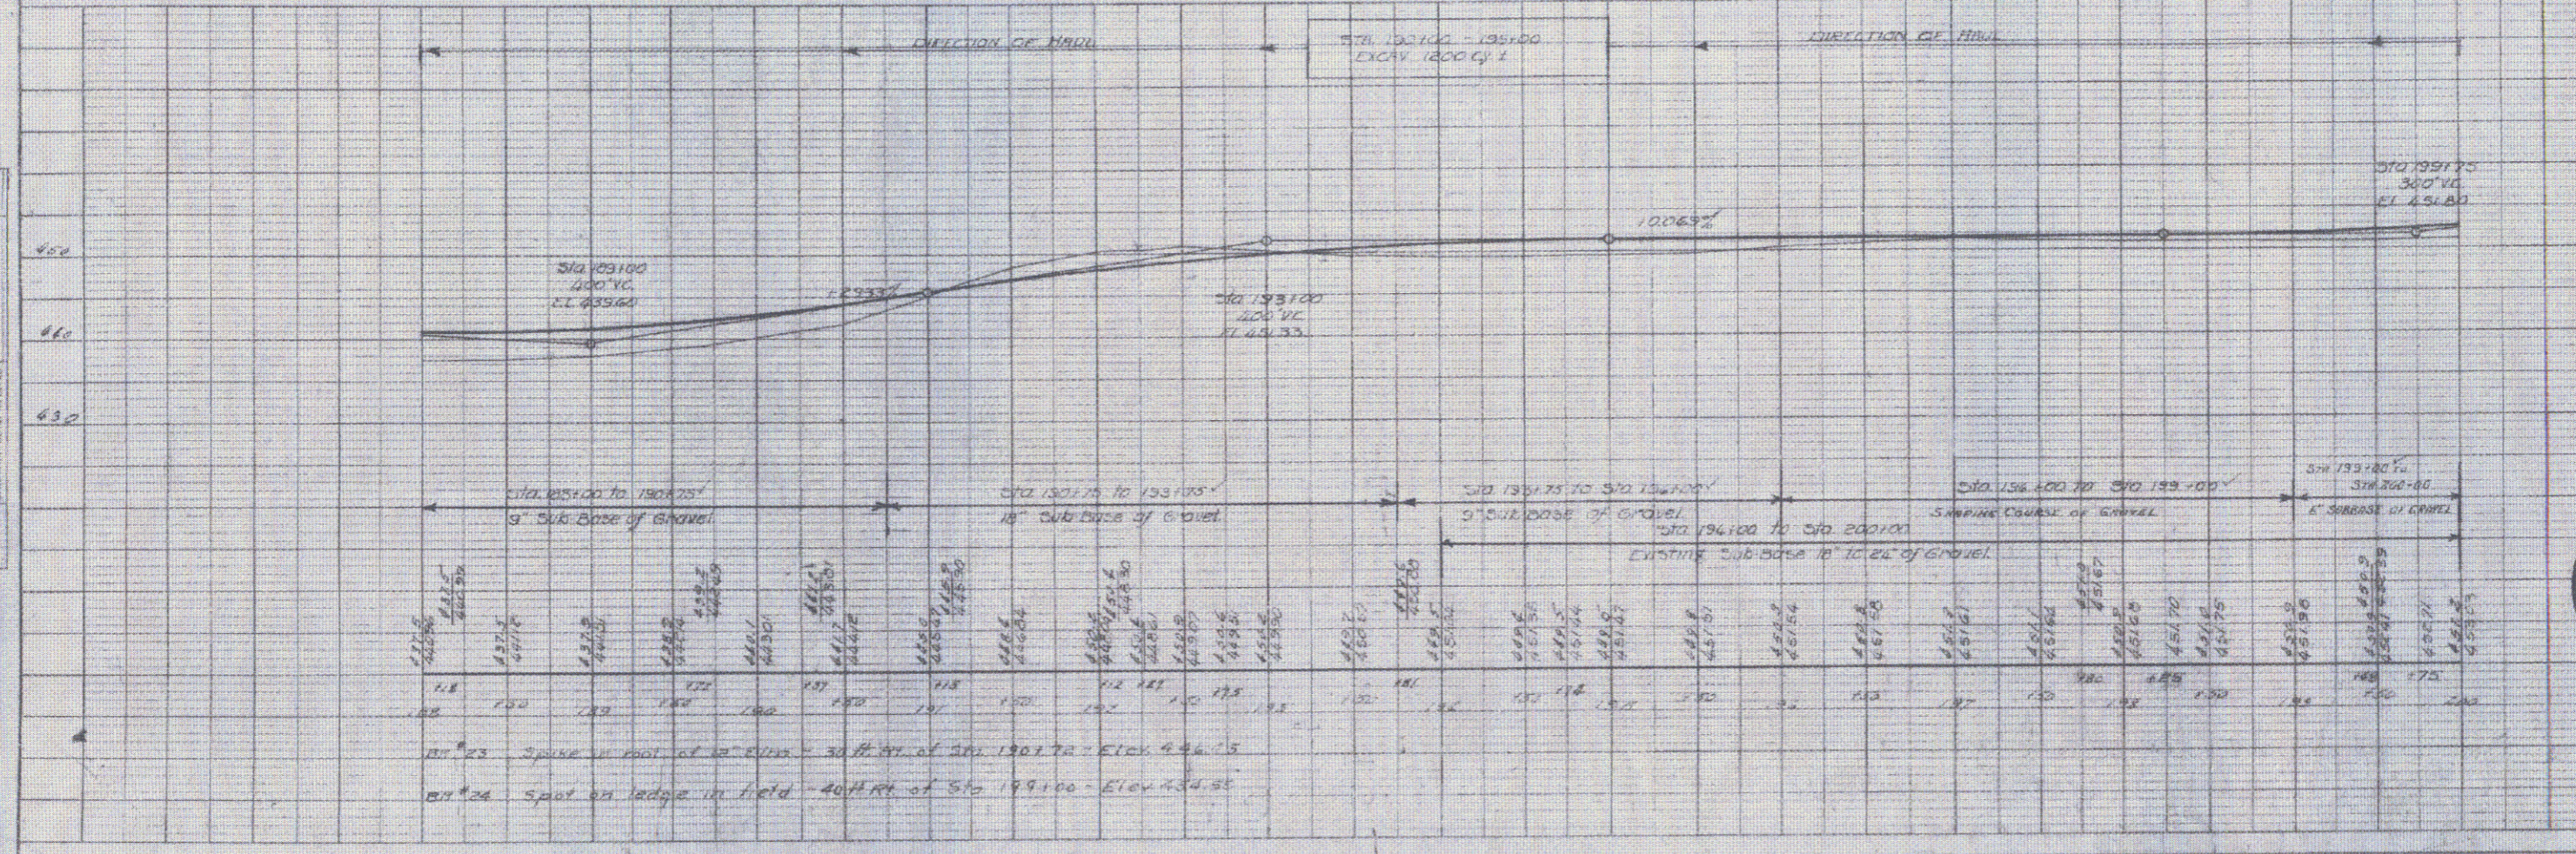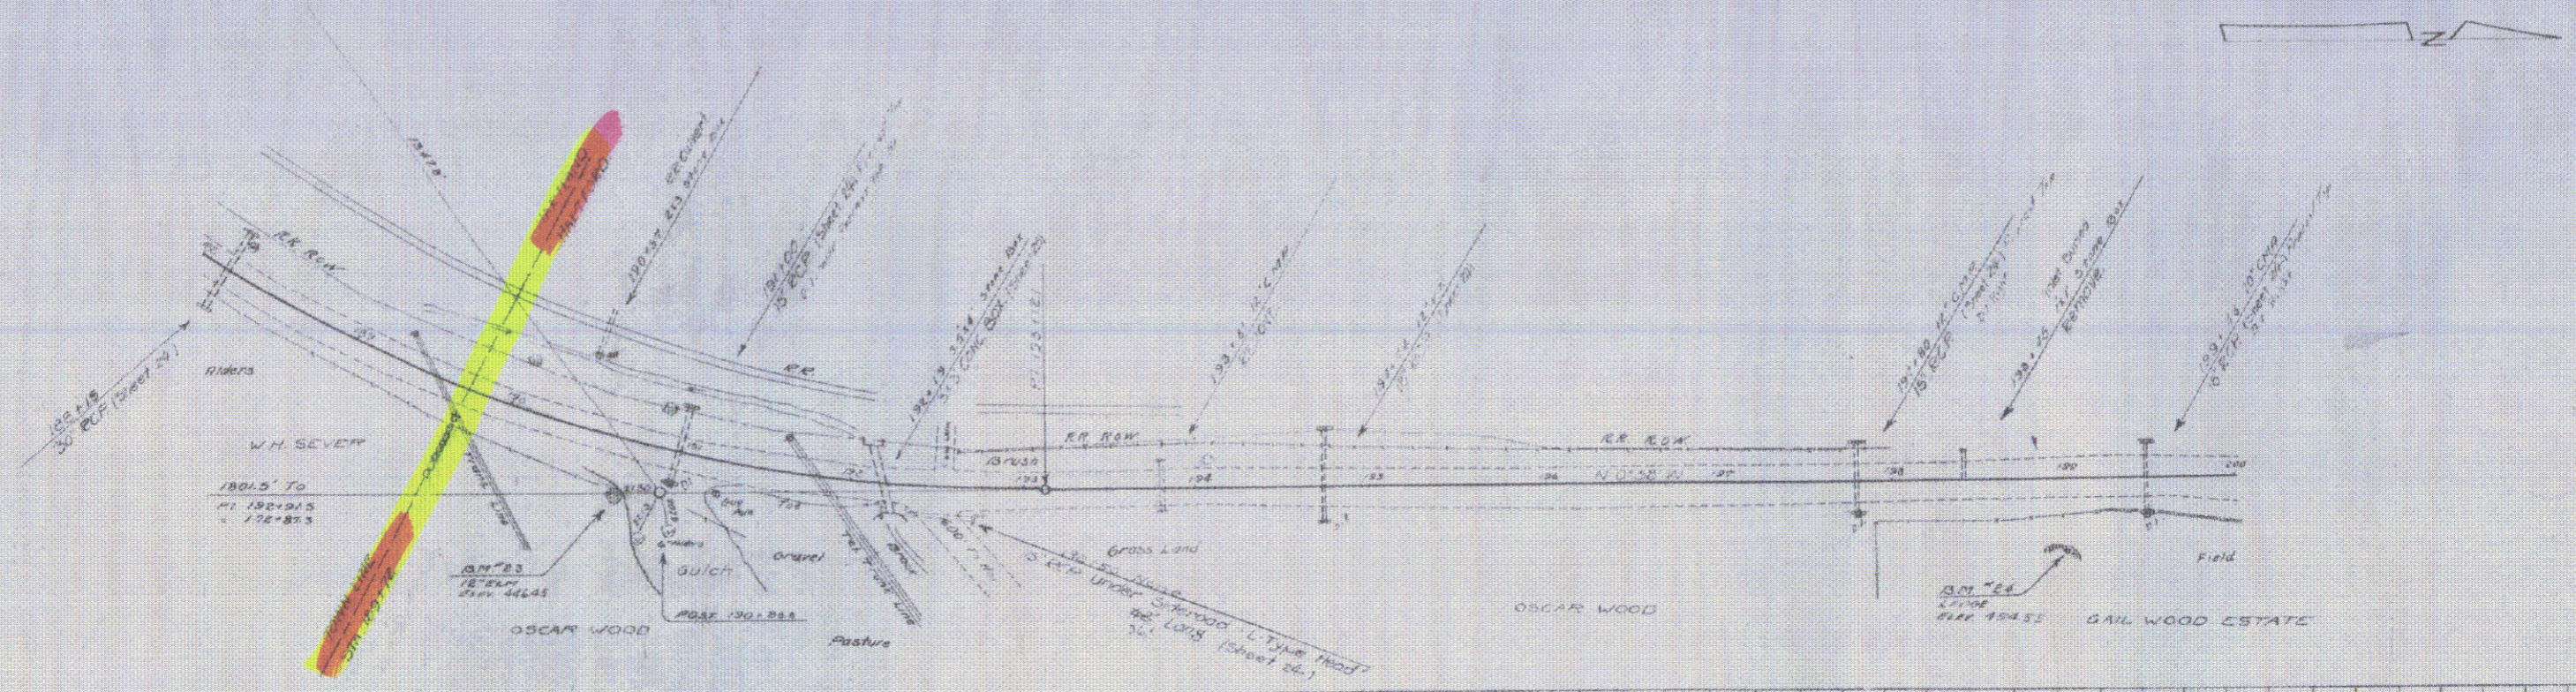

SHEET 16 OF 25