

**EXISTING POINTS OF WOOD**

200+00	1
204+20	1
200+85	1
211+20	1
218+19	1

**WOOD CENTER LINE**

200+00	10
204+20	10
207+05	10
209+50	10
213+19	10



**REMOVED CONCRETE PIPE CURVES**

Station	Dist	Lat	Long	Dist
204+18	10	66	20	10
207+05	10	66	20	10
211+00	10	68	14	100
20+19	10	48	10	100

**REMOVED CONCRETE PIPE CURVES**

Station	Dist	Lat	Long	Dist
204+18	10	66	20	10
207+05	10	66	20	10
211+00	10	68	14	100
20+19	10	48	10	100

001 1032 77 35

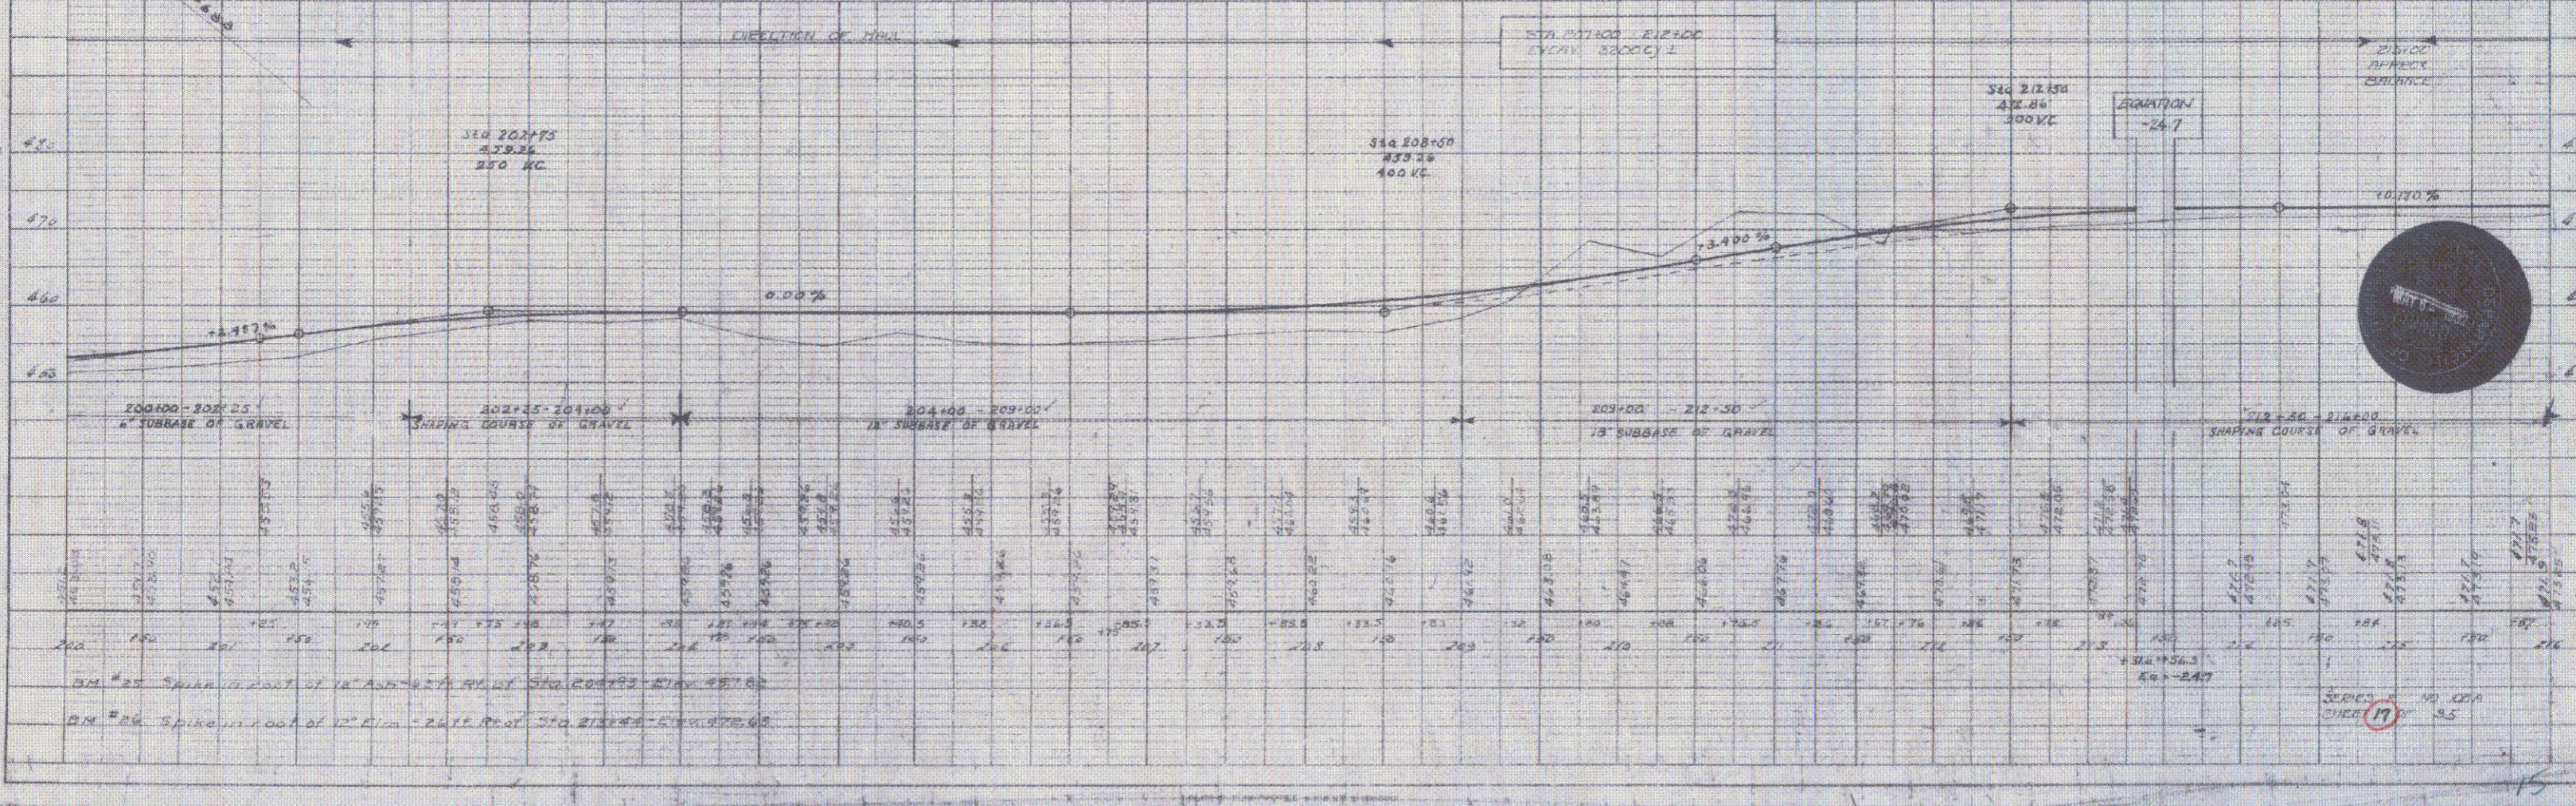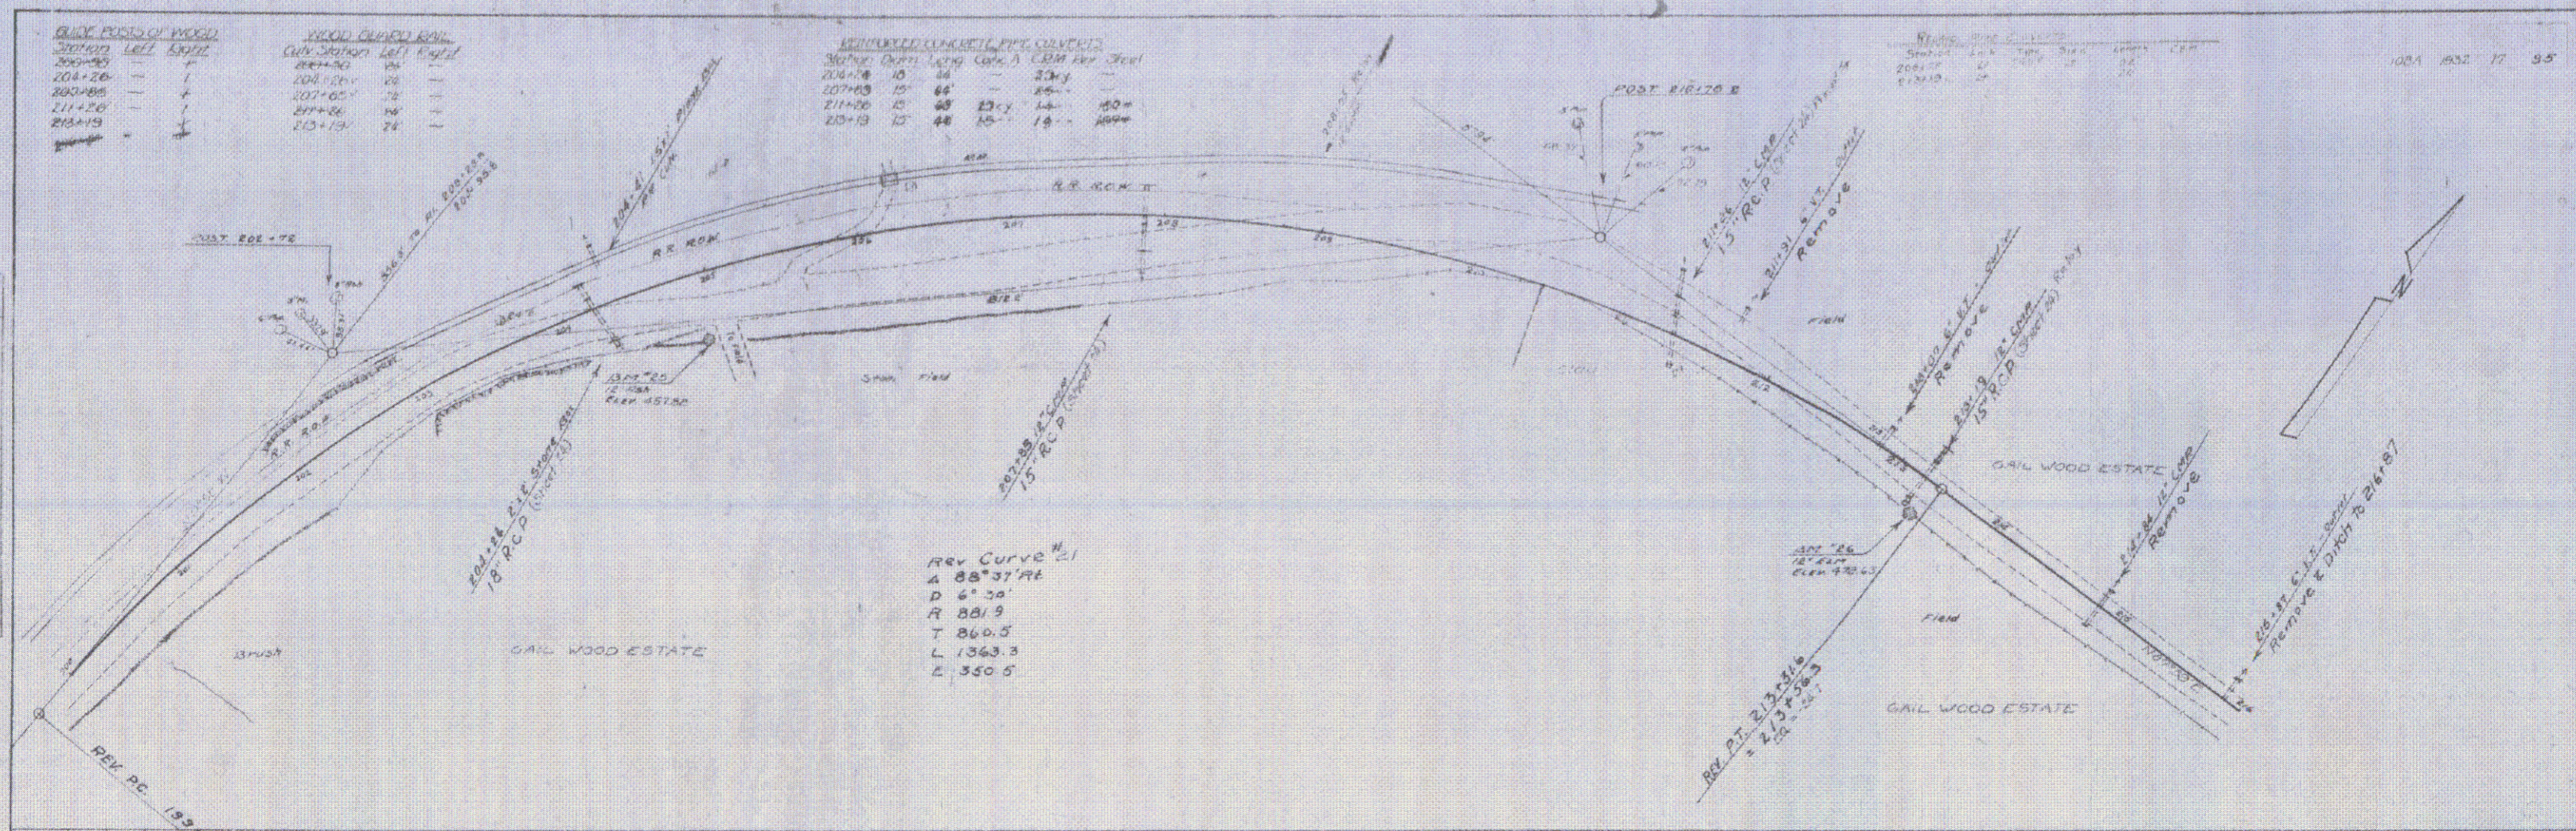

**PLAN**  
 DATE: 10/1/55  
 DRAWN BY: [Name]  
 CHECKED BY: [Name]  
 SCALE: AS SHOWN

**PROFILE**  
 DATE: 10/1/55  
 DRAWN BY: [Name]  
 CHECKED BY: [Name]  
 SCALE: AS SHOWN

STATION	ELEVATION	GRAVEL	REMARKS
200+00	460.00	2" SUBBASE OF GRAVEL	
202+75	479.25	SHIPPING COURSE OF GRAVEL	
208+50	483.25	1" SUBBASE OF GRAVEL	
212+50	487.25	SHIPPING COURSE OF GRAVEL	
218+19	491.25	SHIPPING COURSE OF GRAVEL	