

GUIDE POSTS OF WOOD  
Station Left Right  
216+07 - 1  
220+29 - +

WOODLAND EMB  
Cur Station Left Right  
216+07 - 1  
220+29 - +



LARK CEMENT  
Station Station Left Right  
219+28 221+80 L 206 80 240 236  
219+28 221+80 R 48 20 26

STANDARD CONCRETE CURVE  
Station Station Left Right  
220+29 221+80 L 150.7 144 180  
220+29 221+80 R 48 20 26

STANDARD CONCRETE CURVE  
Station Station Left Right  
220+29 221+80 L 150.7 144 180  
220+29 221+80 R 48 20 26

NOV 10 1935

PLAN  
DATE  
BY  
CHECKED  
APPROVED

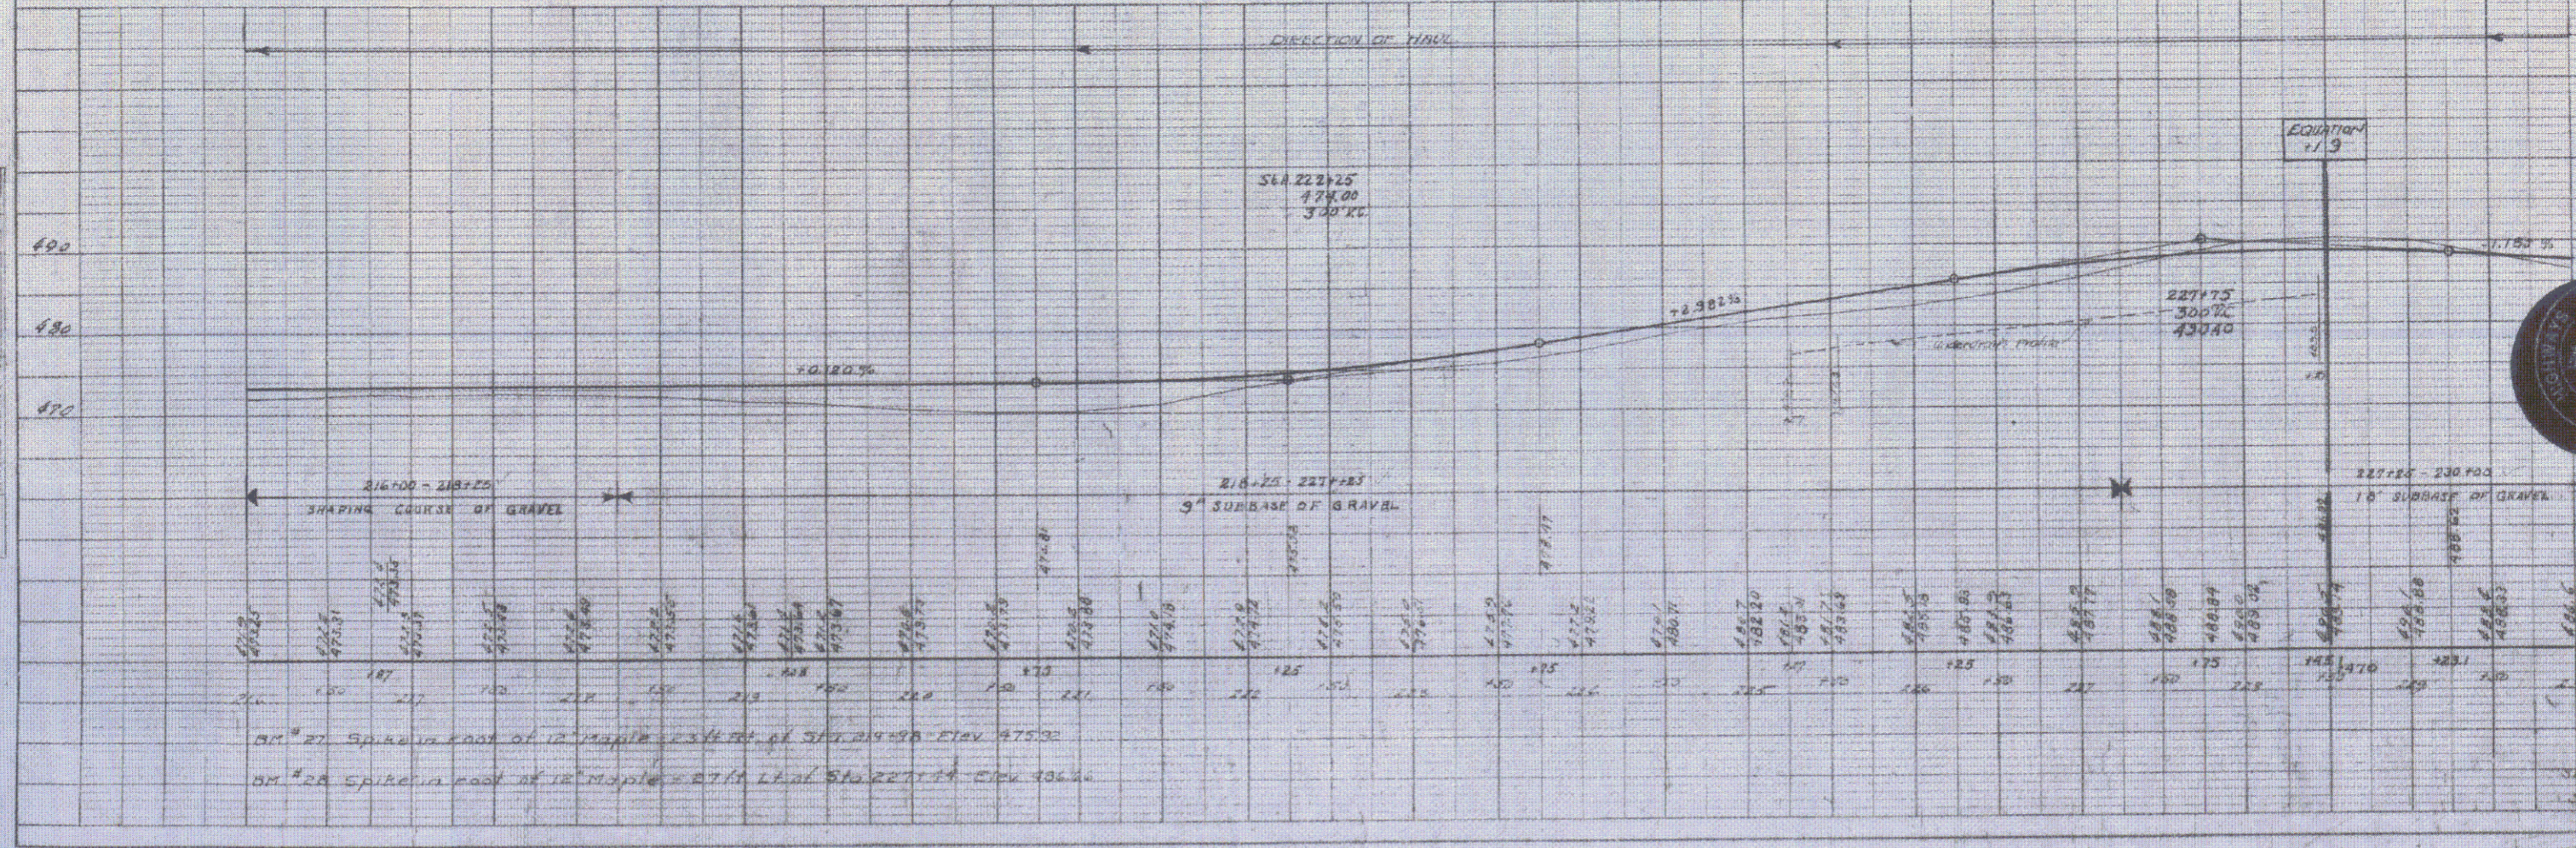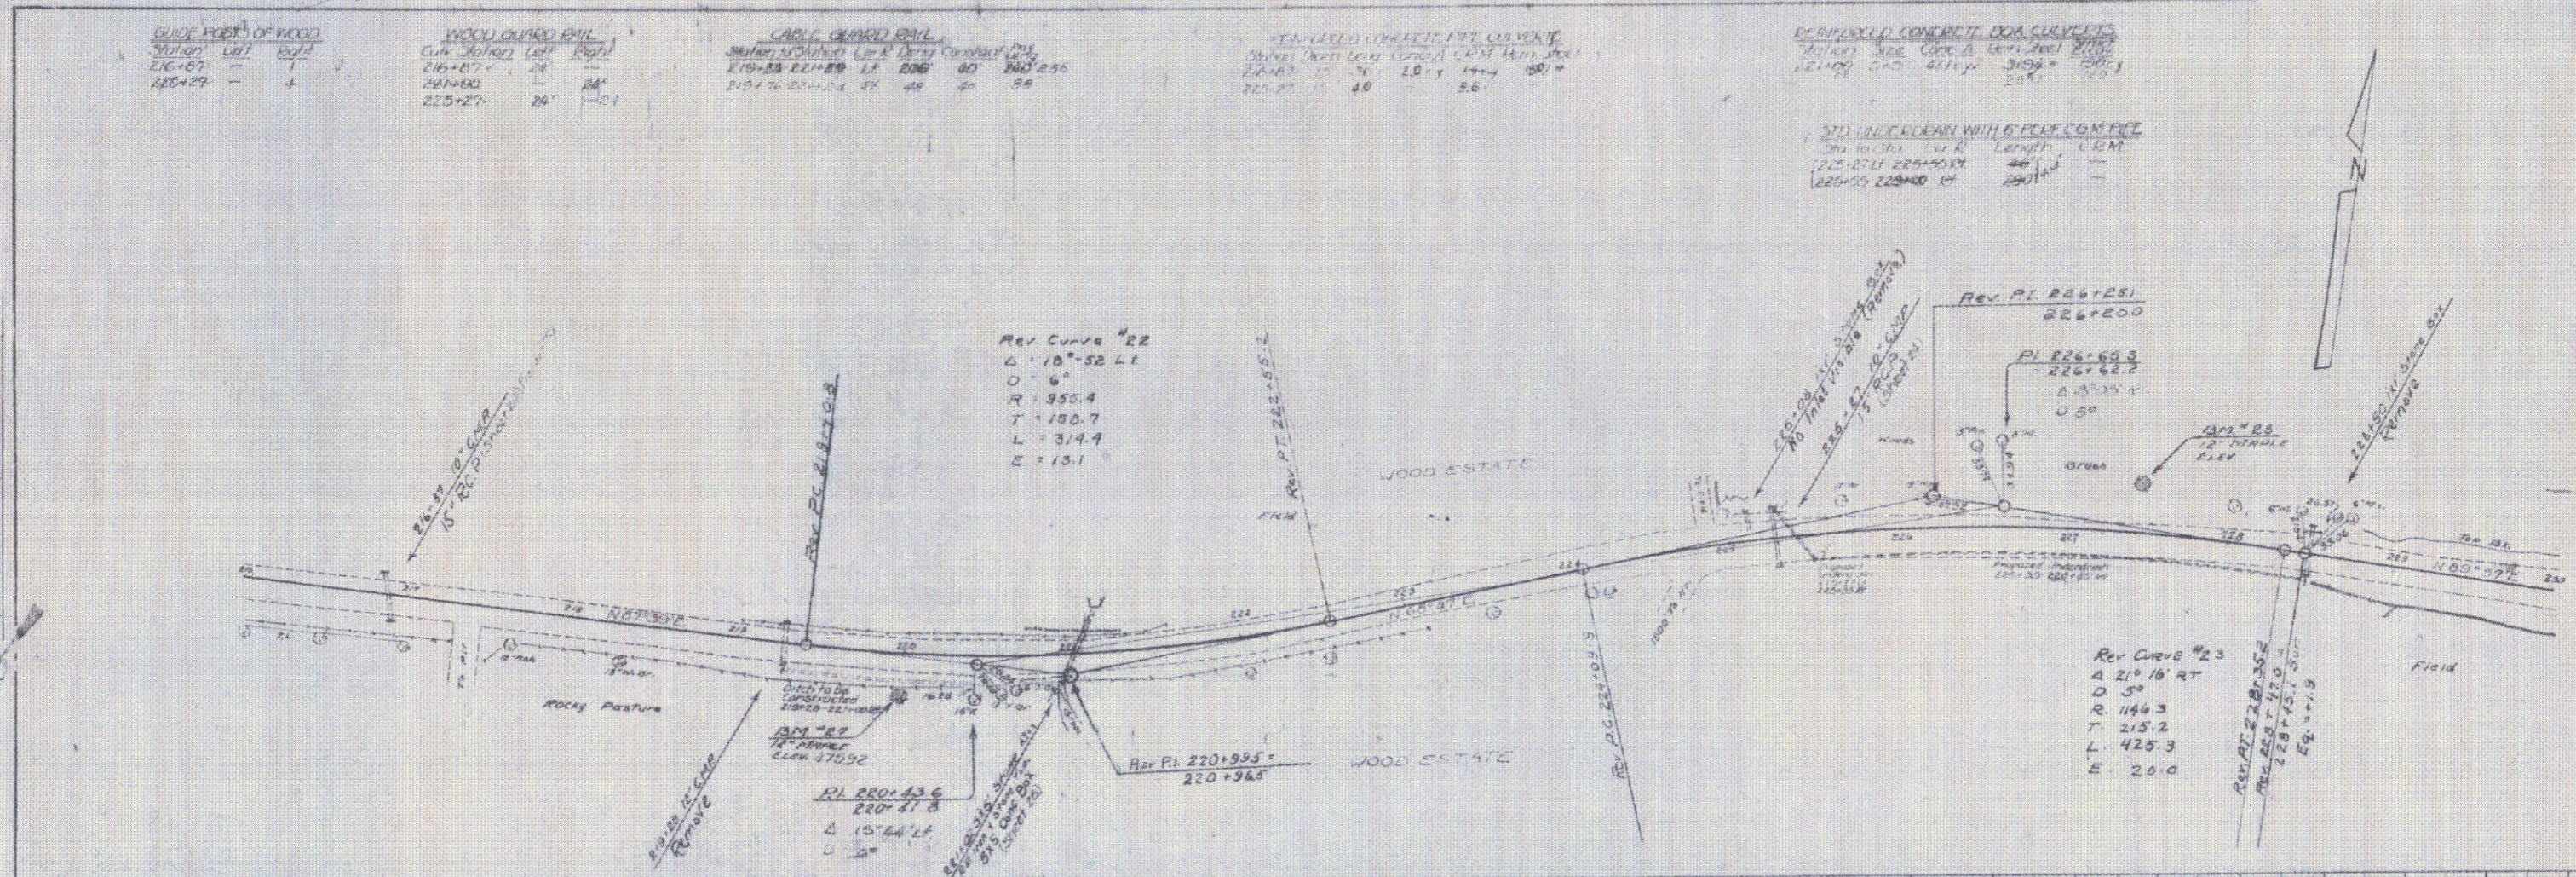

PROFILE  
DATE  
BY  
CHECKED  
APPROVED

BM #27 Spike in East of 12" Maple 234.60 at Sta. 219+50 Elev 475.32  
 BM #28 Spike in East of 12" Maple 271.14 at Sta. 227+14 Elev 406.66

SHEET 18 OF 19