
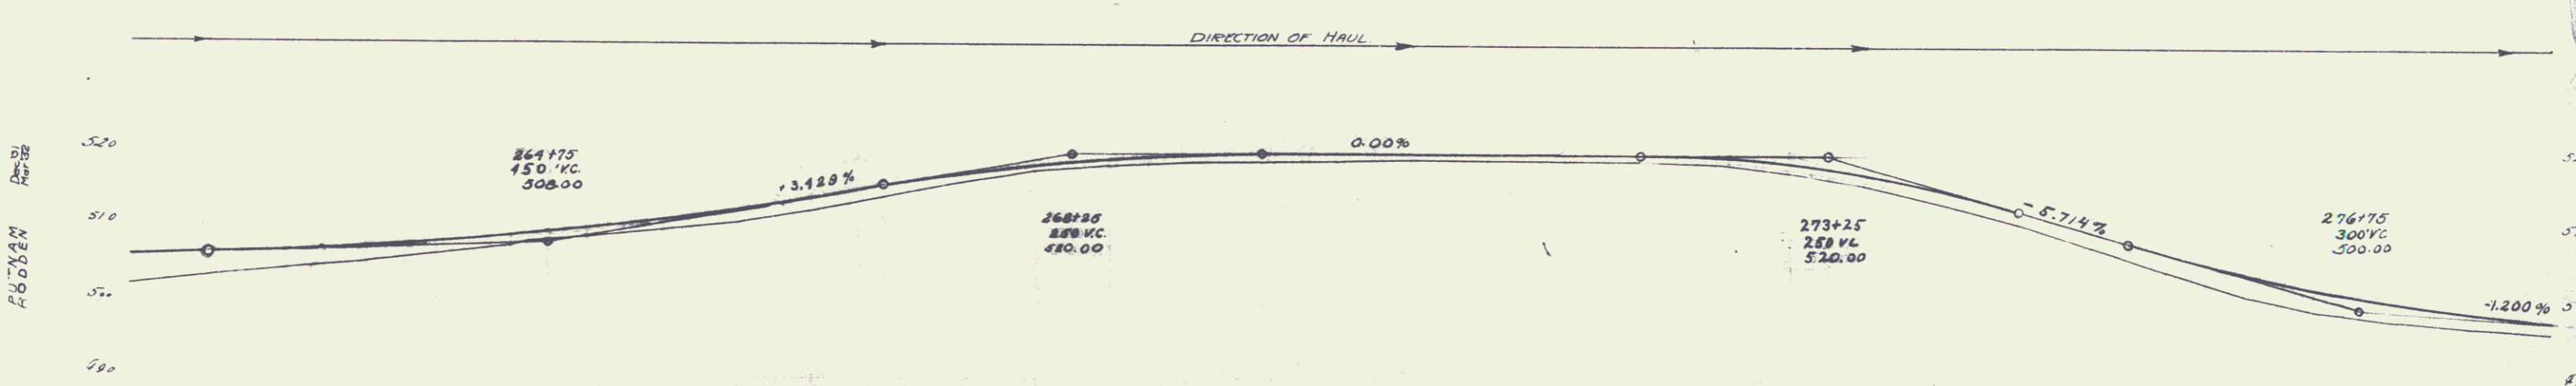


Station	Left	Right
264+64		

Station	Left	Right
264+64	24'	24'
269+40	24'	24'
277+06	24'	24'

**REINFORCED CONCRETE PIPE CULVERTS**  
 Station Data: Left Corc. A CBM Rein. Steel  
 264+64 15' 36" 16 cy 16 cy 111"  
 269+40 15' 44" 27' -- --  
 277+06 28' 48" 36' -- --

128 1888-2  
 (LA 250471) 1955 20 3

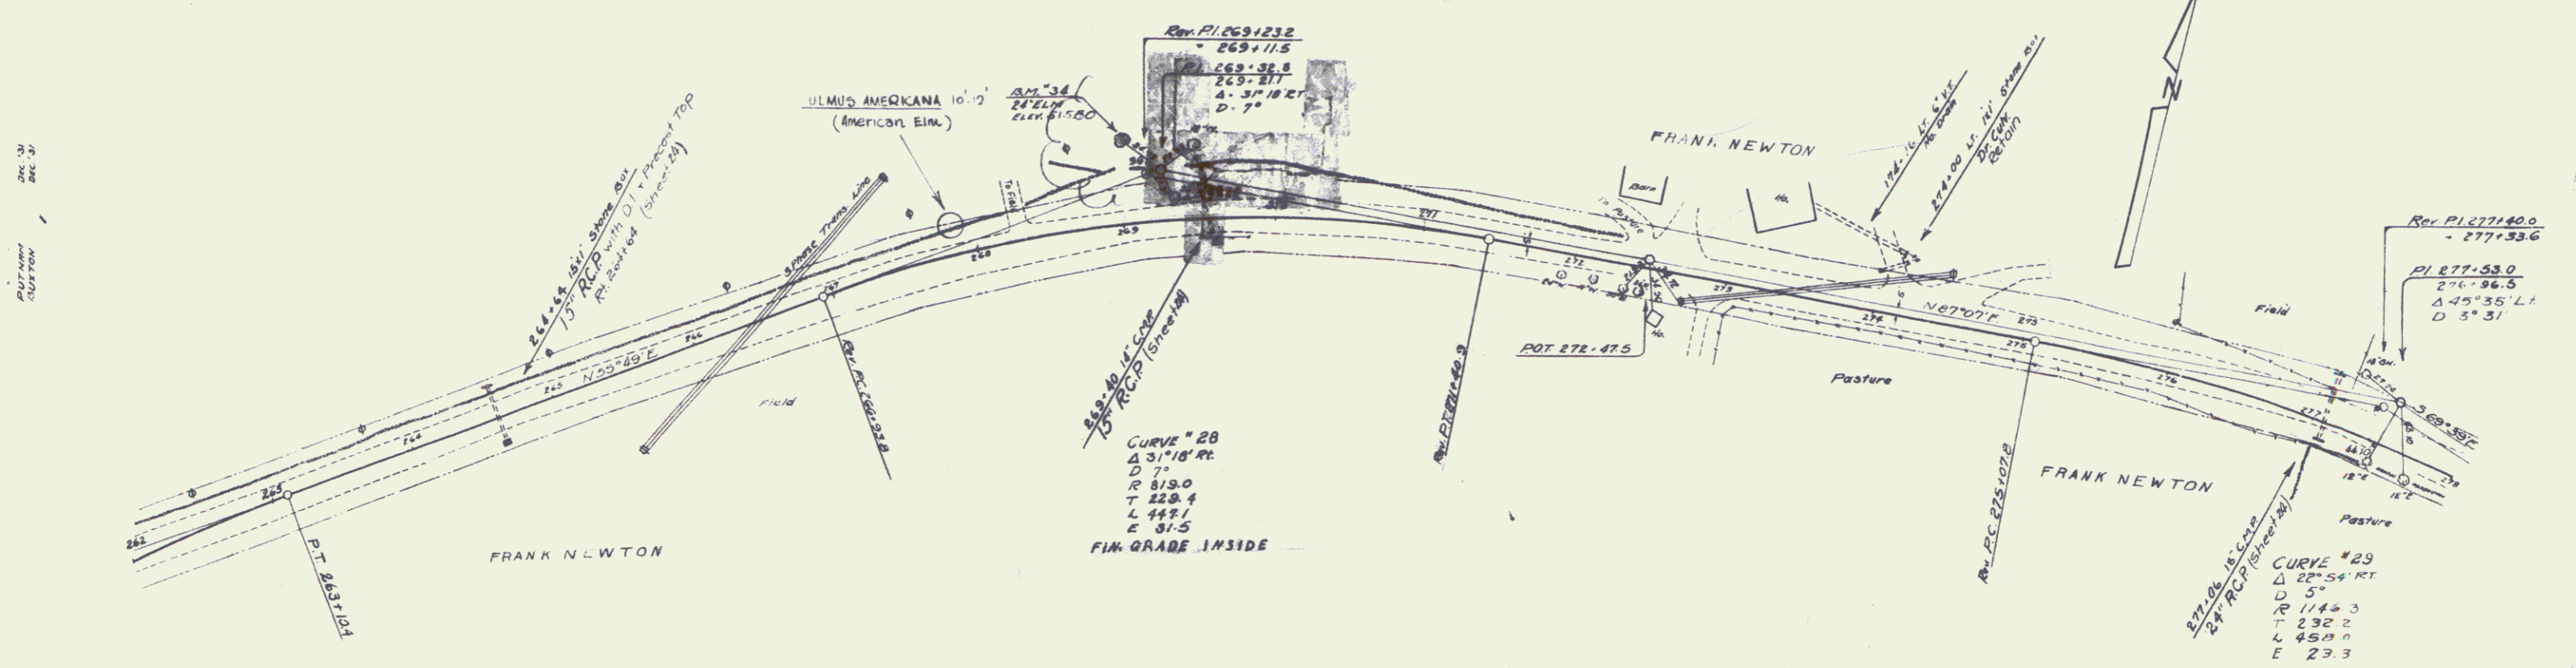

Station	Elevation
262.25	506.29
263.00	506.60
263.75	506.98
264.50	507.23
265.25	507.53
266.00	508.25
266.75	508.77
267.50	509.07
268.25	508.10
269.00	509.25
269.75	510.40
270.50	511.25
271.25	512.40
272.00	513.82
272.75	514.48
273.50	515.25
274.25	516.10
275.00	517.25
275.75	518.40
276.50	519.75
277.25	520.40
278.00	521.25
278.75	522.40
279.50	523.82
280.25	524.48
281.00	525.25
281.75	526.10
282.50	527.25
283.25	528.40
284.00	529.75
284.75	530.40
285.50	531.25
286.25	532.40
287.00	533.82
287.75	534.48
288.50	535.25
289.25	536.10
290.00	537.25
290.75	538.40
291.50	539.75
292.25	540.40
293.00	541.25
293.75	542.40
294.50	543.82
295.25	544.48
296.00	545.25
296.75	546.10
297.50	547.25
298.25	548.40
299.00	549.75
299.75	550.40
300.50	551.25
301.25	552.40
302.00	553.82
302.75	554.48
303.50	555.25
304.25	556.10
305.00	557.25
305.75	558.40
306.50	559.75
307.25	560.40
308.00	561.25
308.75	562.40
309.50	563.82
310.25	564.48
311.00	565.25
311.75	566.10
312.50	567.25
313.25	568.40
314.00	569.75
314.75	570.40
315.50	571.25
316.25	572.40
317.00	573.82
317.75	574.48
318.50	575.25
319.25	576.10
320.00	577.25
320.75	578.40
321.50	579.75
322.25	580.40
323.00	581.25
323.75	582.40
324.50	583.82
325.25	584.48
326.00	585.25
326.75	586.10
327.50	587.25
328.25	588.40
329.00	589.75
329.75	590.40
330.50	591.25
331.25	592.40
332.00	593.82
332.75	594.48
333.50	595.25
334.25	596.10
335.00	597.25
335.75	598.40
336.50	599.75
337.25	600.40
338.00	601.25
338.75	602.40
339.50	603.82
340.25	604.48
341.00	605.25
341.75	606.10
342.50	607.25
343.25	608.40
344.00	609.75
344.75	610.40
345.50	611.25
346.25	612.40
347.00	613.82
347.75	614.48
348.50	615.25
349.25	616.10
350.00	617.25
350.75	618.40
351.50	619.75
352.25	620.40
353.00	621.25
353.75	622.40
354.50	623.82
355.25	624.48
356.00	625.25
356.75	626.10
357.50	627.25
358.25	628.40
359.00	629.75
359.75	630.40
360.50	631.25
361.25	632.40
362.00	633.82
362.75	634.48
363.50	635.25
364.25	636.10
365.00	637.25
365.75	638.40
366.50	639.75
367.25	640.40
368.00	641.25
368.75	642.40
369.50	643.82
370.25	644.48
371.00	645.25
371.75	646.10
372.50	647.25
373.25	648.40
374.00	649.75
374.75	650.40
375.50	651.25
376.25	652.40
377.00	653.82
377.75	654.48
378.50	655.25
379.25	656.10
380.00	657.25
380.75	658.40
381.50	659.75
382.25	660.40
383.00	661.25
383.75	662.40
384.50	663.82
385.25	664.48
386.00	665.25
386.75	666.10
387.50	667.25
388.25	668.40
389.00	669.75
389.75	670.40
390.50	671.25
391.25	672.40
392.00	673.82
392.75	674.48
393.50	675.25
394.25	676.10
395.00	677.25
395.75	678.40
396.50	679.75
397.25	680.40
398.00	681.25
398.75	682.40
399.50	683.82
400.25	684.48
401.00	685.25
401.75	686.10
402.50	687.25
403.25	688.40
404.00	689.75
404.75	690.40
405.50	691.25
406.25	692.40
407.00	693.82
407.75	694.48
408.50	695.25
409.25	696.10
410.00	697.25
410.75	698.40
411.50	699.75
412.25	700.40
413.00	701.25
413.75	702.40
414.50	703.82
415.25	704.48
416.00	705.25
416.75	706.10
417.50	707.25
418.25	708.40
419.00	709.75
419.75	710.40
420.50	711.25
421.25	712.40
422.00	713.82
422.75	714.48
423.50	715.25
424.25	716.10
425.00	717.25
425.75	718.40
426.50	719.75
427.25	720.40
428.00	721.25
428.75	722.40
429.50	723.82
430.25	724.48
431.00	725.25
431.75	726.10
432.50	727.25
433.25	728.40
434.00	729.75
434.75	730.40
435.50	731.25
436.25	732.40
437.00	733.82
437.75	734.48
438.50	735.25
439.25	736.10
440.00	737.25
440.75	738.40
441.50	739.75
442.25	740.40
443.00	741.25
443.75	742.40
444.50	743.82
445.25	744.48
446.00	745.25
446.75	746.10
447.50	747.25
448.25	748.40
449.00	749.75
449.75	750.40
450.50	751.25
451.25	752.40
452.00	753.82
452.75	754.48
453.50	755.25
454.25	756.10
455.00	757.25
455.75	758.40
456.50	759.75
457.25	760.40
458.00	761.25
458.75	762.40
459.50	763.82
460.25	764.48
461.00	765.25
461.75	766.10
462.50	767.25
463.25	768.40
464.00	769.75
464.75	770.40
465.50	771.25
466.25	772.40
467.00	773.82
467.75	774.48
468.50	775.25
469.25	776.10
470.00	777.25
470.75	778.40
471.50	779.75
472.25	780.40
473.00	781.25
473.75	782.40
474.50	783.82
475.25	784.48
476.00	785.25
476.75	786.10
477.50	787.25
478.25	788.40
479.00	789.75
479.75	790.40
480.50	791.25
481.25	792.40
482.00	793.82
482.75	794.48
483.50	795.25
484.25	796.10
485.00	797.25
485.75	798.40
486.50	799.75
487.25	800.40
488.00	801.25
488.75	802.40
489.50	803.82
490.25	804.48
491.00	805.25
491.75	806.10
492.50	807.25
493.25	808.40
494.00	809.75
494.75	810.40
495.50	811.25
496.25	812.40
497.00	813.82
497.75	814.48
498.50	815.25
499.25	816.10
500.00	817.25
500.75	818.40
501.50	819.75
502.25	820.40
503.00	821.25
503.75	822.40
504.50	823.82
505.25	824.48
506.00	825.25
506.75	826.10
507.50	827.25
508.25	828.40
509.00	829.75
509.75	830.40
510.50	831.25
511.25	832.40
512.00	833.82
512.75	834.48
513.50	835.25
514.25	836.10
515.00	837.25
515.75	838.40
516.50	839.75
517.25	840.40
518.00	841.25
518.75	842.40
519.50	843.82
520.25	844.48
521.00	845.25
521.75	846.10
522.50	847.25
523.25	848.40
524.00	849.75
524.75	850.40
525.50	851.25
526.25	852.40
527.00	853.82
527.75	854.48
528.50	855.25
529.25	856.10
530.00	857.25
530.75	858.40
531.50	859.75
532.25	860.40
533.00	861.25
533.75	862.40
534.50	863.82
535.25	864.48
536.00	865.25
536.75	866.10
537.50	867.25
538.25	868.40
539.00	869.75
539.75	870.40
540.50	871.25
541.25	872.40
542.00	873.82
542.75	874.48
543.50	875.25
544.25	876.10
545.00	877.25
545.75	878.40
546.50	879.75
547.25	880.40
548.00	881.25
548.75	882.40
549.50	883.82
550.25	884.48
551.00	885.25
551.75	886.10
552.50	887.25
553.25	888.40
554.00	889.75
554.75	890.40
555.50	891.25
556.25	892.40
557.00	893.82
557.75	894.48
558.50	895.25
559.25	896.10
560.00	897.25
560.75	898.40
561.50	899.75
562.25	900.40
563.00	901.25
563.75	902.40
564.50	903.82
565.25	904.48
566.00	905.25
566.75	906.10
567.50	907.25
568.25	908.40
569.00	909.75
569.75	910.40
570.50	911.25
571.25	912.40
572.00	913.82
572.75	914.48
573.50	915.25
574.25	916.10
575.00	917.25
575.75	918.40
576.50	919.75
577.25	920.40
578.00	921.25
578.75	922.40
579.50	923.82
580.25	924.48
581.00	925.25
581.75	926.10
582.50	927.25