


STRUMENT	DATE	GRANTOR	GRANTEE	BOOK	PAGE	RECORDED DATE	REMARKS
112	12-7-16	A.G. DEWEY CO.	ST. OF VT.	203	10-14-16		

90.36100 STA 174+23  
NOT INCLUDED IN  
V.R. 100-C (LANDSCAPING-E)

REV CURVE  
Δ 19°-58'17"  
D 25'  
R 1910.1  
T 336.2  
L 665.6  
E 294

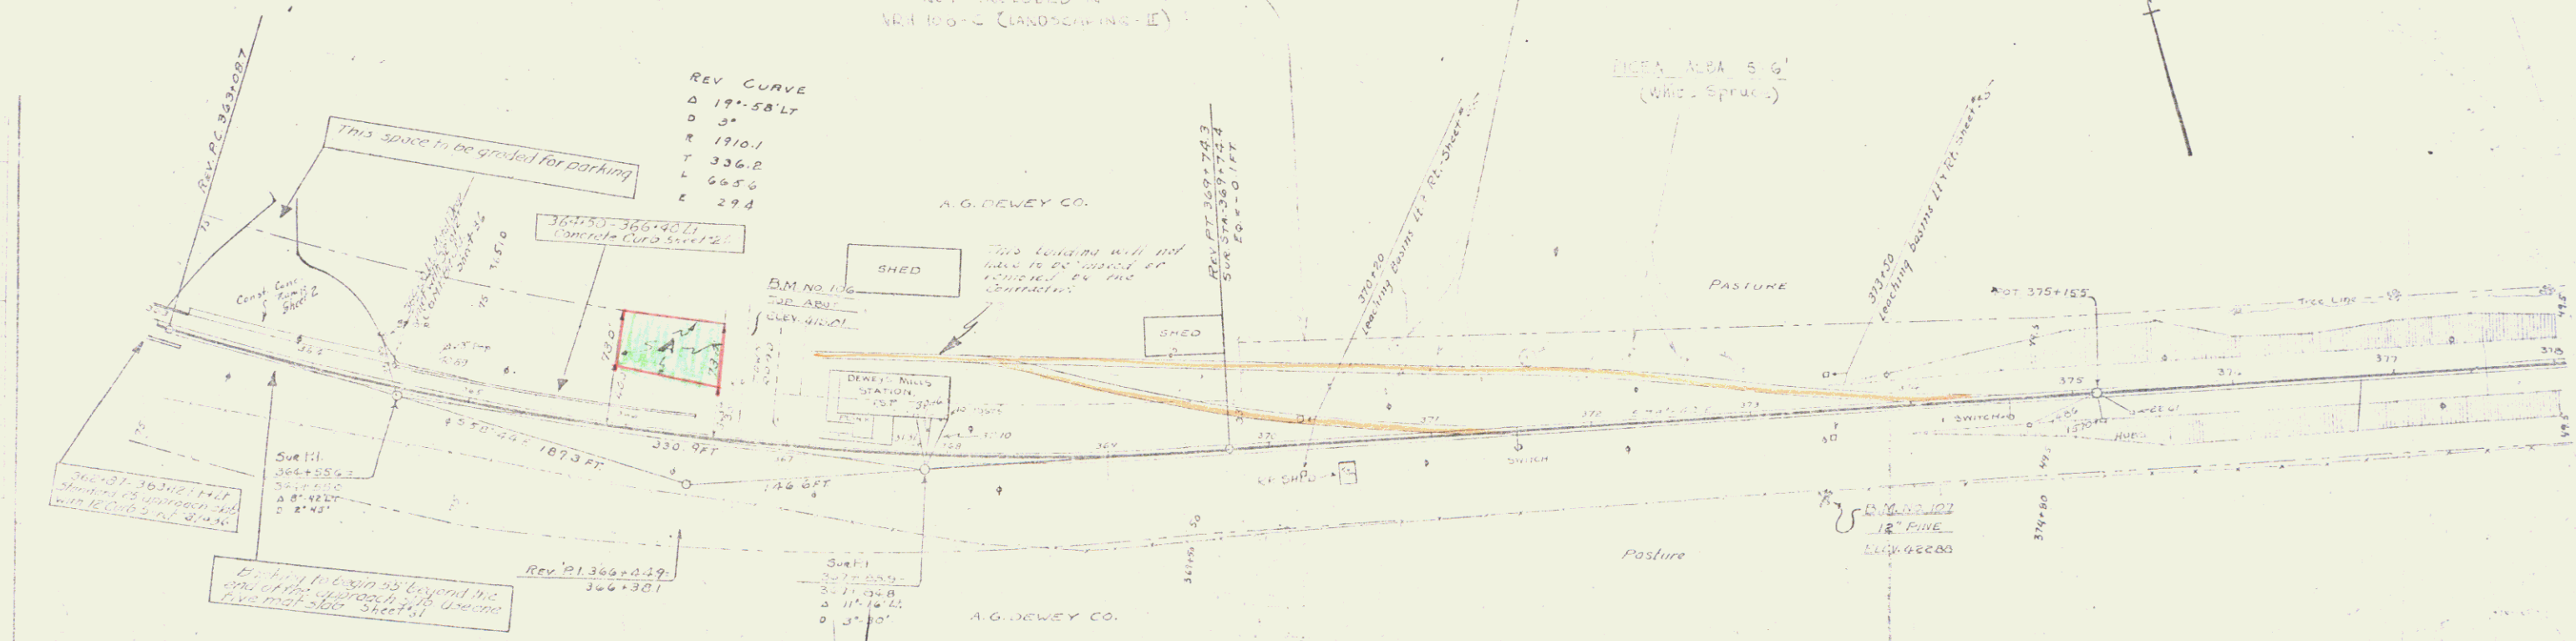

BM 106 - Top corner of shed, south of the Dewey's Elev. 501  
BM 107 - Corner of frame, west of the 375+00 Elev. 422.88