


Parcel	Kind of	Date of	Cracker	Grantee	Received	Remarks
A	W.D.	6 13 33	G.H. Piper et al	St. J. H.		Dist. 1931 Date 76 43 A 4 R 33

108 C 1933

(LAND SURVEY)

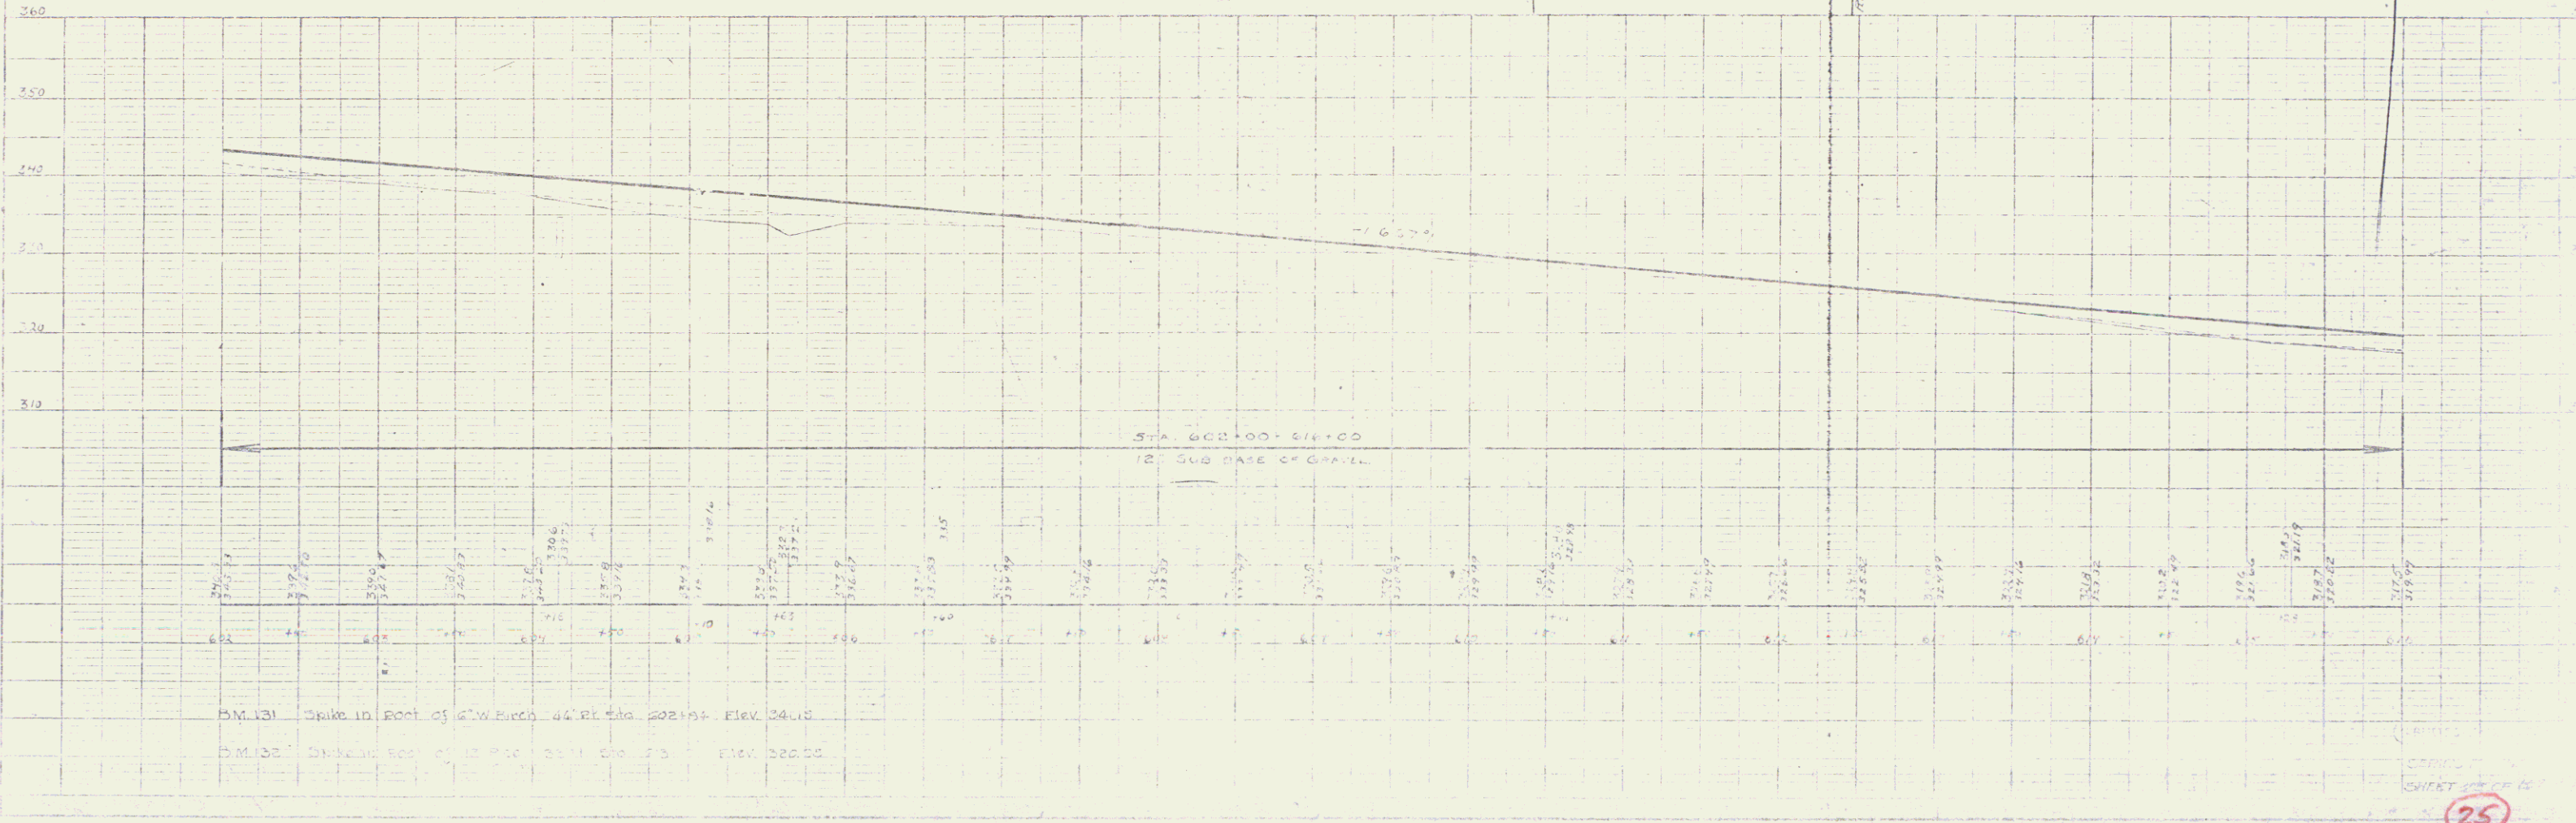

25

24