



Parcel and of Date of Grantee George Received Remains
 Instrument Instrument
 ASB W.C. 4133 Galt's of 1st-11-44 4654 1/13

148 C 1323 05 26
 (L.H. S. 1911)

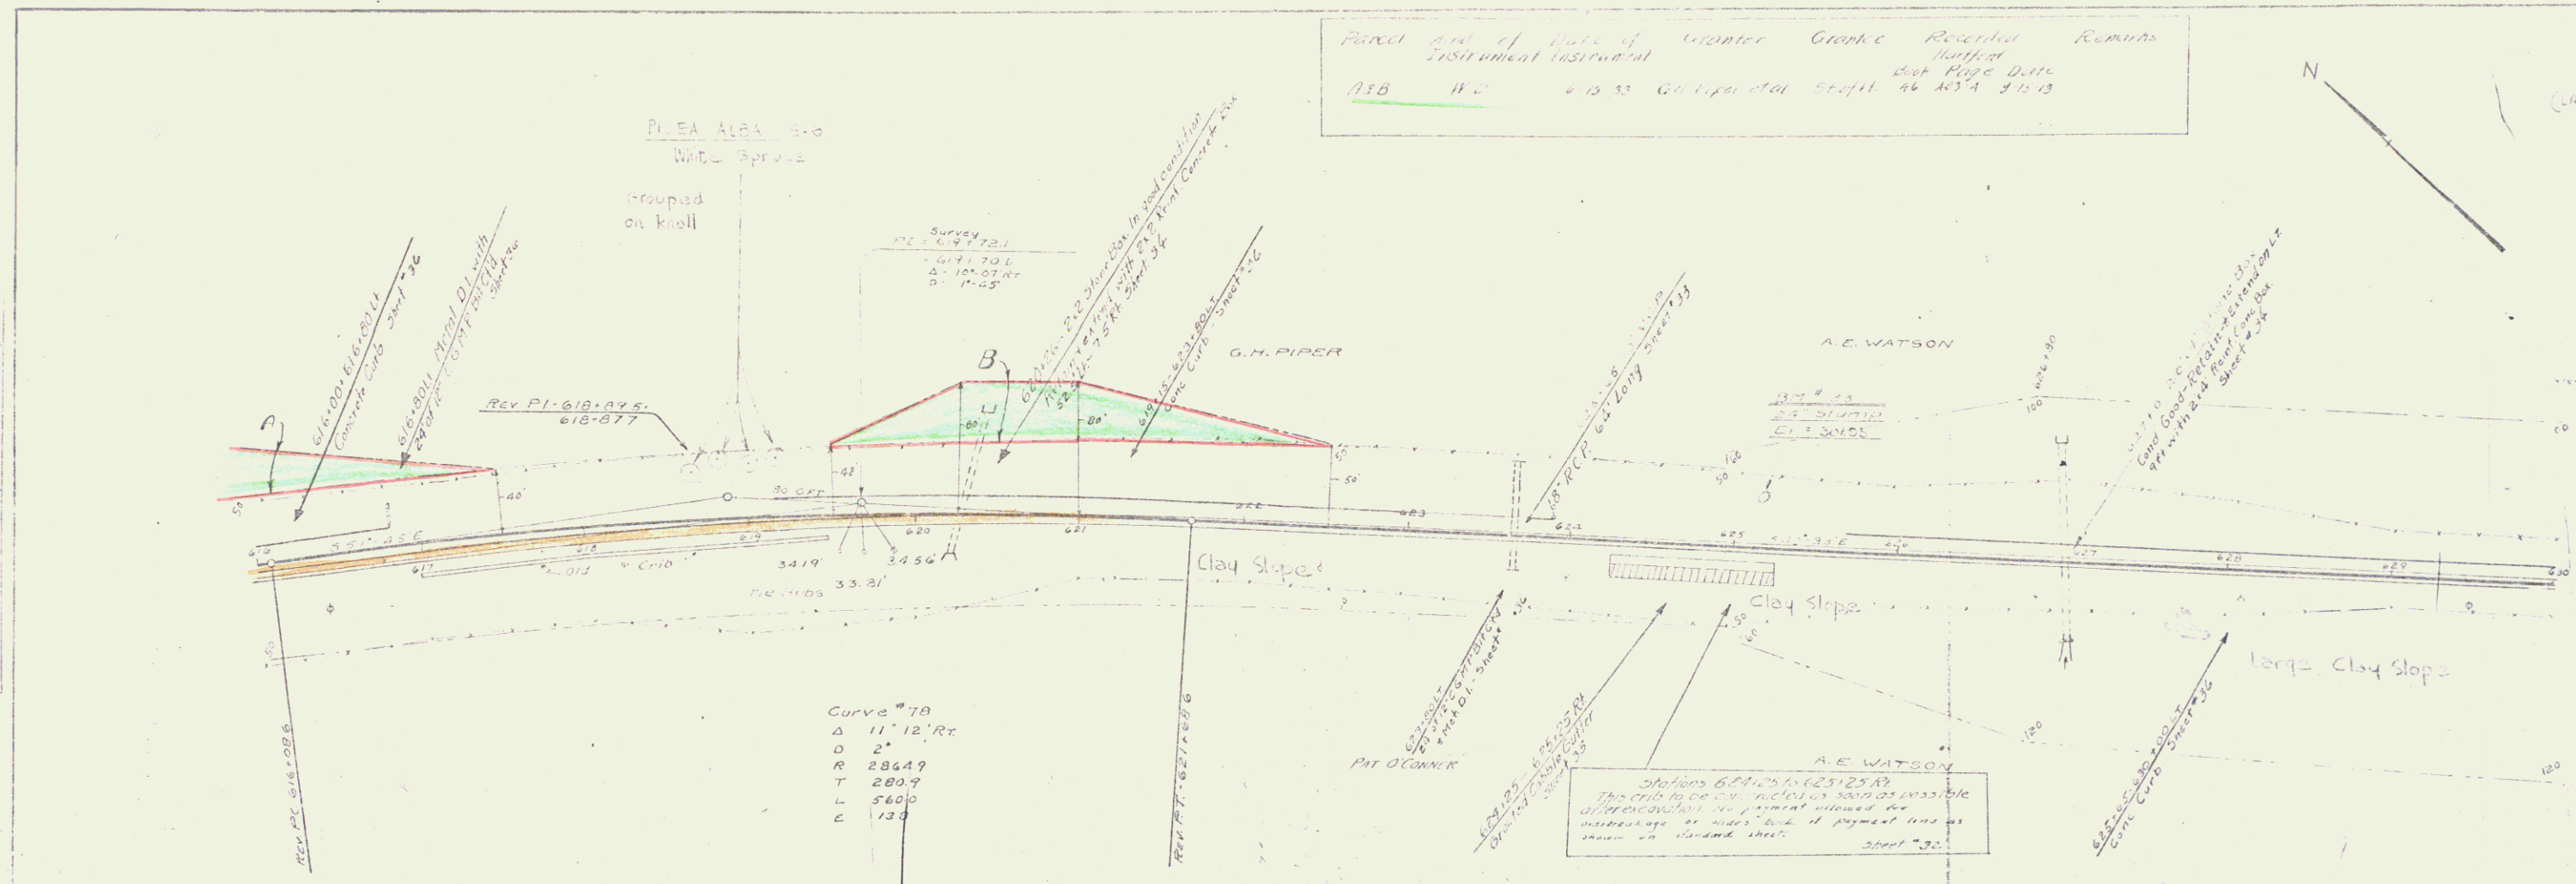

Curve 70
 Δ 11° 12' Rt
 D 27
 R 28649
 T 2809
 L 3600
 E 130

Stations 624+00 to 625+25.00
 This curve to be on 12" sub-base of gravel
 at 1% slope. The present shown on
 this drawing is under the 1% slope as
 shown on standard sheet.
 Sheet 25

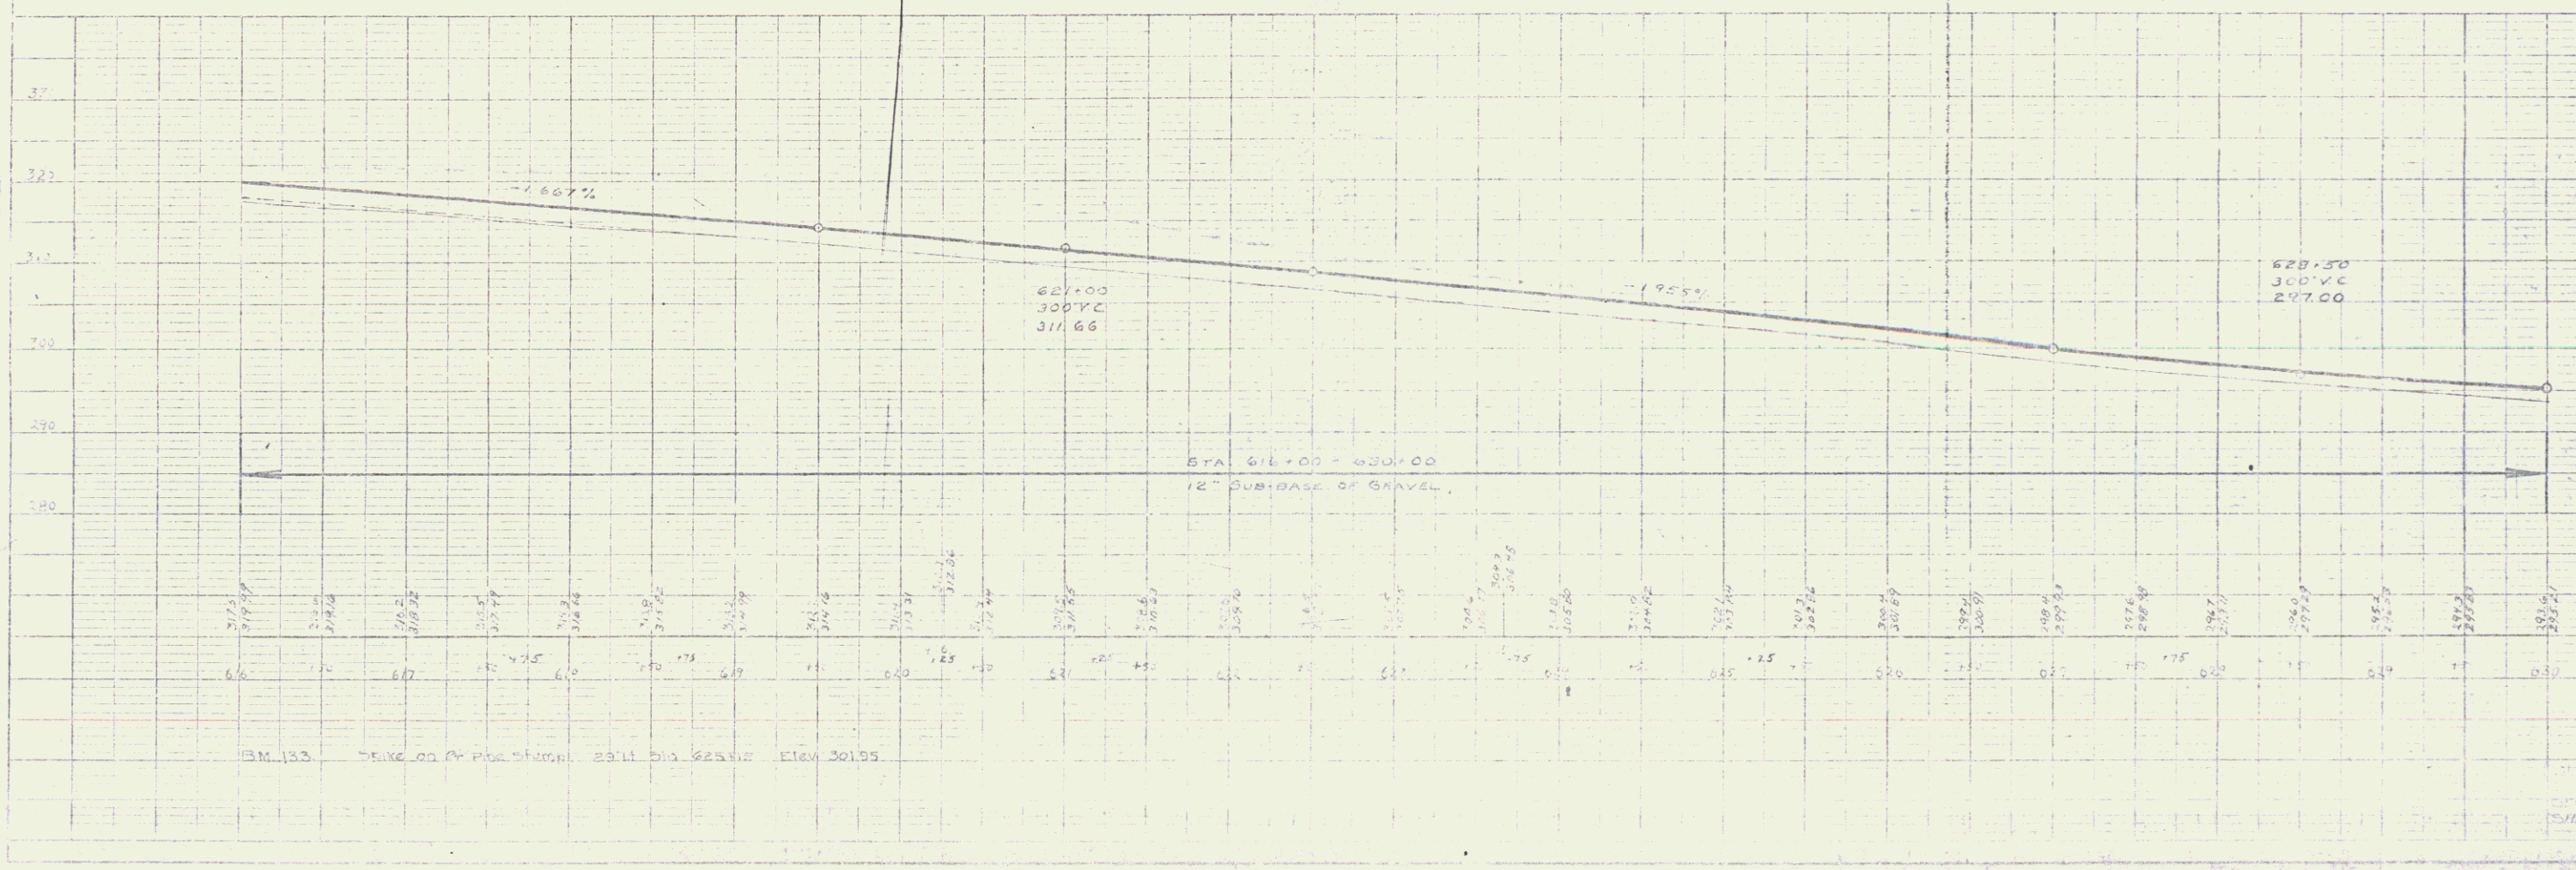

26

25