


Book	No. of Instrument	Date of Instrument	Grantor	Grantee	Recorded	Remarks
A	W.D.	7-6-25	RICHARD NEED	STAFF	46	12/13 P.M. 33
D	W.D.	9-21-43	RICHARD NEED	STAFF	50	3/1 10-23-43

100-C 1005 15  
18 34  
(LANDSCAPING II)

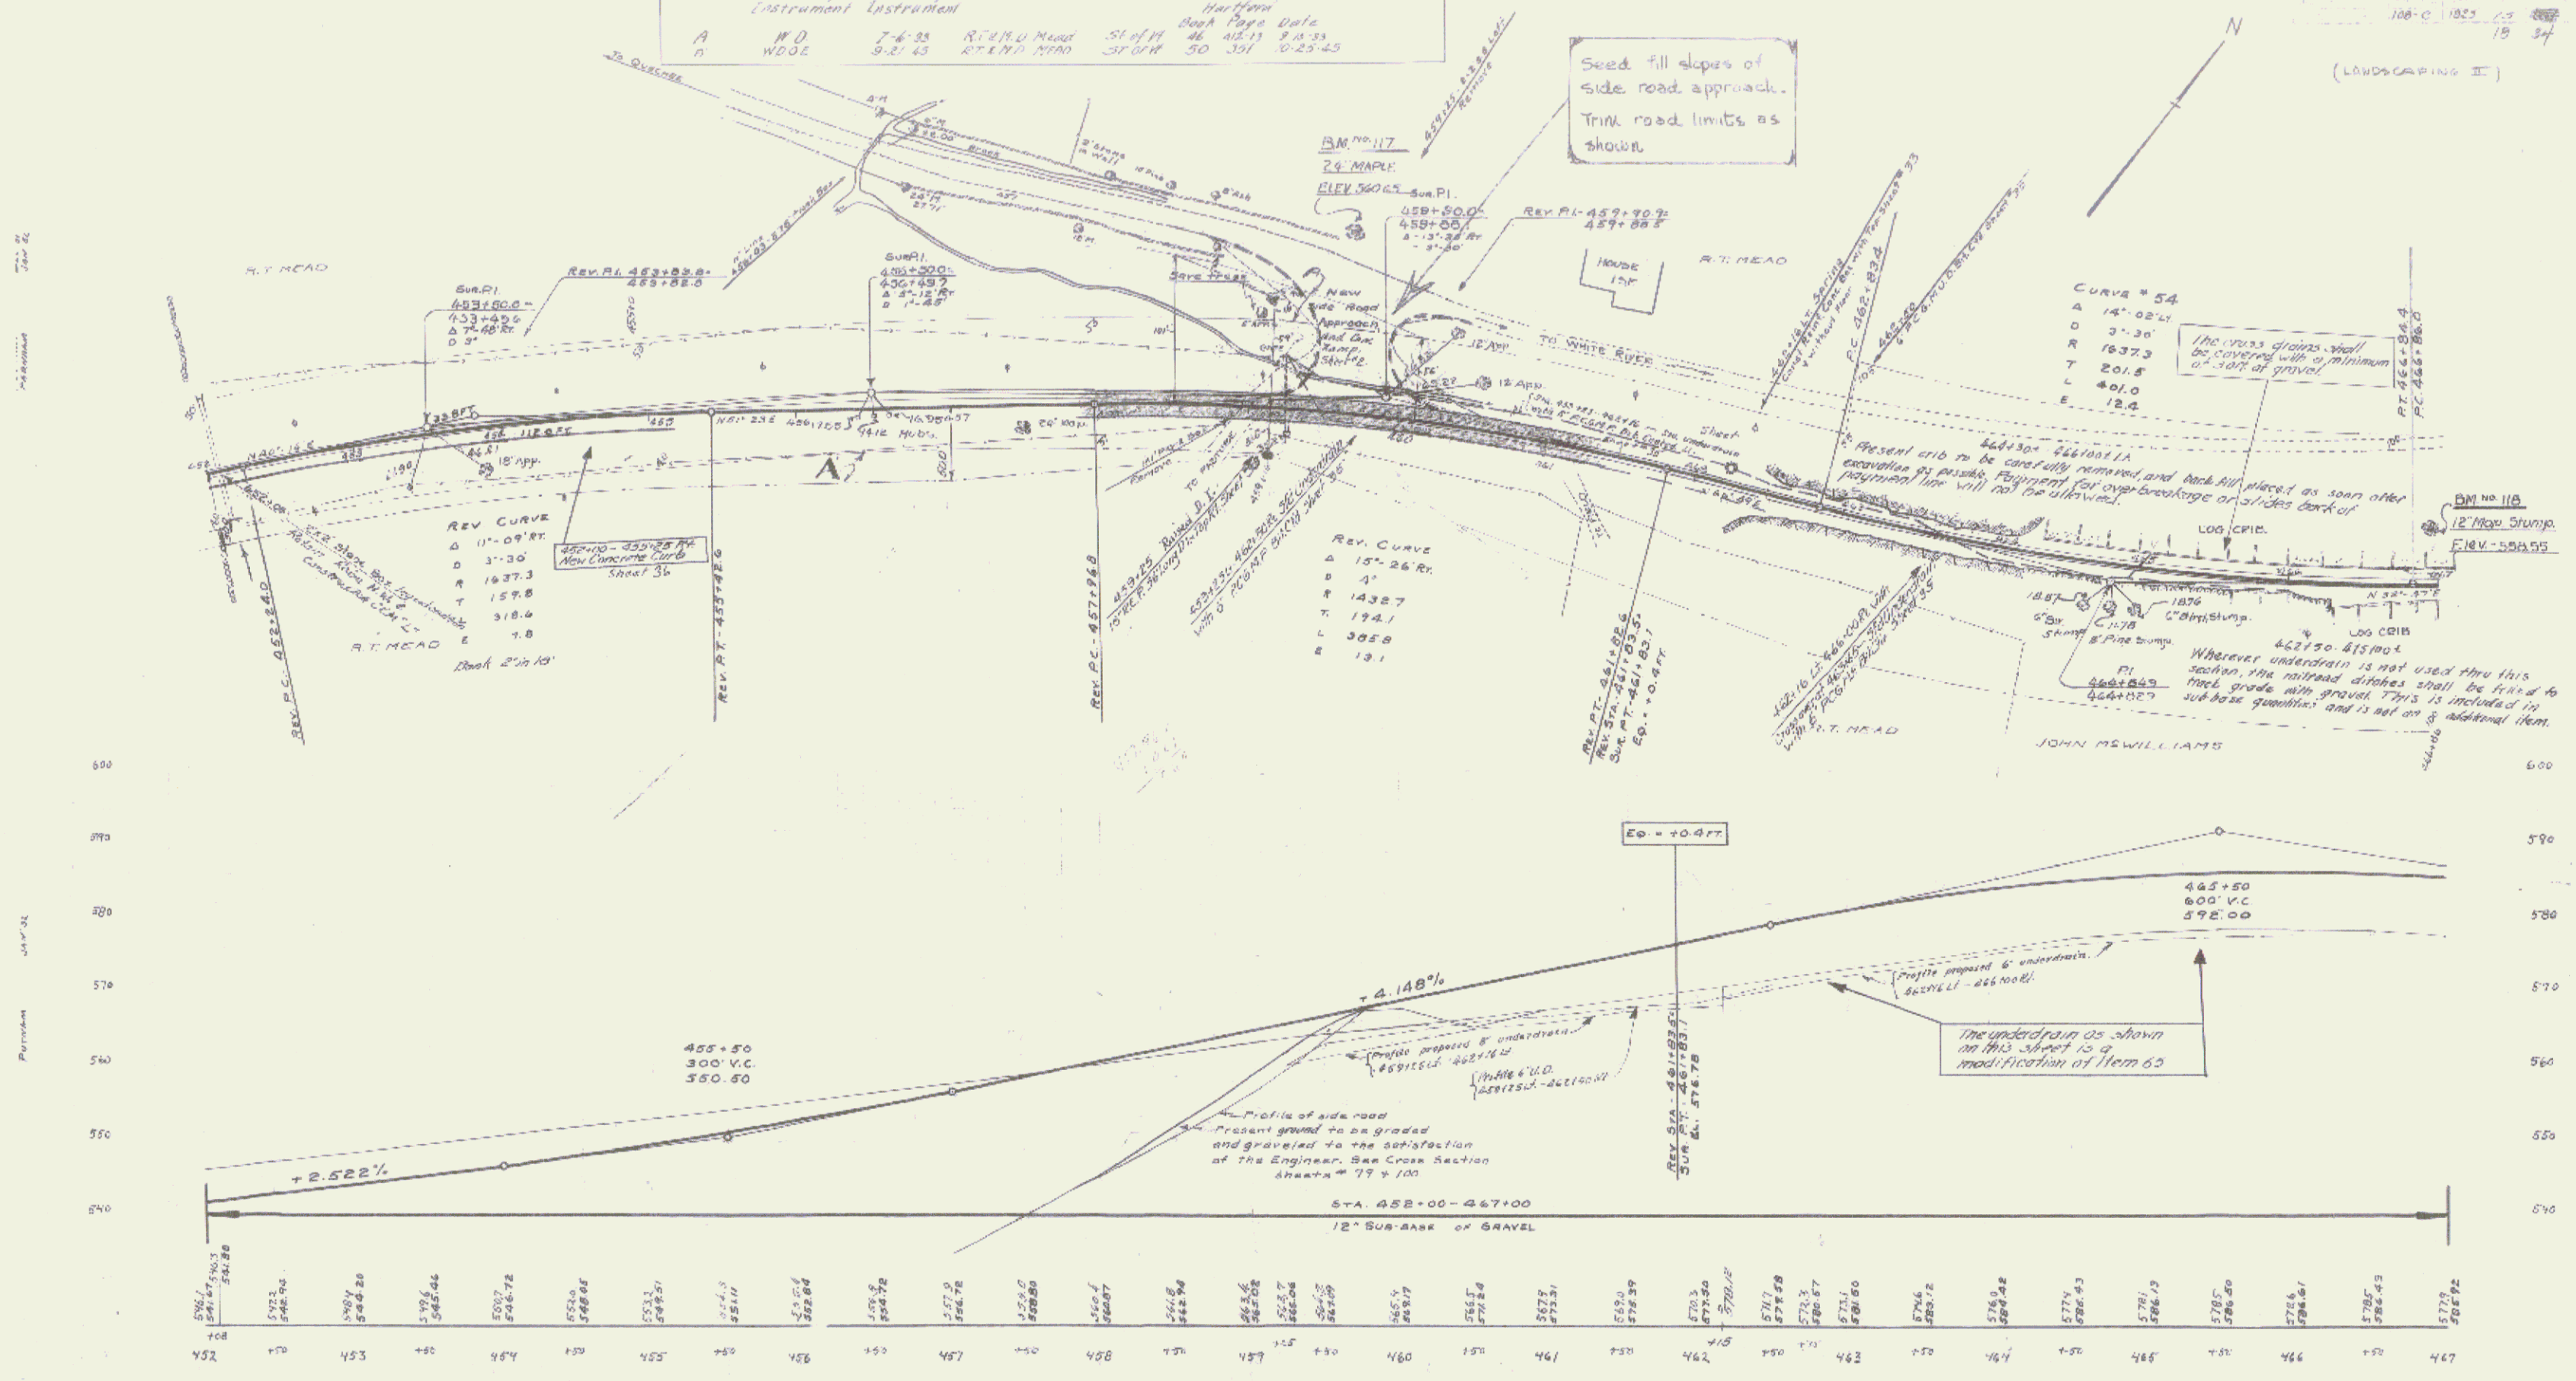

B.M. 117 Spike to Root of 24" Maple 120' Lt. Sta 455+09 Elev. 560.65  
 B.M. 118 Spike on 12" Maple Stump 33' Lt. Sta 447+13 Elev. 560.55

(LANDSCAPING II)  
 SERIES F No 100-C  
 SHEET 18 OF 34

SD