
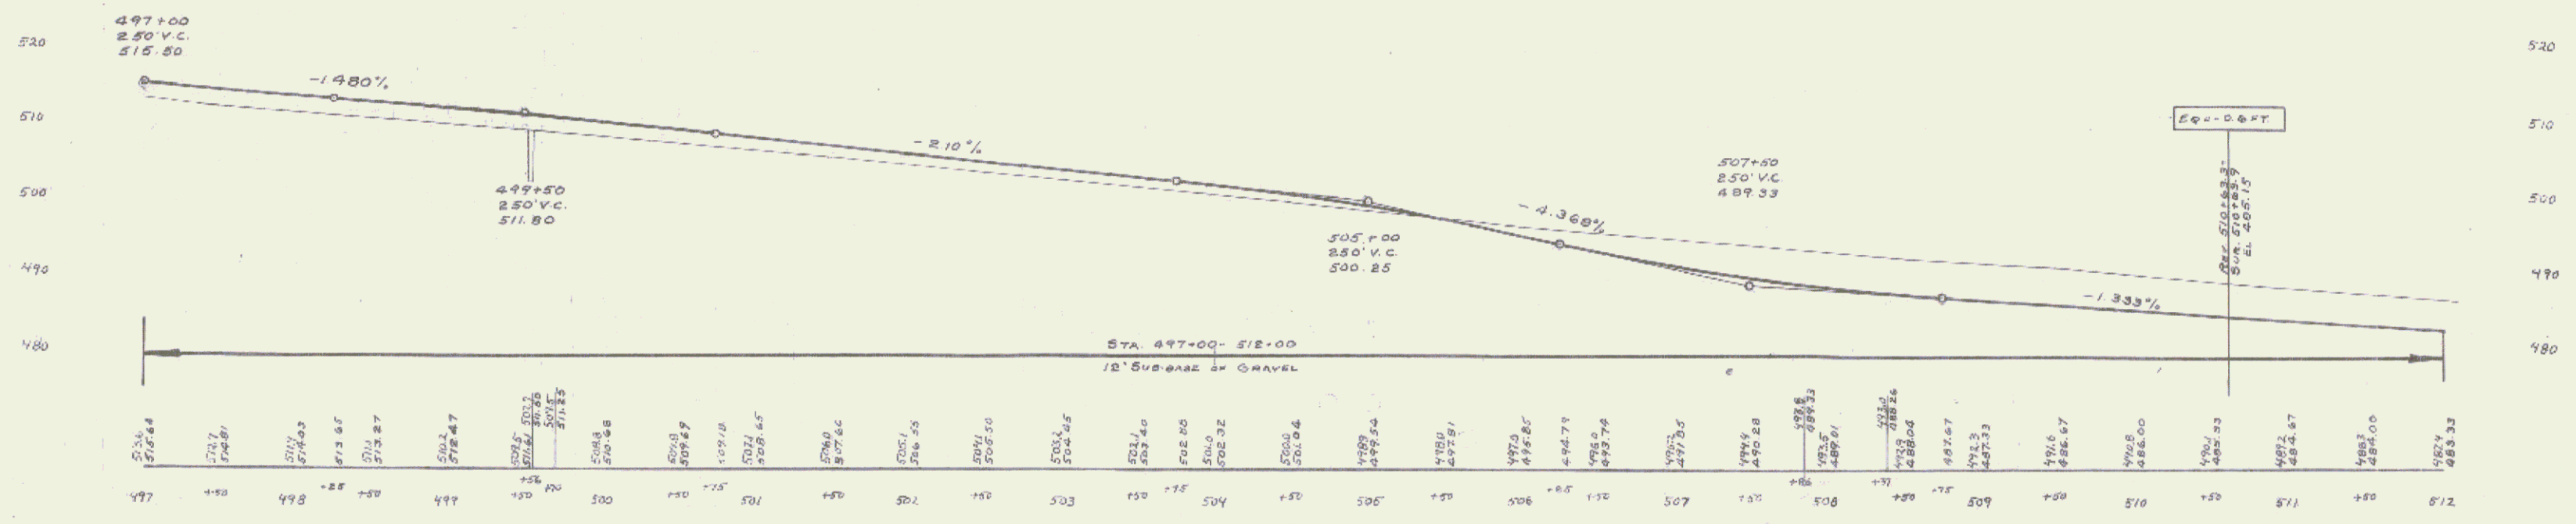


Partial List of Date of Greater Oracles Recorded Remarks  
 Instrument  
 A N.D. 6-13-33 M.C. & J. Hubert Staff AL also 3-13-33

100-C-1033  
 21 3/4

(LANDSCAPING II)

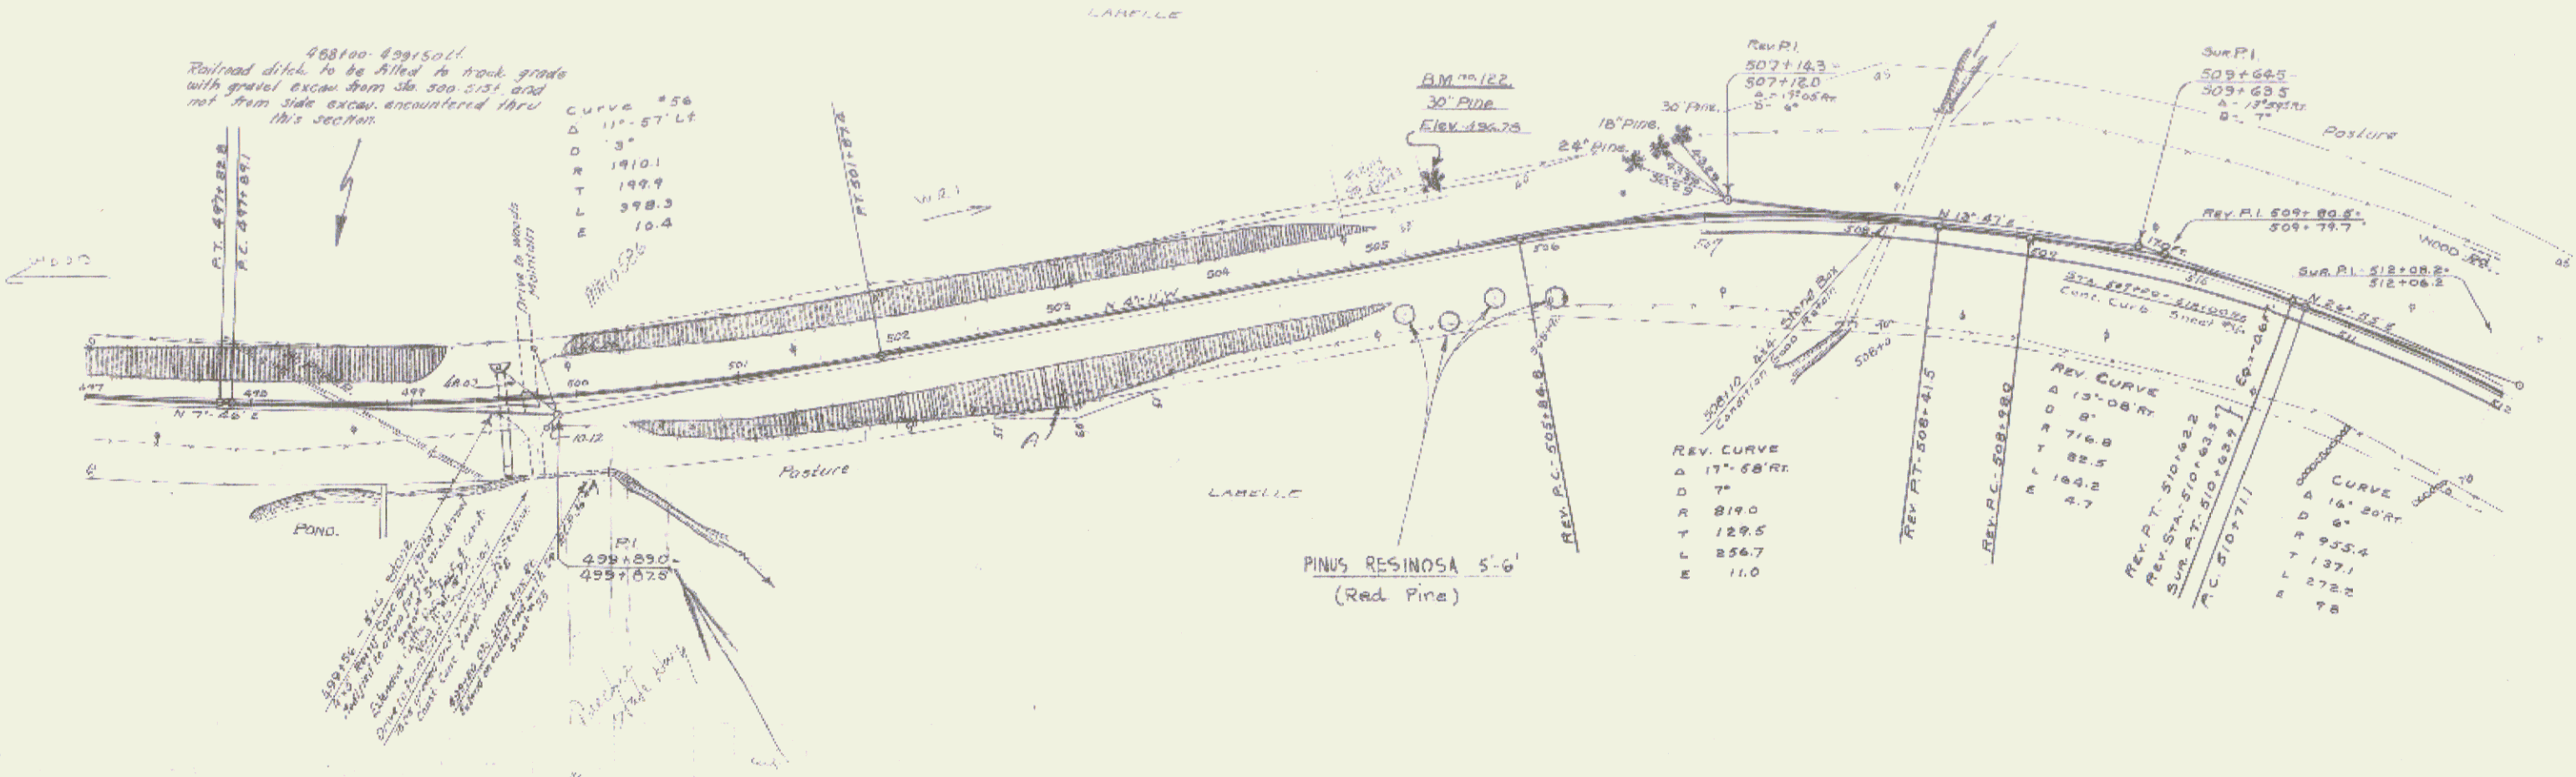

BM. 122 Spike in root 30' Pine 37' ft. Sta. 505+45 Elev. 496.78

(LANDSCAPING II)  
 SERIES F No 100-C  
 SHEET 21 OF 34