


Parcel	Kind of Instrument	Date of Instrument	Grantor	Grantee	Received Hereof	Remarks
B	W.D.	6-15-33	W.C. RENNAN	Label Staff	Book Page Data	46-15-33
A 38	W.D.	6-21-33	W.C. RENNAN	Label Staff	Book Page Data	46-15-33

QUANTITIES AS COMPUTED SHOW THAT BETWEEN 463+50 & 514+50 EXCAVATION AND FULL BALANCE THE QUANTITIES PLUM FOR 300 cu. YD. EXCAVATION FOR CHECKING AT 466+00, AND 2364 cu. YD. EXCAVATION AT 460+00 APPROXIMATE AT 519+00+00

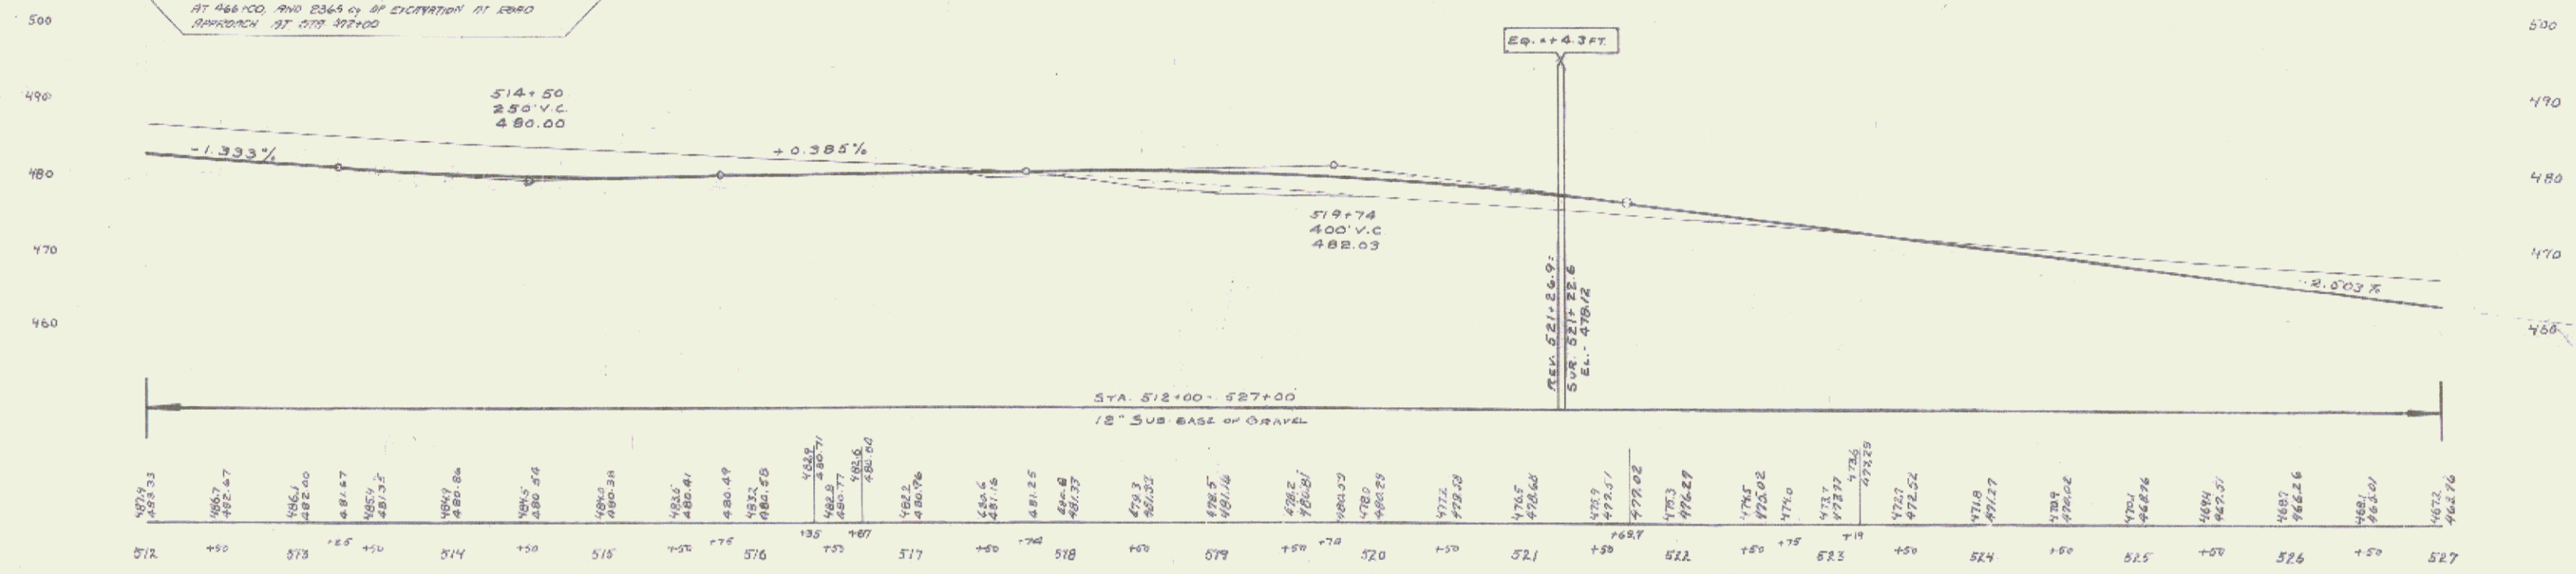

B.M. 123 Skins in roof 12" Pipe 35' RT Sta 515+43 Elev 457.57